C.S.A.H. NO. 1 (PROCTOR AVENUE)

NOTE:
TRAFFIC SIGNAL LOOP DETECTORS SHALL BE LOCATED PRIOR TO CONSTRUCTION AND REINSTALLED IN NEW BITUMINOUS AS DIRECTED BY THE ENGINEER AND MnDOT.

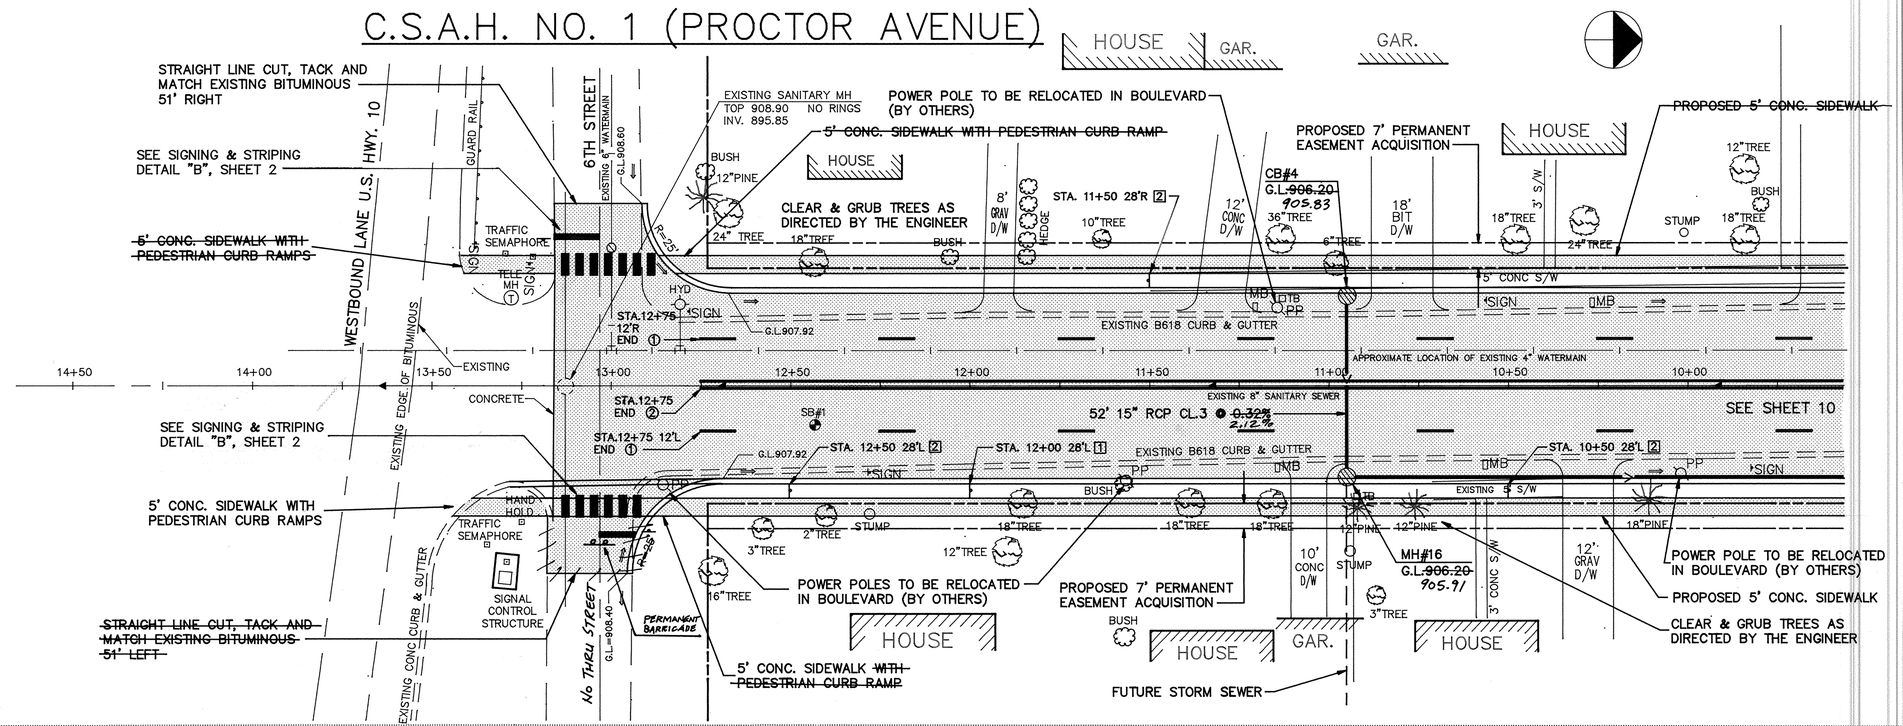

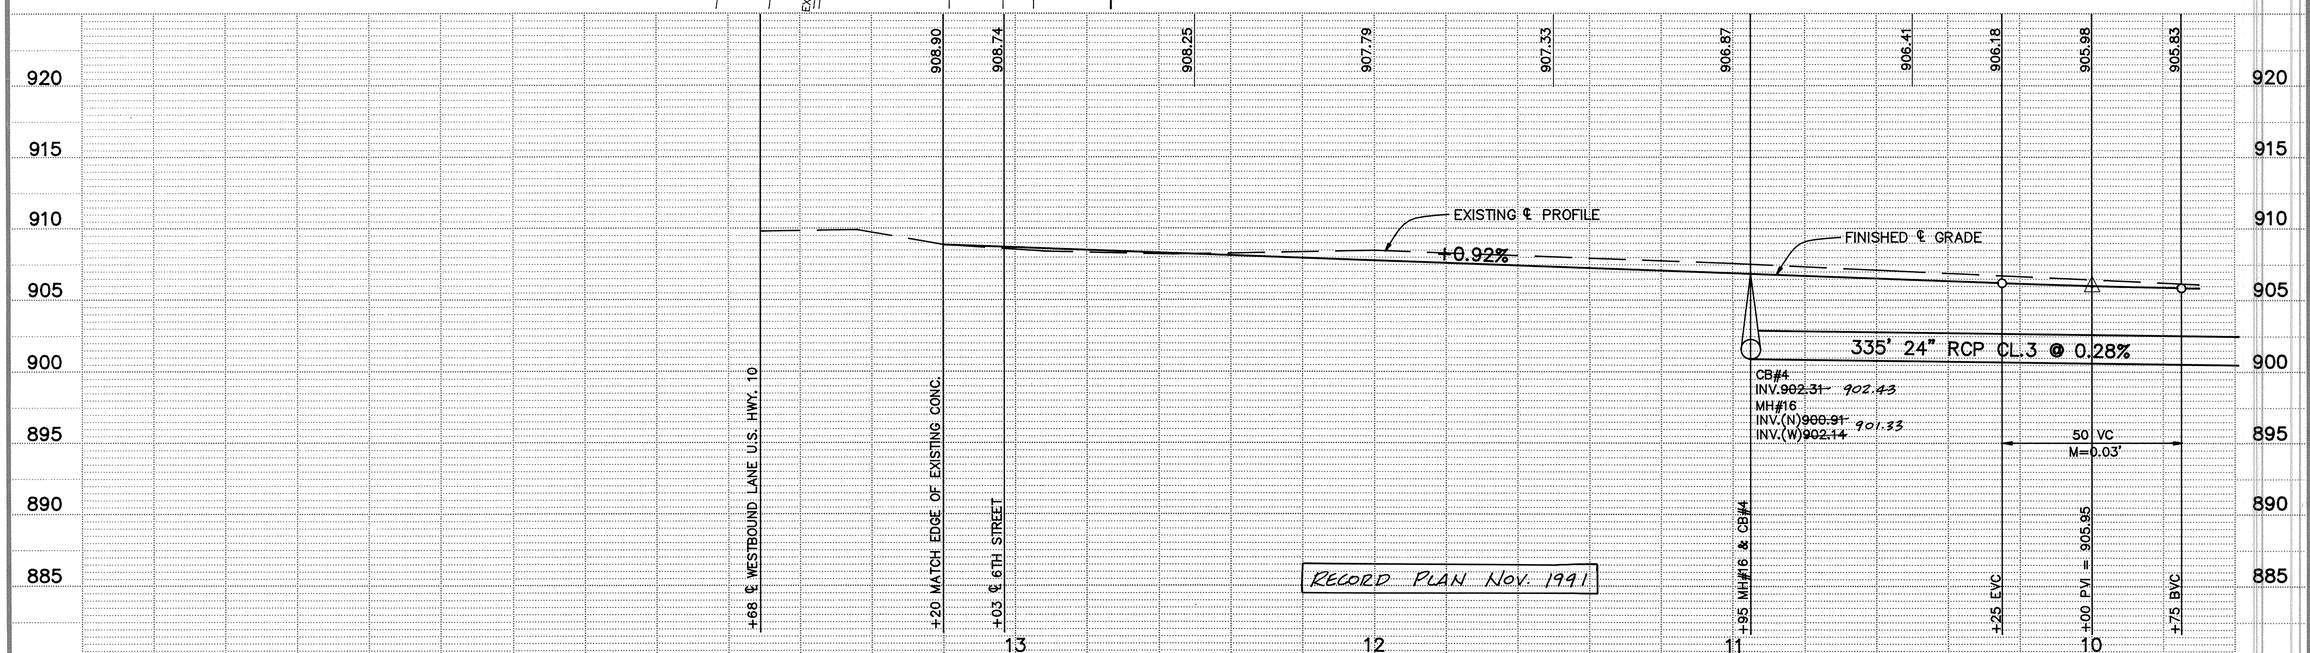

RECORD PLAN Nov. 1991

I HEREBY CERTIFY THAT THIS PLAN, SPECIFICATION, OR REPORT WAS PREPARED BY ME OR UNDER MY DIRECT SUPERVISION AND THAT I AM A DULY REGISTERED PROFESSIONAL ENGINEER UNDER THE LAWS OF THE STATE OF MINNESOTA.

Terry J. Maurer
DATE 3/5/91 REG. NO. 15316

MSA
CONSULTING ENGINEERS
Maier Stewart & Associates Inc.
1959 SLOAN PLACE (612)774-6021 ST. PAUL, MINNESOTA 55117

REVISIONS	DATE	DESCRIPTION

DESIGNED VCH
CHECKED
DRAWN GG
GRAPHIC SCALE
HORIZ. 20
VERT. 5

SHERBURNE COUNTY
STREET IMPROVEMENTS
C.S.A.H. NO. 1 (PROCTOR AVENUE)
S.A.P. 71-601-13

DATE JAN. 1991 SHEET 11 OF 28 SHEETS PROJECT NO. 231-001

SC001-6

14

436

DRAWING NUMBER
SAFCO PRODUCTS • NEW HOPE, MINNESOTA
REORDER BY PART NUMBER 63252
POSITION SIGNS AT PARK LAKE LANE



DRAWING NUMBER
1CSAH 91
11
