


C.S.A.H. NO. 1 (PROCTOR AVENUE)

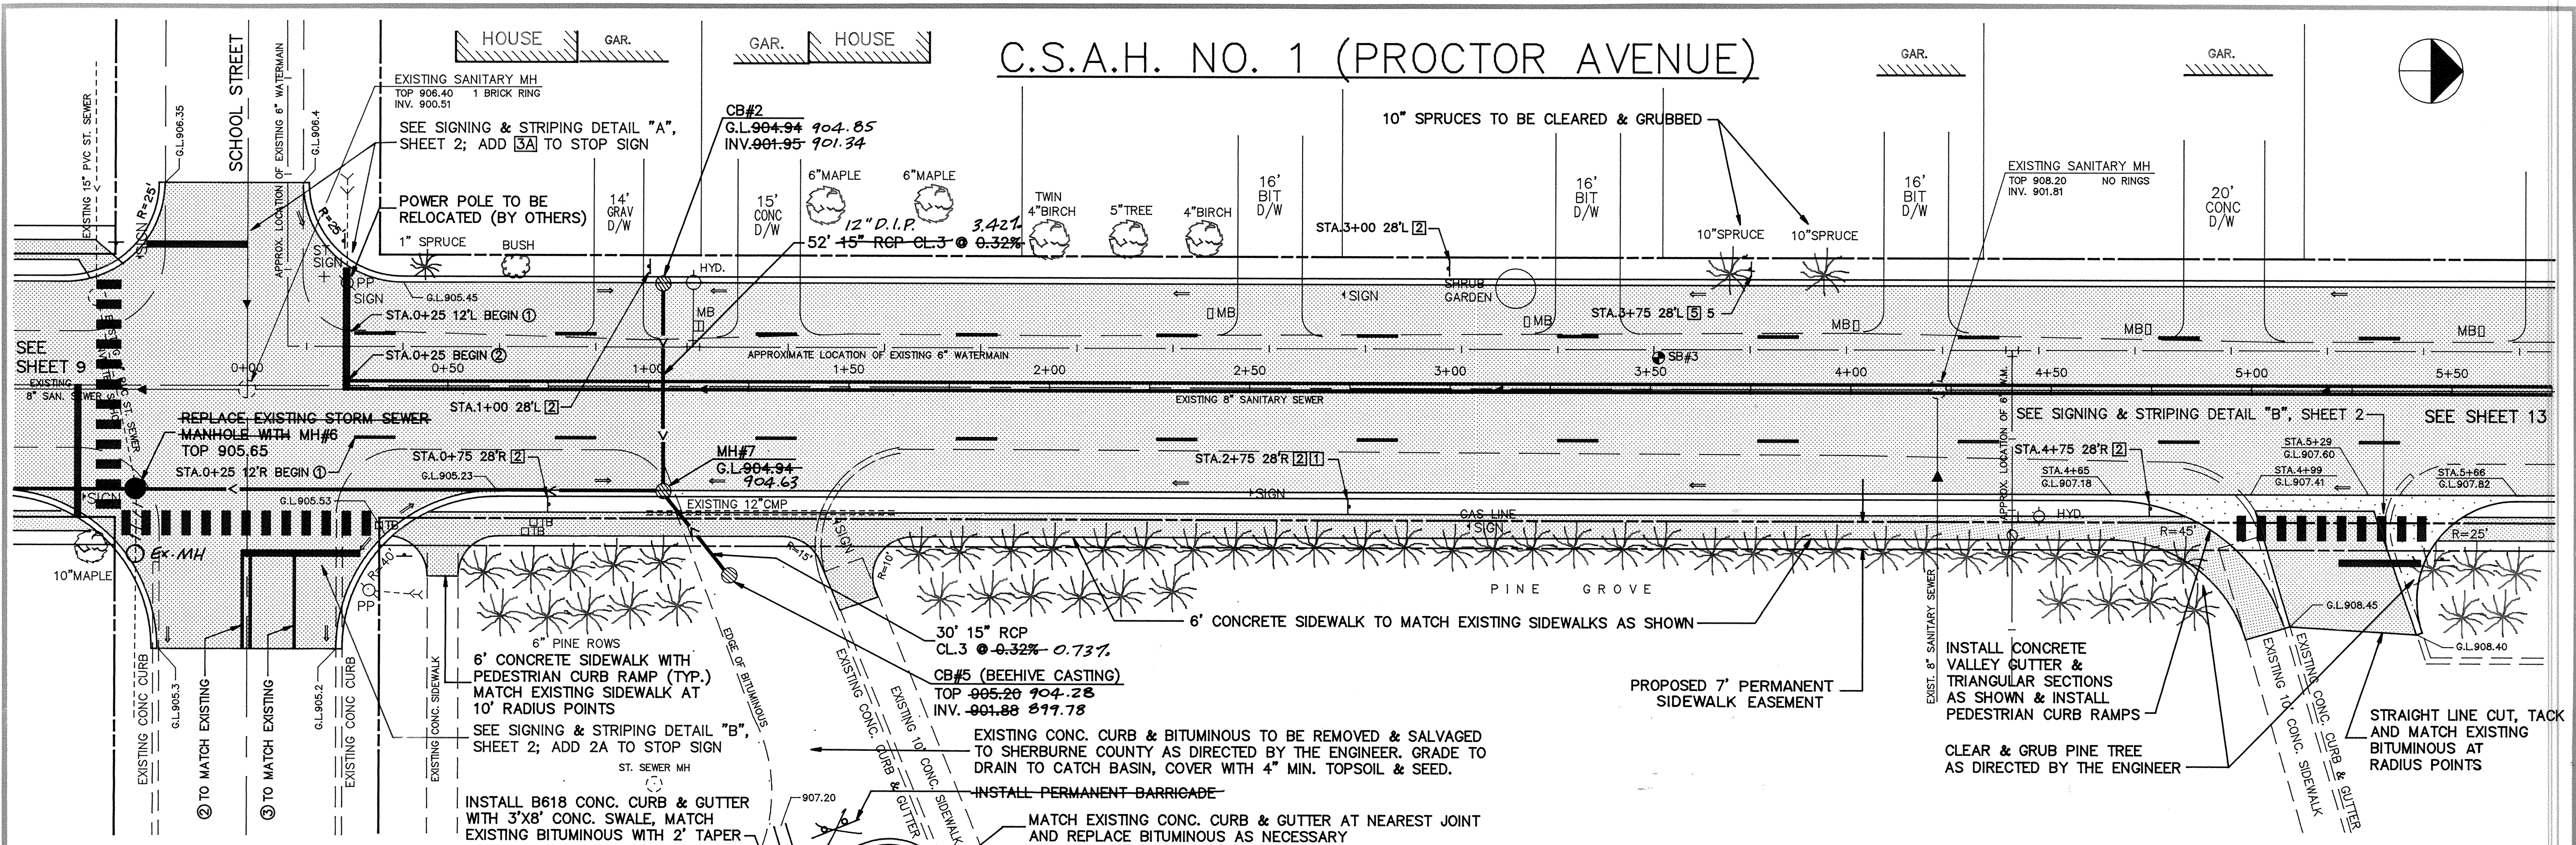

I HEREBY CERTIFY THAT THIS PLAN, SPECIFICATION, OR REPORT WAS PREPARED BY ME OR UNDER MY DIRECT SUPERVISION AND THAT I AM A DULY REGISTERED PROFESSIONAL ENGINEER UNDER THE LAWS OF THE STATE OF MINNESOTA.

Jerry J. Maier
 DATE 3/15/91 REG. NO. 15314

MSA CONSULTING ENGINEERS
Maier Stewart & Associates Inc.
 1959 SLOAN PLACE (612) 774-6021 ST. PAUL, MINNESOTA 55117

REVISIONS	DATE	DESCRIPTION	DESIGNED_VGH	CHECKED_jin	DRAWN_GG

GRAPHIC SCALE
 HORIZ. 20'
 VERT. 5'

SHERBURNE COUNTY
STREET IMPROVEMENTS
C.S.A.H. NO. 1 (PROCTOR AVENUE)
S.A.P. 71-601-13

DATE JAN. 1991 SHEET 12 OF 28 SHEETS PROJECT NO. 231-001