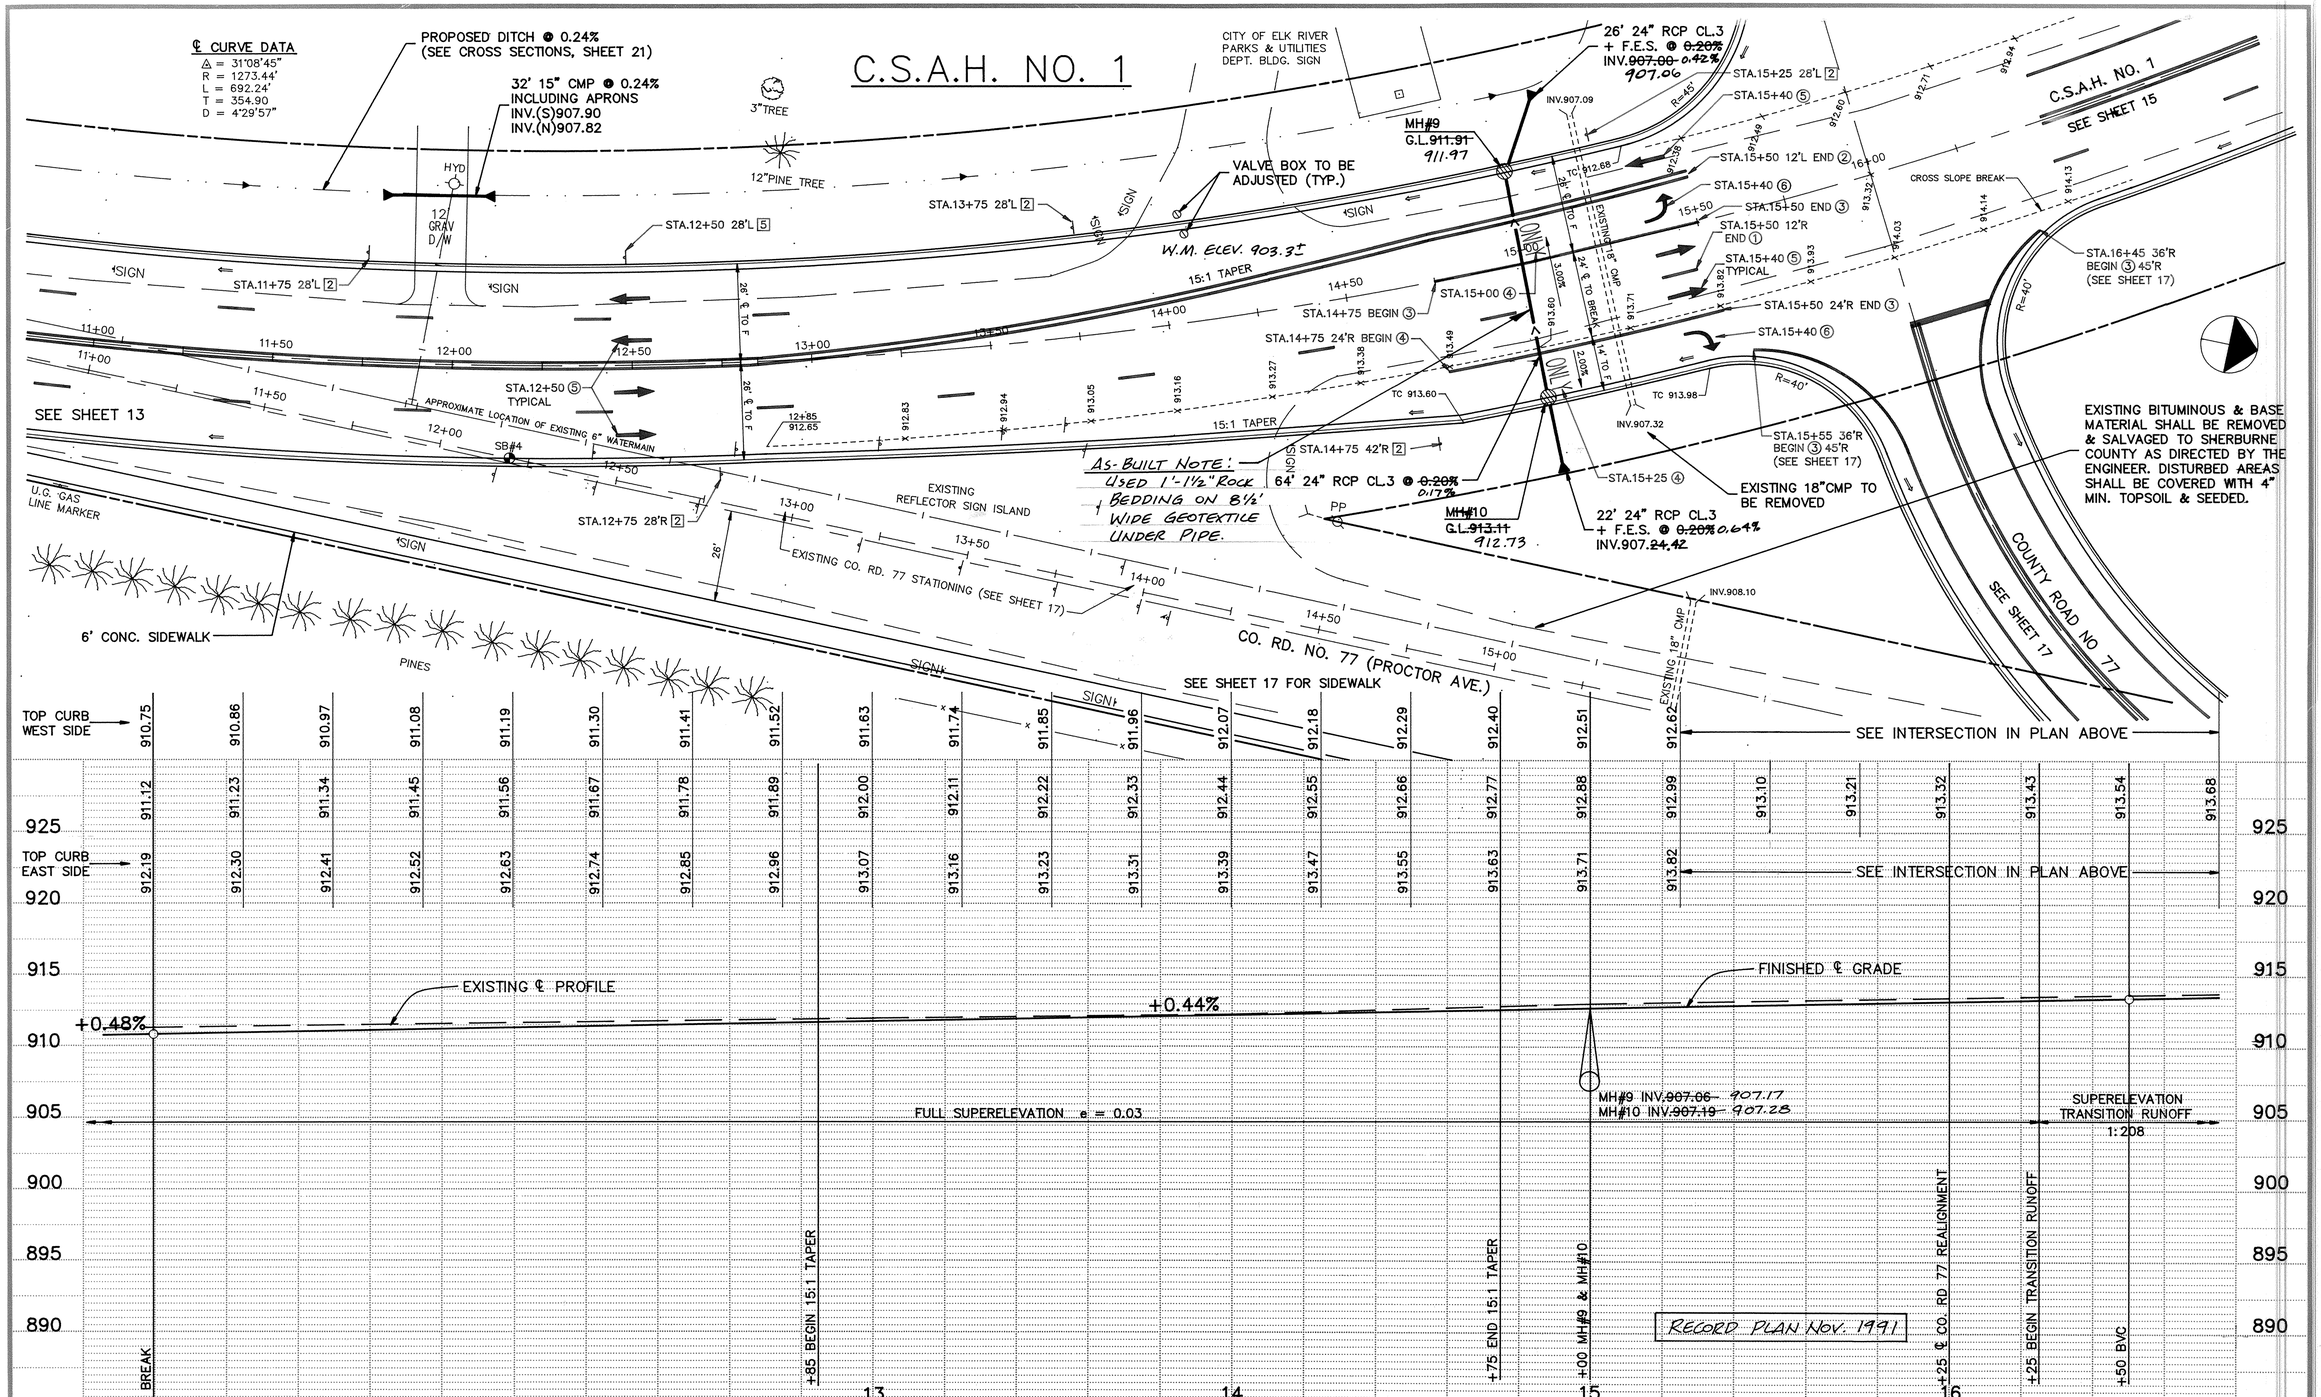


I HEREBY CERTIFY THAT THIS PLAN, SPECIFICATION, OR REPORT WAS PREPARED BY ME OR UNDER MY DIRECT SUPERVISION AND THAT I AM A DULY REGISTERED PROFESSIONAL ENGINEER UNDER THE LAWS OF THE STATE OF MINNESOTA.

Terry J. Maurer

DATE 6/4/91 REG. NO. 15316

MSA CONSULTING ENGINEERS
Maier Stewart & Associates Inc.
1959 SLOAN PLACE (612)774-6021 ST. PAUL, MINNESOTA 55117

| REVISIONS | DATE | DESCRIPTION |
|---|---|---|
| | 5/28/91 | CO. RD. 77 ALIGNMENT |

DESIGNED GG
CHECKED
DRAWN GG
GRAPHIC SCALE
HORIZ. 20
VERT. 5

SHERBURNE COUNTY
STREET IMPROVEMENTS
C.S.A.H. NO. 1 (ELK LAKE ROAD)
S.A.P. 71-601-13

DATE JAN. 1991 | SHEET 14 OF 28 SHEETS | PROJECT NO. 231-001

SC001-3

DRAWING NUMBER

DRAWING NUMBER

DRAWING NUMBER

DRAWING NUMBER 1CSAH 91 14