PROCTOR AVENUE TO SALK JR. HIGH SCHOOL

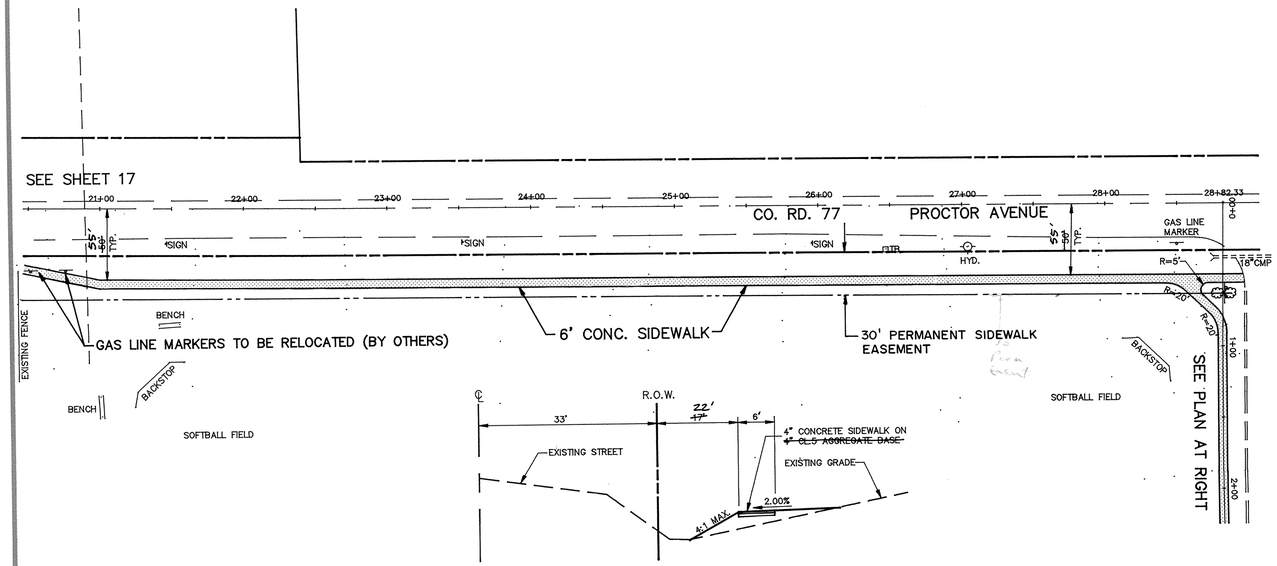

TYPICAL SIDEWALK SECTION

NO SCALE
NON-PARTICIPATING

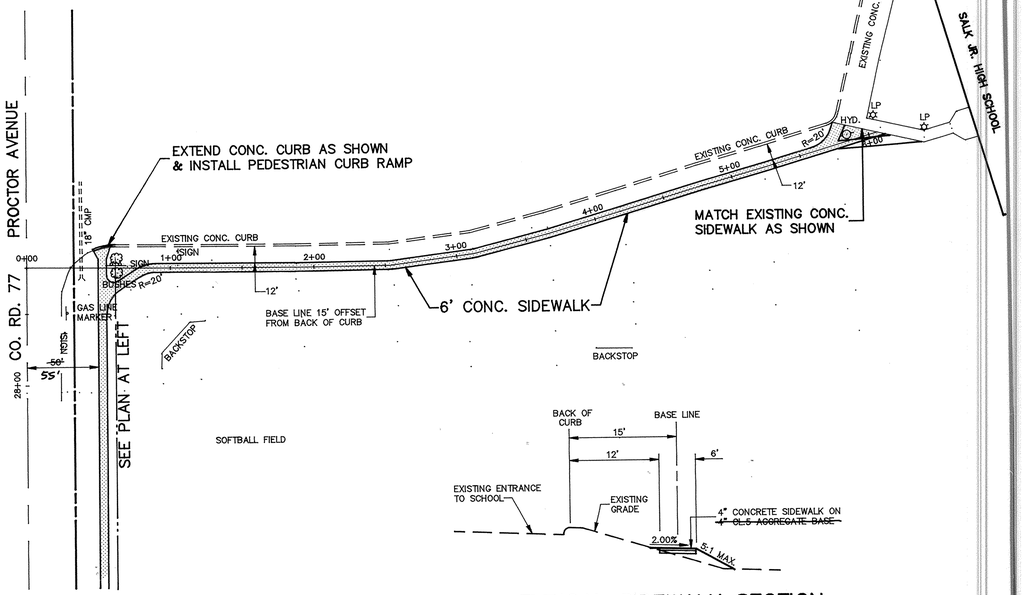

TYPICAL SIDEWALK SECTION

NO SCALE
NON-PARTICIPATING

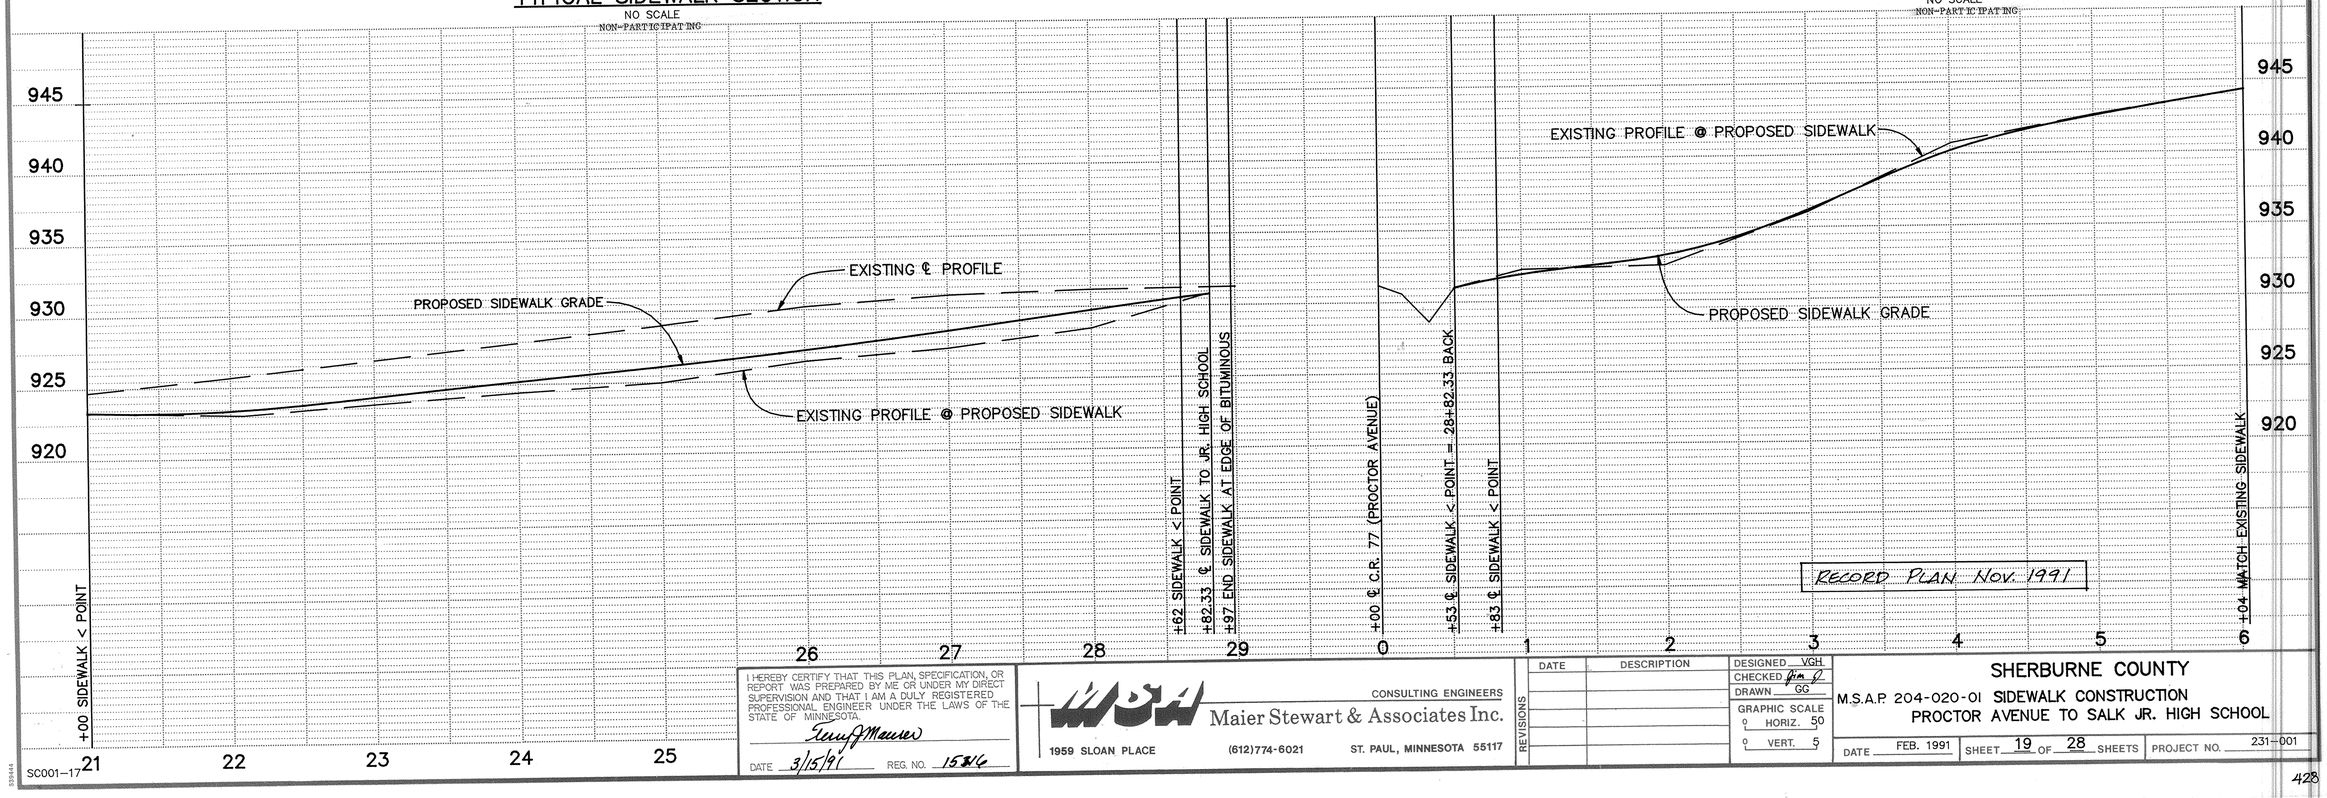

RECORD PLAN NOV. 1991

I HEREBY CERTIFY THAT THIS PLAN, SPECIFICATION, OR REPORT WAS PREPARED BY ME OR UNDER MY DIRECT SUPERVISION AND THAT I AM A DULY REGISTERED PROFESSIONAL ENGINEER UNDER THE LAWS OF THE STATE OF MINNESOTA.

Terry J. Maurer

DATE 3/15/91 REG. NO. 15816

CONSULTING ENGINEERS
Maier Stewart & Associates Inc.
1959 SLOAN PLACE (612)774-6021 ST. PAUL, MINNESOTA 55117

REVISIONS	DATE	DESCRIPTION

DESIGNED VGH
CHECKED jm
DRAWN GG
GRAPHIC SCALE
HORIZ. 50
VERT. 5

SHERBURNE COUNTY
M.S.A.P. 204-020-01 SIDEWALK CONSTRUCTION
PROCTOR AVENUE TO SALK JR. HIGH SCHOOL

DATE FEB. 1991 SHEET 19 OF 28 SHEETS PROJECT NO. 231-001

SC001-17

DRAWING NUMBER
1CSAH 91
19

SAFCO PRODUCTS • NEW HOPE, MINNESOTA
REORDER BY PART NUMBER 6502
FOLD ON EDGE OF PRINT ON THIS LINE