CSAH 13

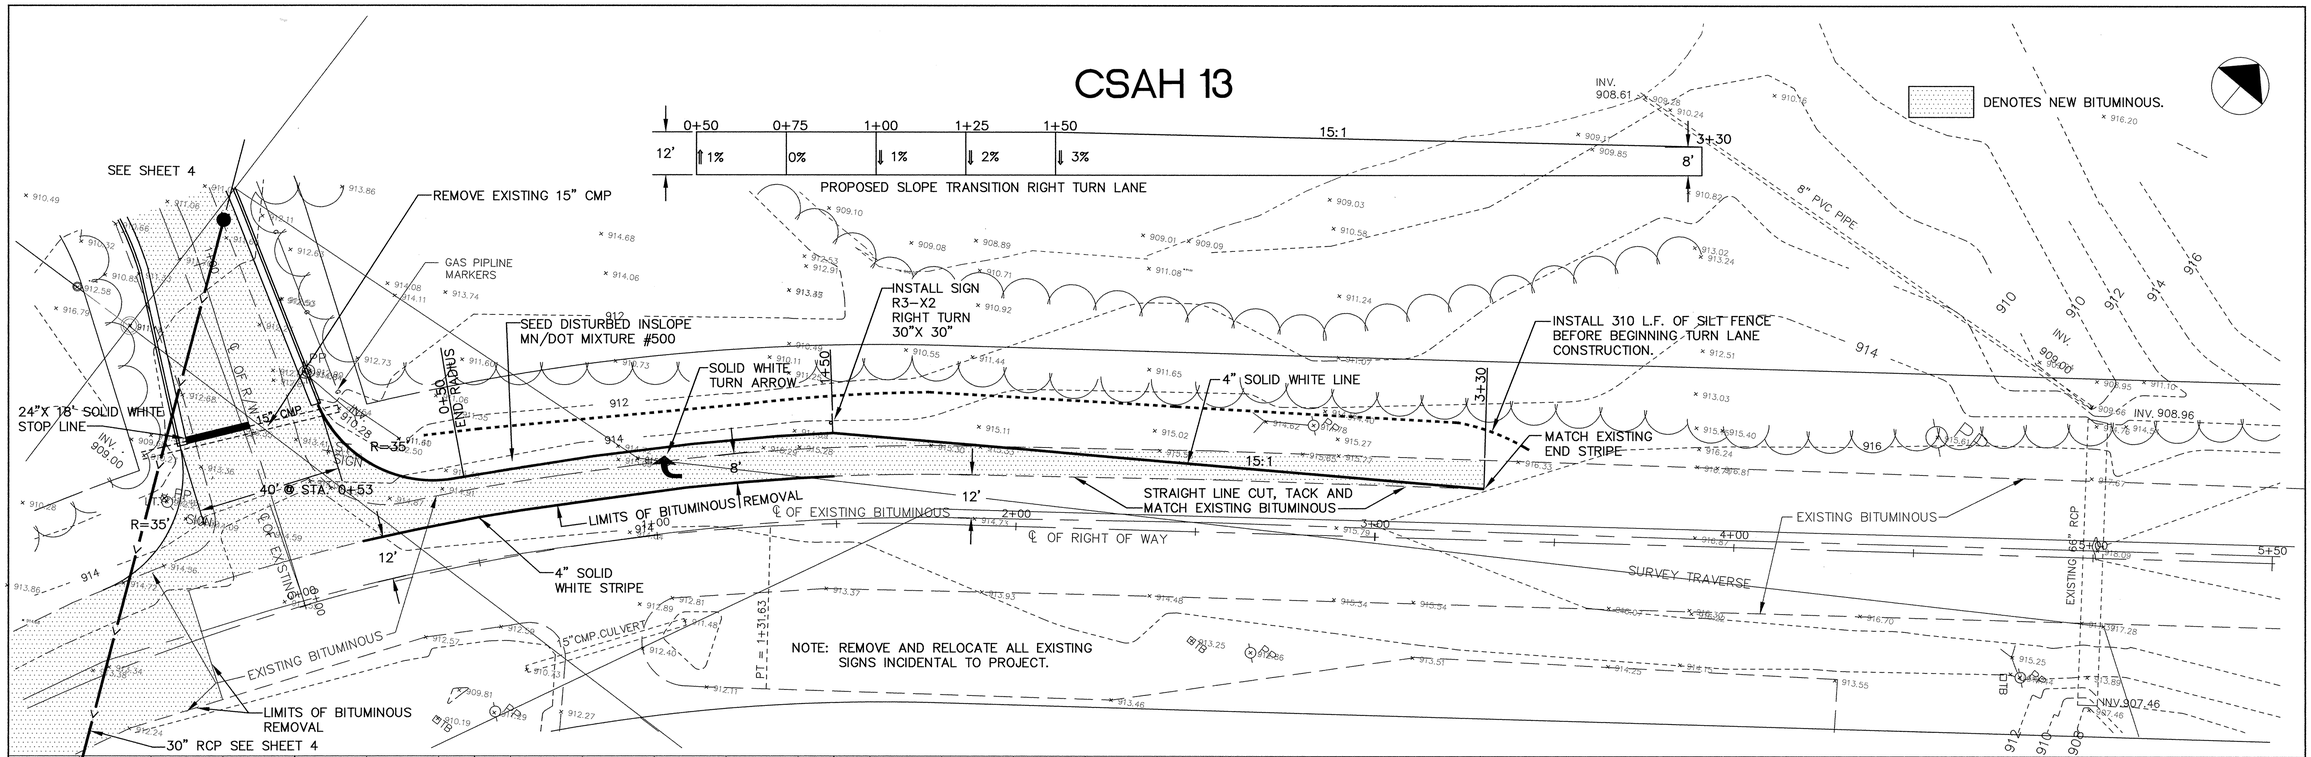

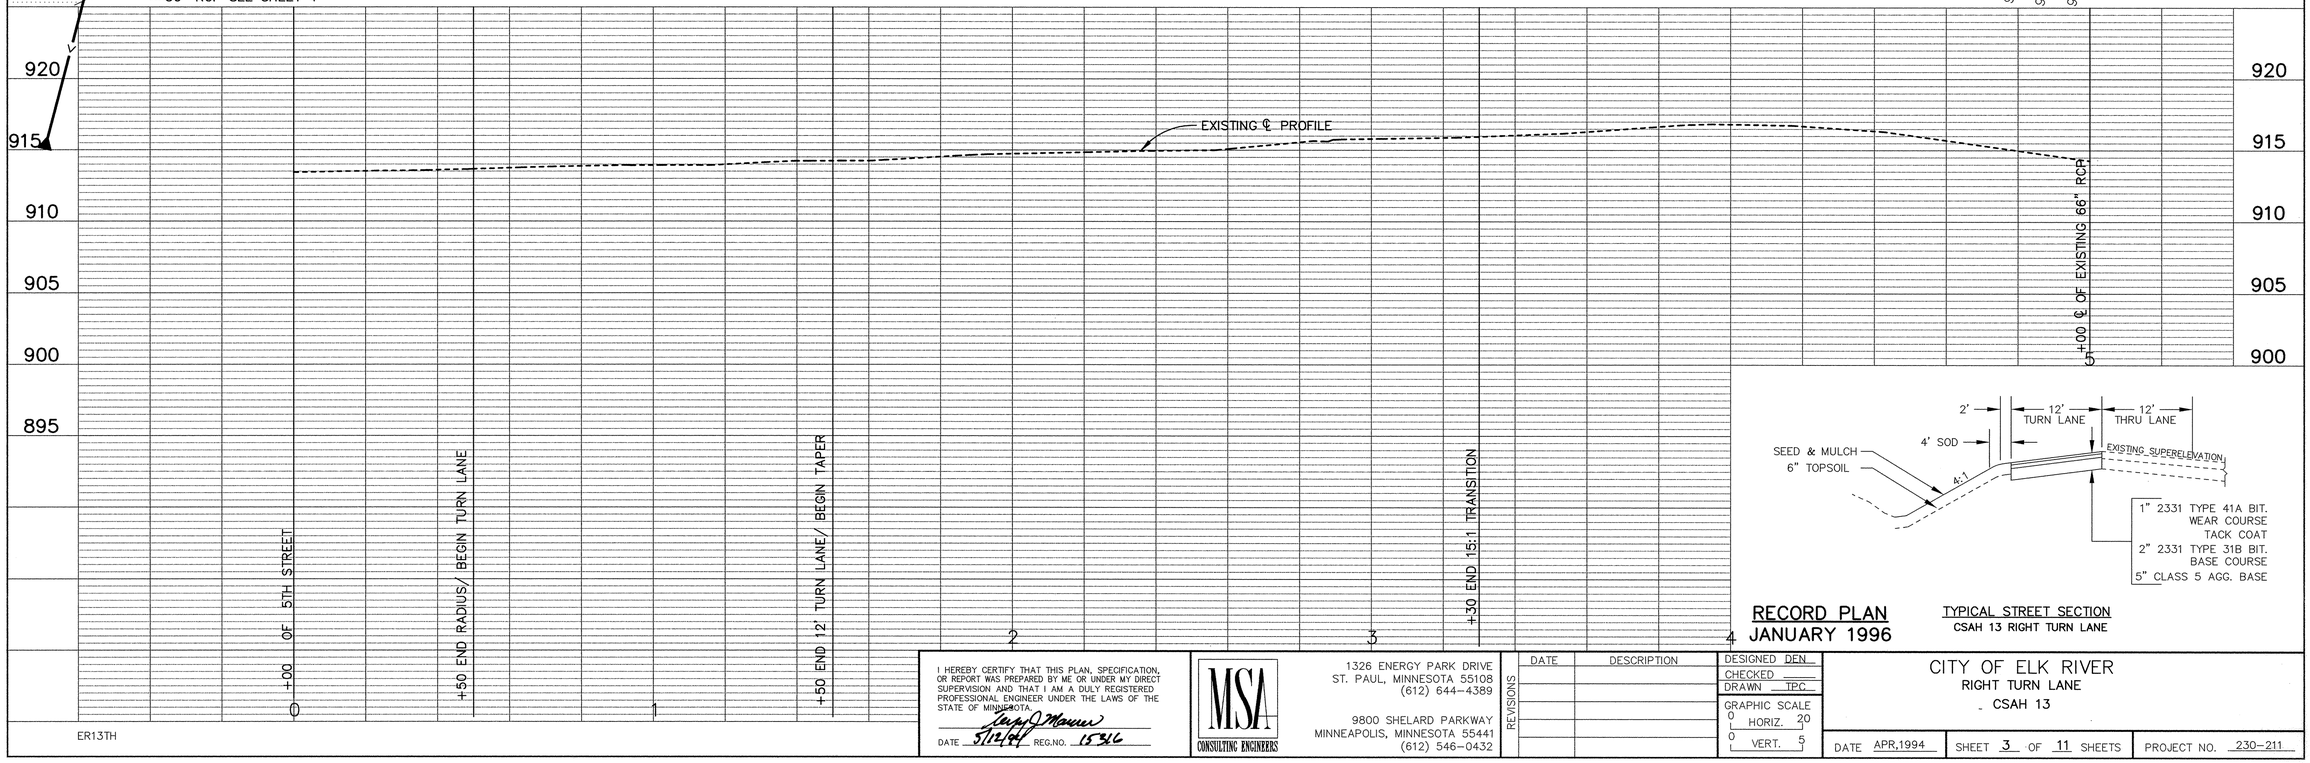

RECORD PLAN
JANUARY 1996

TYPICAL STREET SECTION
CSAH 13 RIGHT TURN LANE

I HEREBY CERTIFY THAT THIS PLAN, SPECIFICATION, OR REPORT WAS PREPARED BY ME OR UNDER MY DIRECT SUPERVISION AND THAT I AM A DULY REGISTERED PROFESSIONAL ENGINEER UNDER THE LAWS OF THE STATE OF MINNESOTA.
DATE 5/12/94 REG.NO. 15316

MSA CONSULTING ENGINEERS
1326 ENERGY PARK DRIVE
ST. PAUL, MINNESOTA 55108
(612) 644-4389
9800 SHELARD PARKWAY
MINNEAPOLIS, MINNESOTA 55441
(612) 546-0432

REVISIONS	DATE	DESCRIPTION

DESIGNED DEN
CHECKED
DRAWN TPC
GRAPHIC SCALE 0 HORIZ. 20 0 VERT. 5

CITY OF ELK RIVER
RIGHT TURN LANE
CSAH 13

DATE APR,1994 | SHEET 3 OF 11 SHEETS | PROJECT NO. 230-211

ER13TH

Wed Feb 28 07:56:51 1996

101B

DRAWING NUMBER
SUPCO PRODUCTS • NEW HOPE, MINNESOTA
REORDER BY PART NUMBER 6956

DRAWING NUMBER
SUPCO PRODUCTS • NEW HOPE, MINNESOTA
REORDER BY PART NUMBER 6956

DRAWING NUMBER
5STRE 95
3
SUPCO PRODUCTS • NEW HOPE, MINNESOTA
REORDER BY PART NUMBER 6956