


- NOTES**
1. REMOVE AND RELOCATE ALL EXISTING SIGNS INCIDENTAL TO PROJECT.
 2. ALL RC PIPE CLASS III UNLESS OTHERWISE NOTED.

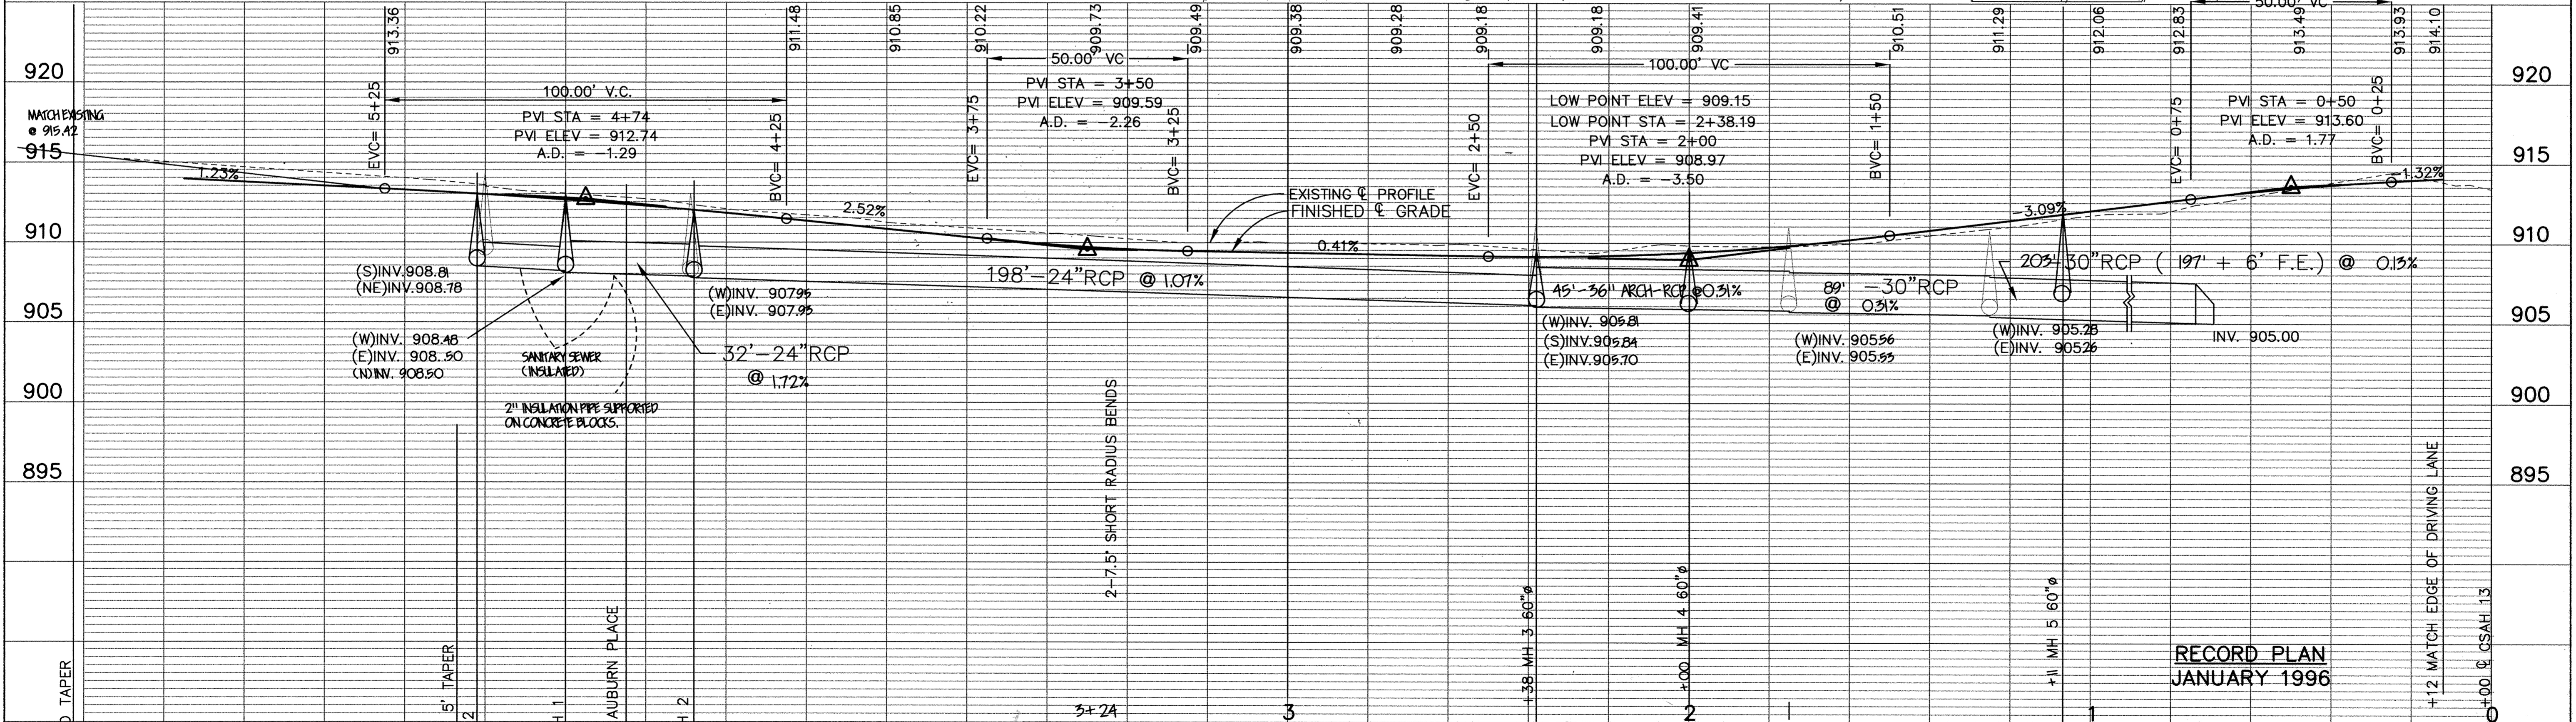

I HEREBY CERTIFY THAT THIS PLAN, SPECIFICATION, OR REPORT WAS PREPARED BY ME OR UNDER MY DIRECT SUPERVISION AND THAT I AM A DULY REGISTERED PROFESSIONAL ENGINEER UNDER THE LAWS OF THE STATE OF MINNESOTA. <i>Jerry J. Mann</i> DATE 5/12/94 REG. NO. 15316		1326 ENERGY PARK DRIVE ST. PAUL, MINNESOTA 55108 (612) 644-4389	DATE 6-12-95 DESCRIPTION REVISED TO MATCH PLANS FOR 5TH ST. WEST TO TH 169	DESIGNED DEN. CHECKED TPC DRAWN TPC	CITY OF ELK RIVER STREET AND UTILITY IMPROVEMENTS 5TH STREET
		9800 SHELARD PARKWAY MINNEAPOLIS, MINNESOTA 55441 (612) 546-0432	REVISIONS 1 2 3	GRAPHIC SCALE 0 HORIZ. 20 0 VERT. 5	

SAIC PRODUCTS • NEW HOPKINS, MINNESOTA
 PREPARED BY PART NUMBER 6592
