STORM SEWER

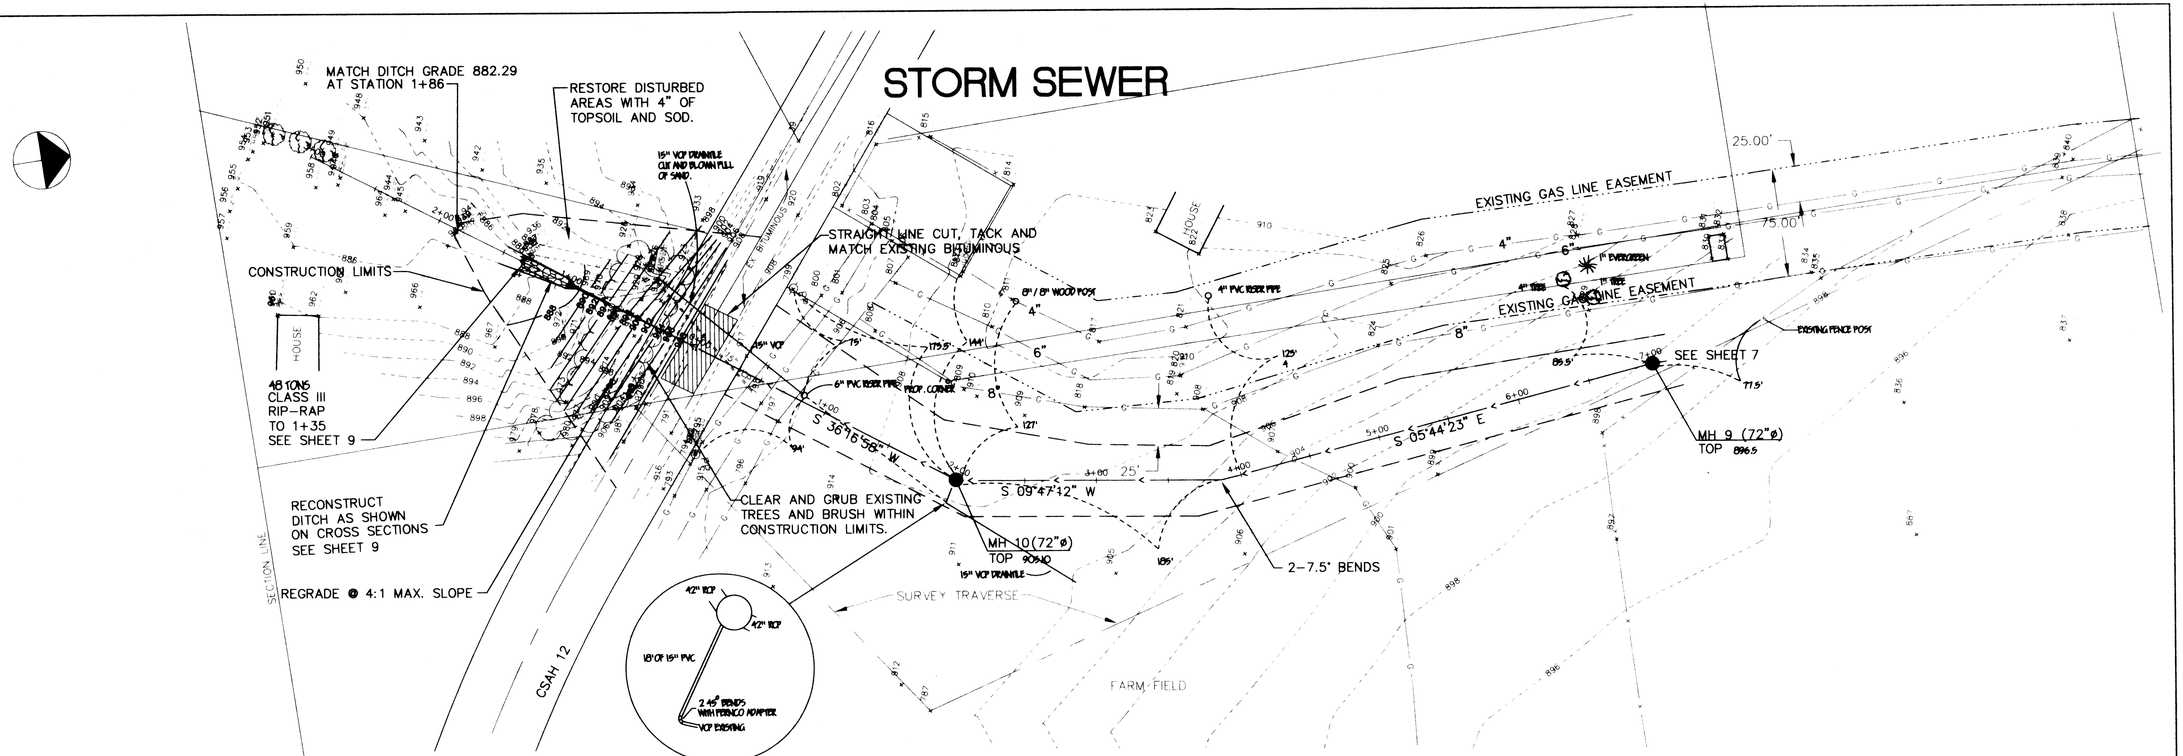

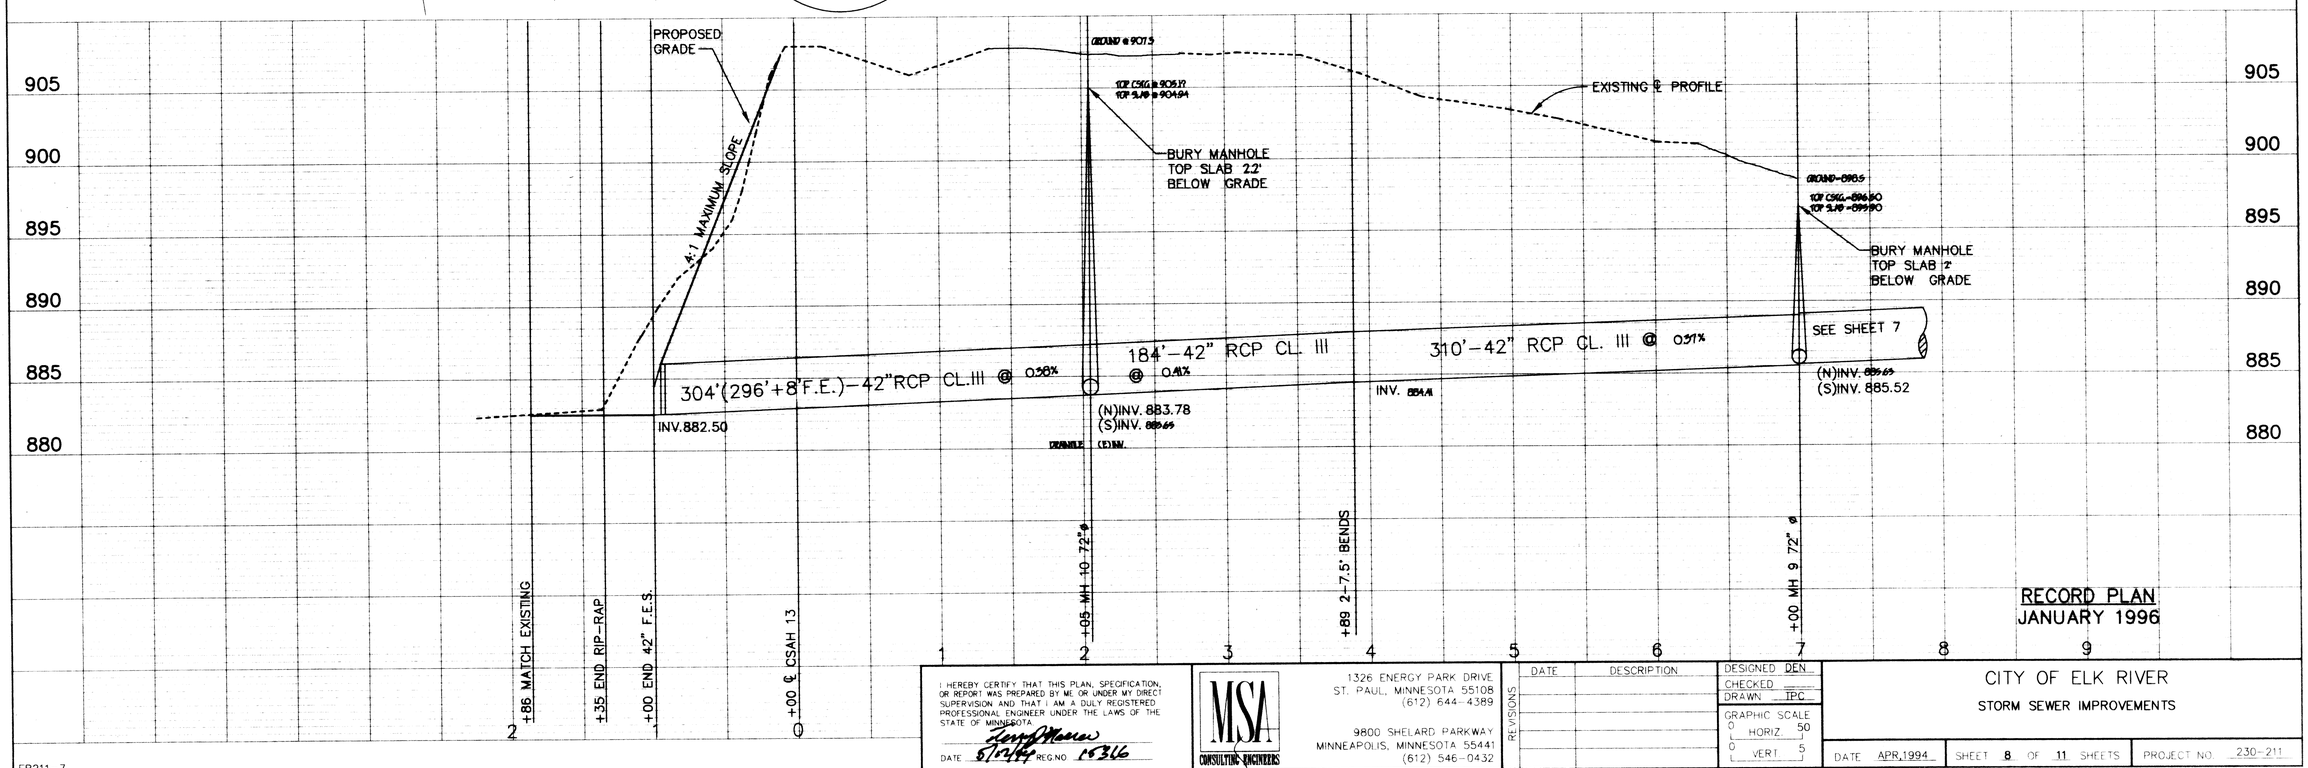

RECORD PLAN
JANUARY 1996

I HEREBY CERTIFY THAT THIS PLAN, SPECIFICATION, OR REPORT WAS PREPARED BY ME OR UNDER MY DIRECT SUPERVISION AND THAT I AM A DULY REGISTERED PROFESSIONAL ENGINEER UNDER THE LAWS OF THE STATE OF MINNESOTA.
DATE 5/10/94 REG.NO. 16316

MSA CONSULTING ENGINEERS
1326 ENERGY PARK DRIVE
ST. PAUL, MINNESOTA 55108
(612) 644-4389
9800 SHELARD PARKWAY
MINNEAPOLIS, MINNESOTA 55441
(612) 546-0432

REVISIONS	DATE	DESCRIPTION

DESIGNED DEN
CHECKED
DRAWN TPC
GRAPHIC SCALE
HORIZ 50
VERT 5

CITY OF ELK RIVER
STORM SEWER IMPROVEMENTS

DATE APR.1994 | SHEET 8 OF 11 SHEETS | PROJECT NO. 230-211

ER211-7

1013