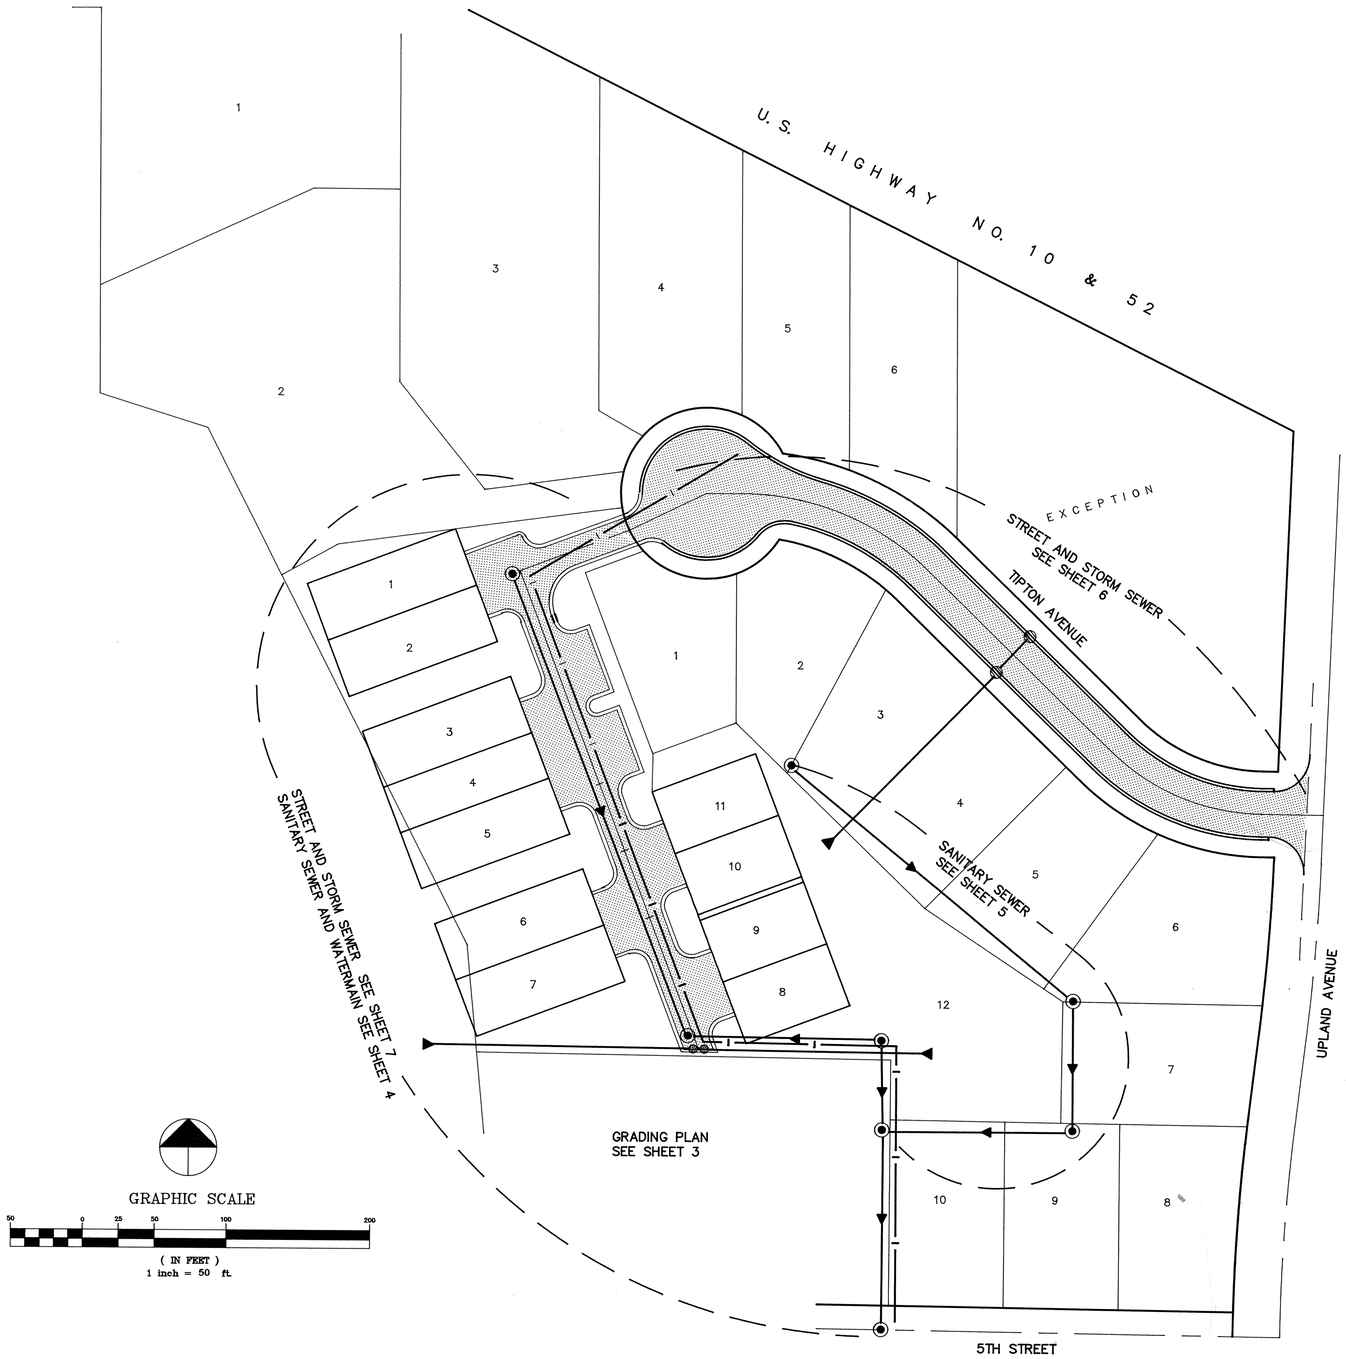

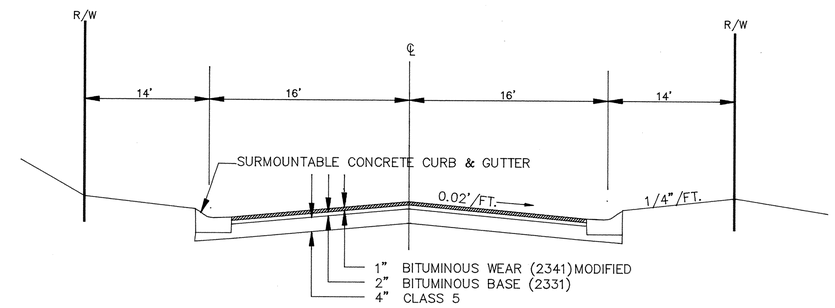

TYPICAL STREET SECTION

TIPTON AVENUE

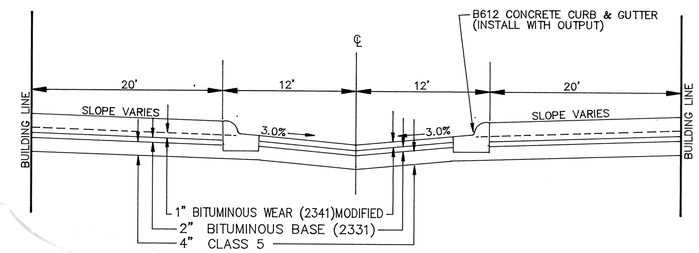

TYPICAL STREET SECTION

DRIVEWAY TO MULTIPLE HOMES

NOTE:
PLAN BASED ON BAILEY BECK ADDITION PRELIMINARY PLAT PREPARED BY JOHN OLIVER AND ASSOCIATES AND DATED APRIL 1990.

RECORD PLAN DEC. 1990

I HEREBY CERTIFY THAT THIS PLAN, SPECIFICATION, OR REPORT WAS PREPARED BY ME OR UNDER MY DIRECT SUPERVISION AND THAT I AM A DULY REGISTERED PROFESSIONAL ENGINEER UNDER THE LAWS OF THE STATE OF MINNESOTA.

Gerry J. Maurer

DATE 4/17/90 REG. NO. 15816

MSA CONSULTING ENGINEERS
Maier Stewart & Associates Inc.
1959 SLOAN PLACE (612)774-6021 ST. PAUL, MINNESOTA 55117

REVISIONS	DATE	DESCRIPTION

DESIGNED
CHECKED
DRAWN
GRAPHIC SCALE
0 HORIZ. 50
0 VERT. 5

CITY OF ELK RIVER
BAILEY – BECK ADDITION
LOCATION MAP AND DETAILS

DATE MARCH, 1990 | SHEET 2 OF 11 SHEETS | PROJECT NO. 230–086

ER086

DRAWING NUMBER
SAFCO PRODUCTS • NEW HOPE, MINNESOTA
REORDER BY PART NUMBER 65352
POSITION CODE OF PART ON THIS LINE

DRAWING NUMBER
SAFCO PRODUCTS • NEW HOPE, MINNESOTA
REORDER BY PART NUMBER 65352
POSITION CODE OF PART ON THIS LINE

DRAWING NUMBER
SAFCO PRODUCTS • NEW HOPE, MINNESOTA
REORDER BY PART NUMBER 65352
POSITION CODE OF PART ON THIS LINE

DRAWING NUMBER
BAILE 90
2
SAFCO PRODUCTS • NEW HOPE, MINNESOTA
REORDER BY PART NUMBER 65352
POSITION CODE OF PART ON THIS LINE