



Fed. Proj. No.

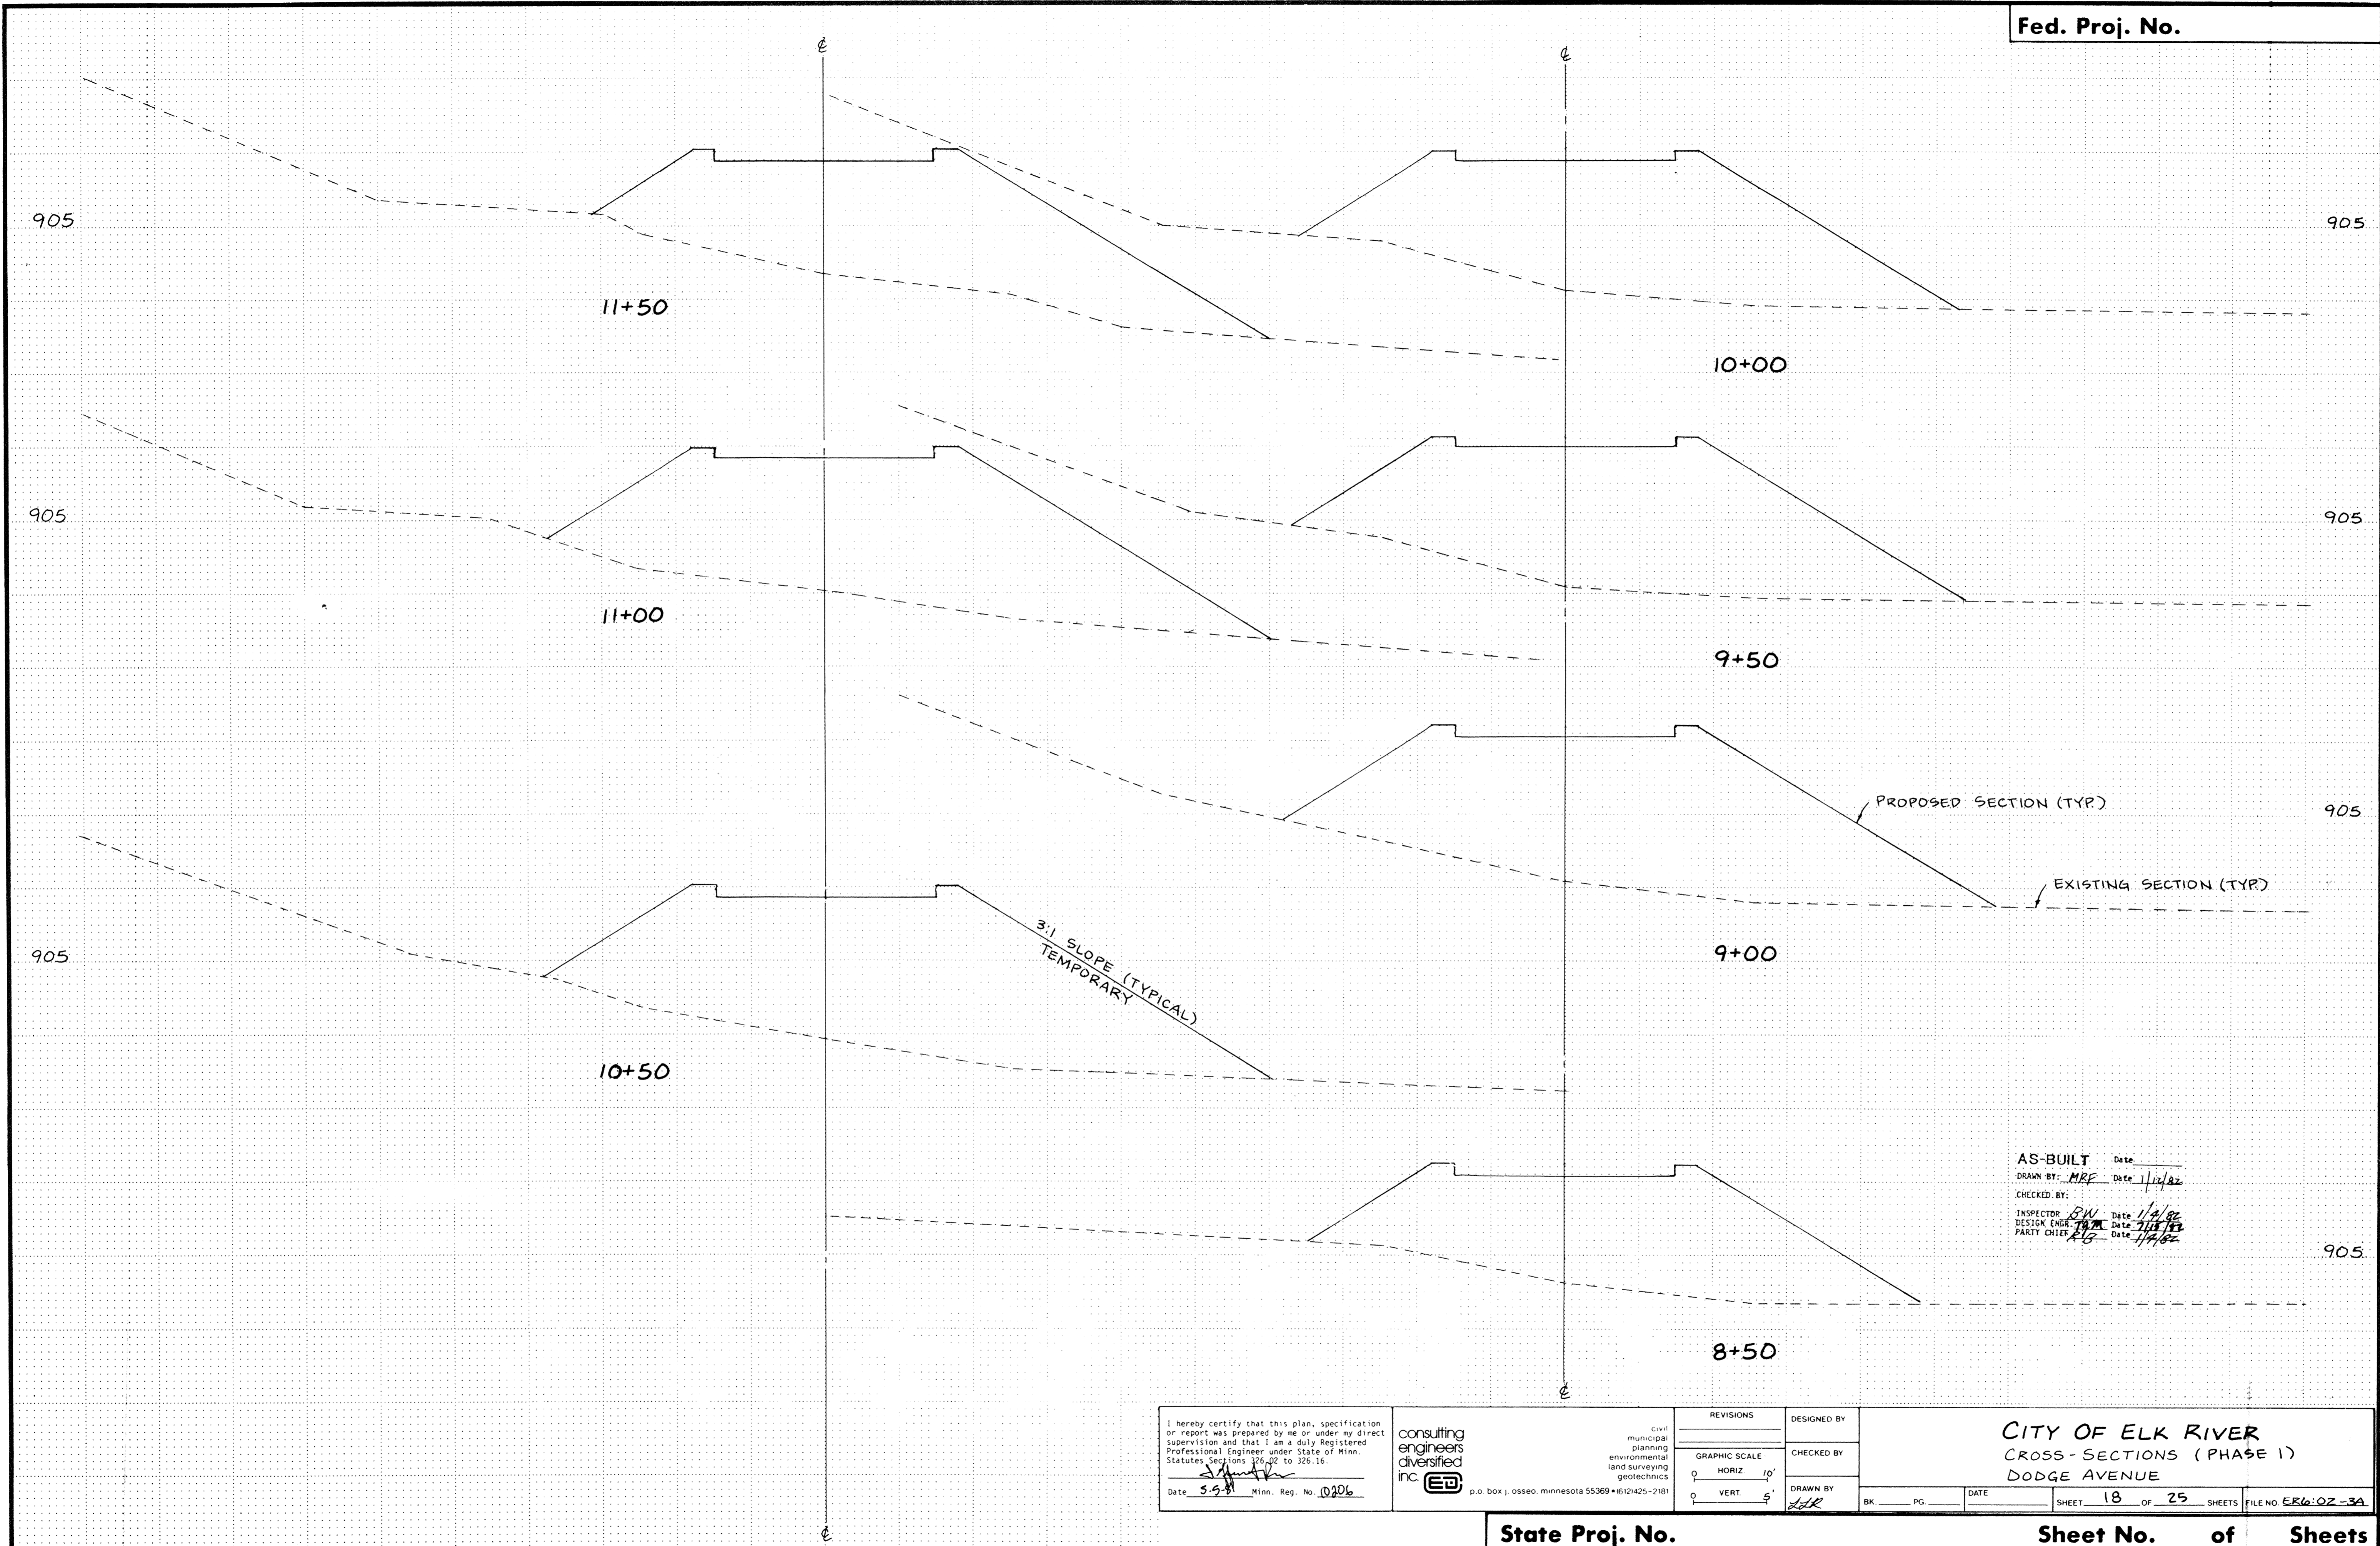

I hereby certify that this plan, specification or report was prepared by me or under my direct supervision and that I am a duly Registered Professional Engineer under State of Minn. Statutes sections 326.02 to 326.16.

*[Signature]*  
Date 5-5-81 Minn. Reg. No. 0206

consulting engineers diversified inc.   
p.o. box 1, osseo, minnesota 55369 • (612) 425-2181

REVISIONS	

DESIGNED BY  
CHECKED BY  
DRAWN BY *[Signature]*

CITY OF ELK RIVER  
CROSS-SECTIONS (PHASE I)  
DODGE AVENUE

BK. \_\_\_\_\_ PG. \_\_\_\_\_ DATE \_\_\_\_\_ SHEET 18 OF 25 SHEETS FILE NO. EK6:02-3A

State Proj. No. \_\_\_\_\_ Sheet No. \_\_\_\_\_ of \_\_\_\_\_ Sheets