Fed. Proj. No.

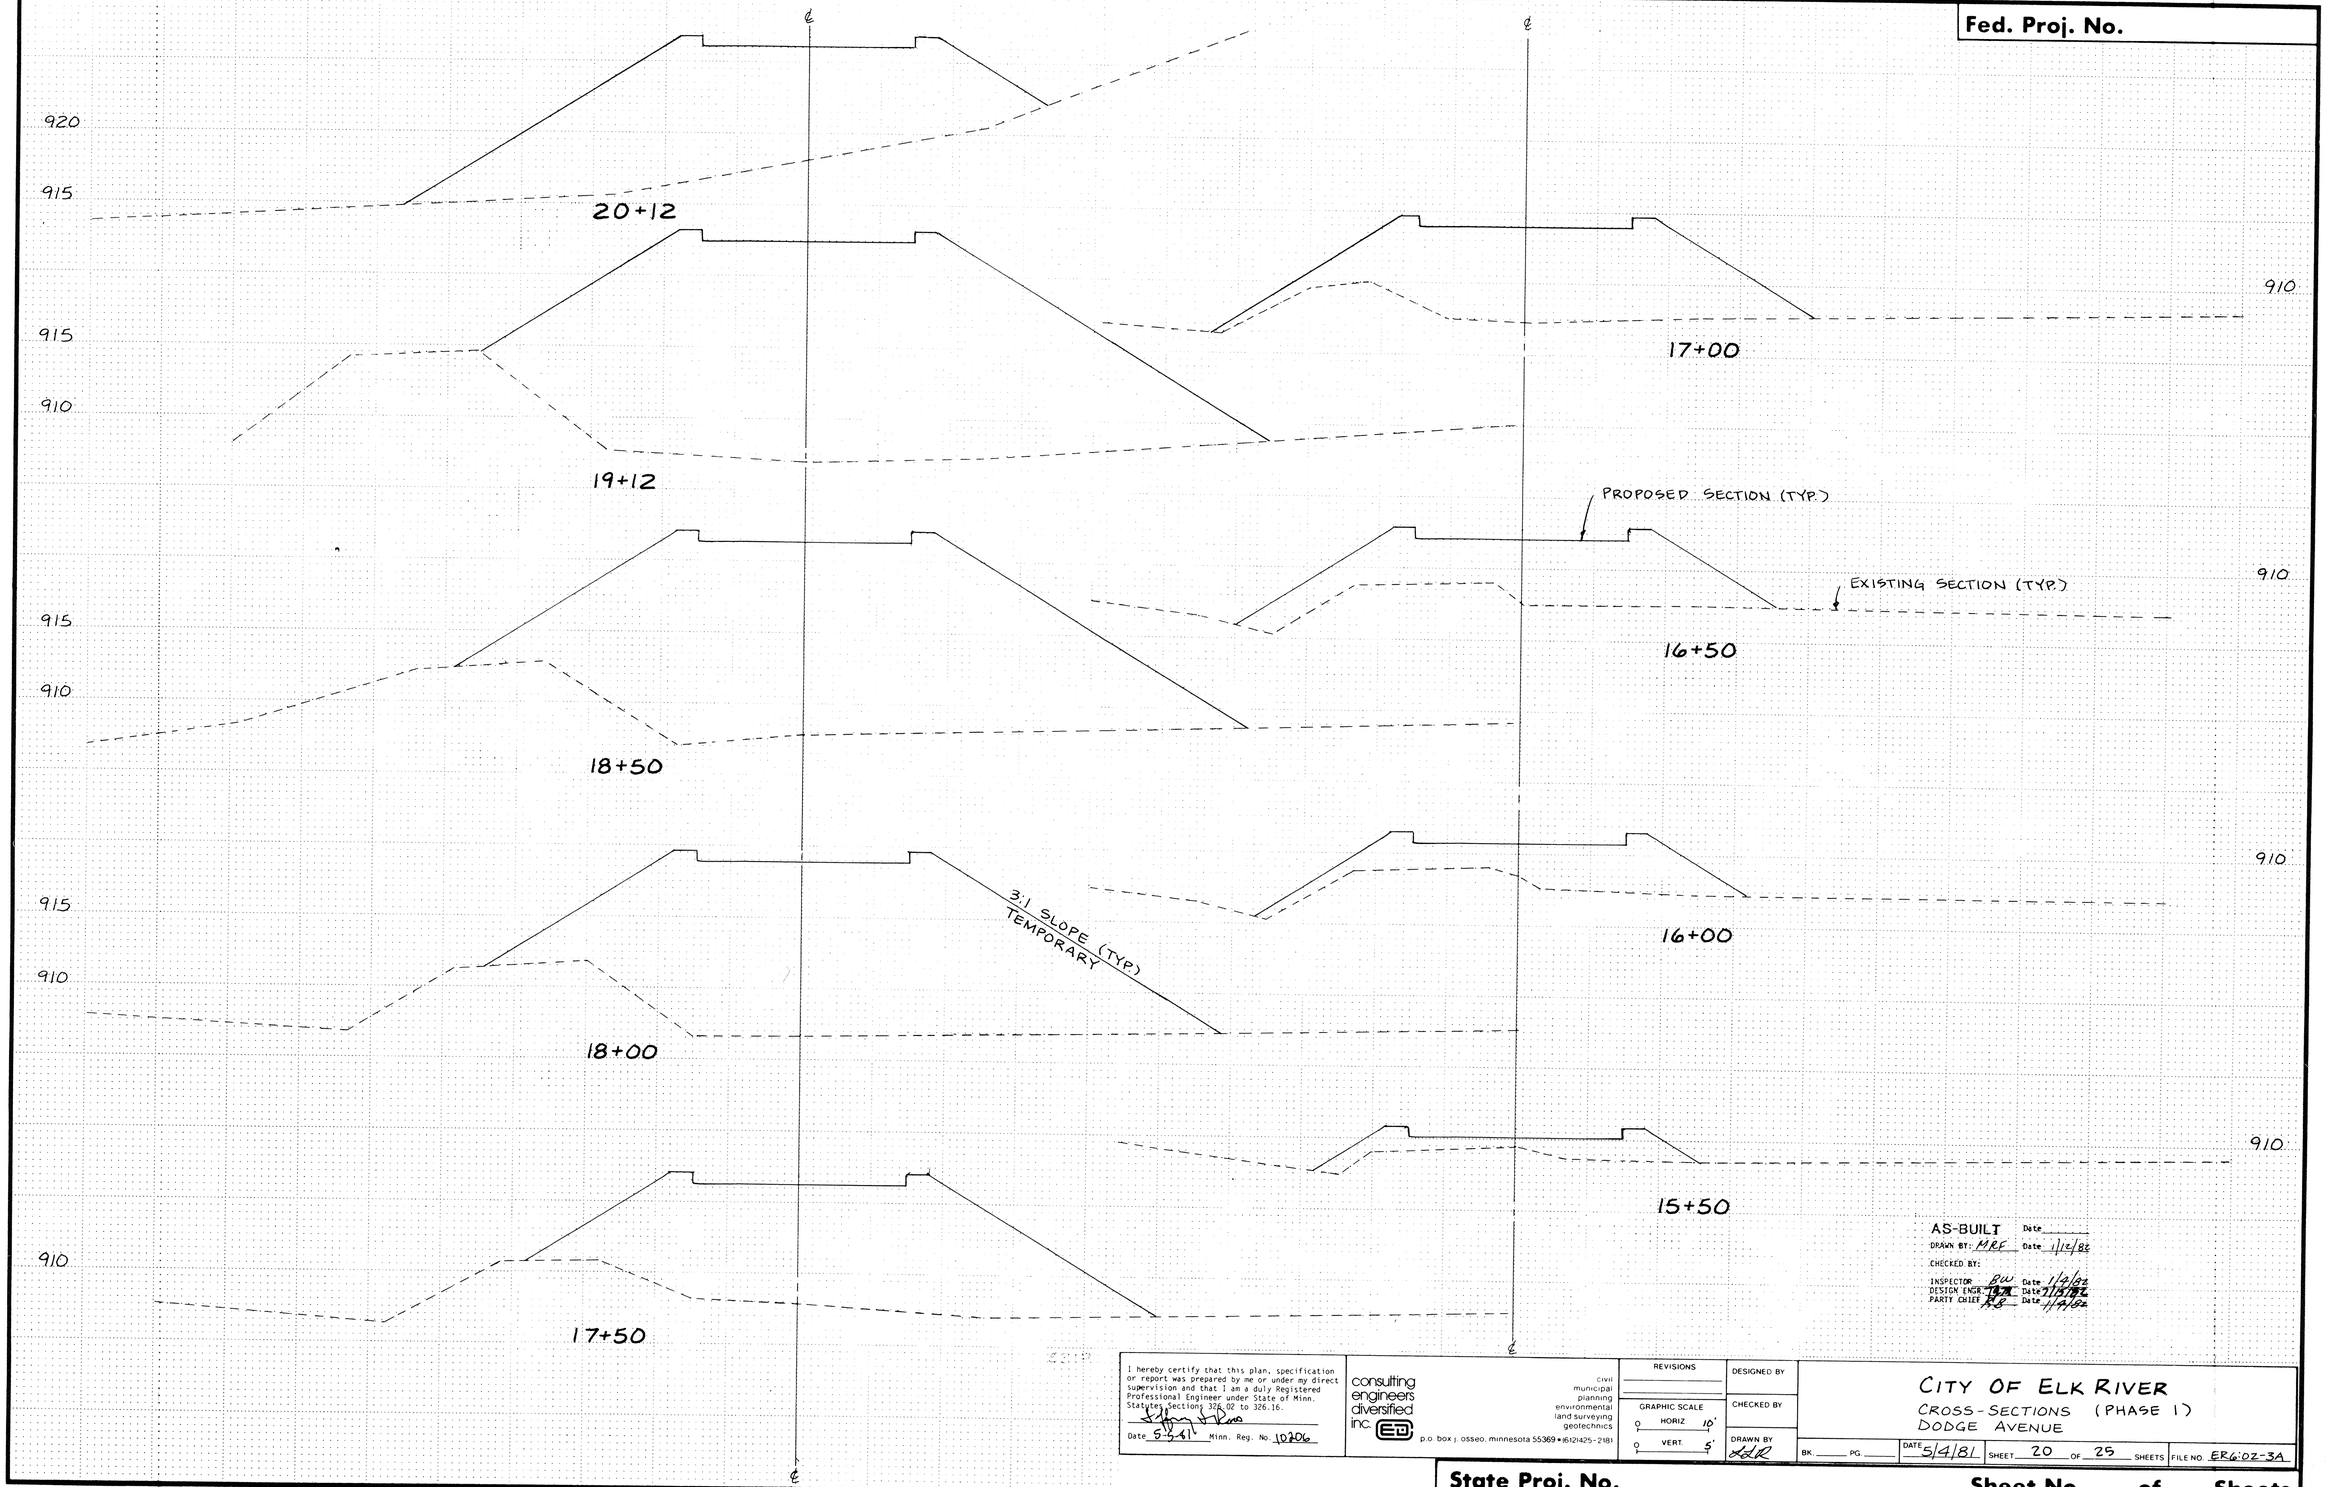

AS-BUILT Date

DRAWN BY: MRF Date 1/12/82

CHECKED BY:

INSPECTOR RW Date 1/4/82

DESIGN ENGR. [illegible] Date 2/1/82

PARTY CHIEF [illegible] Date 1/14/82

I hereby certify that this plan, specification or report was prepared by me or under my direct supervision and that I am a duly Registered Professional Engineer under State of Minn. Statutes Sections 326.02 to 326.16.

Date 5-5-81 Minn. Reg. No. 10206

consulting engineers diversified inc.

civil
municipal
planning
environmental
land surveying
geotechnics

p.o. box j, osseo, minnesota 55369 • (612)425-2181

REVISIONS

GRAPHIC SCALE
0 HORIZ 10'
0 VERT. 5'

DESIGNED BY

CHECKED BY

DRAWN BY KLR

CITY OF ELK RIVER
CROSS-SECTIONS (PHASE I)
DODGE AVENUE

BK. PG. DATE 5/4/81 SHEET 20 OF 25 SHEETS FILE NO. ER6-02-3A

State Proj. No.

Sheet No. of Sheets

DRAWING NUMBER

DRAWING NUMBER

DRAWING NUMBER
20

SAFCO PRODUCTS • NEW HOPE, MINNESOTA
REORDER BY PART NUMBER 6553
POSITION SIDE OF PRINT ON THIS LINE