


Fed. Proj. No.

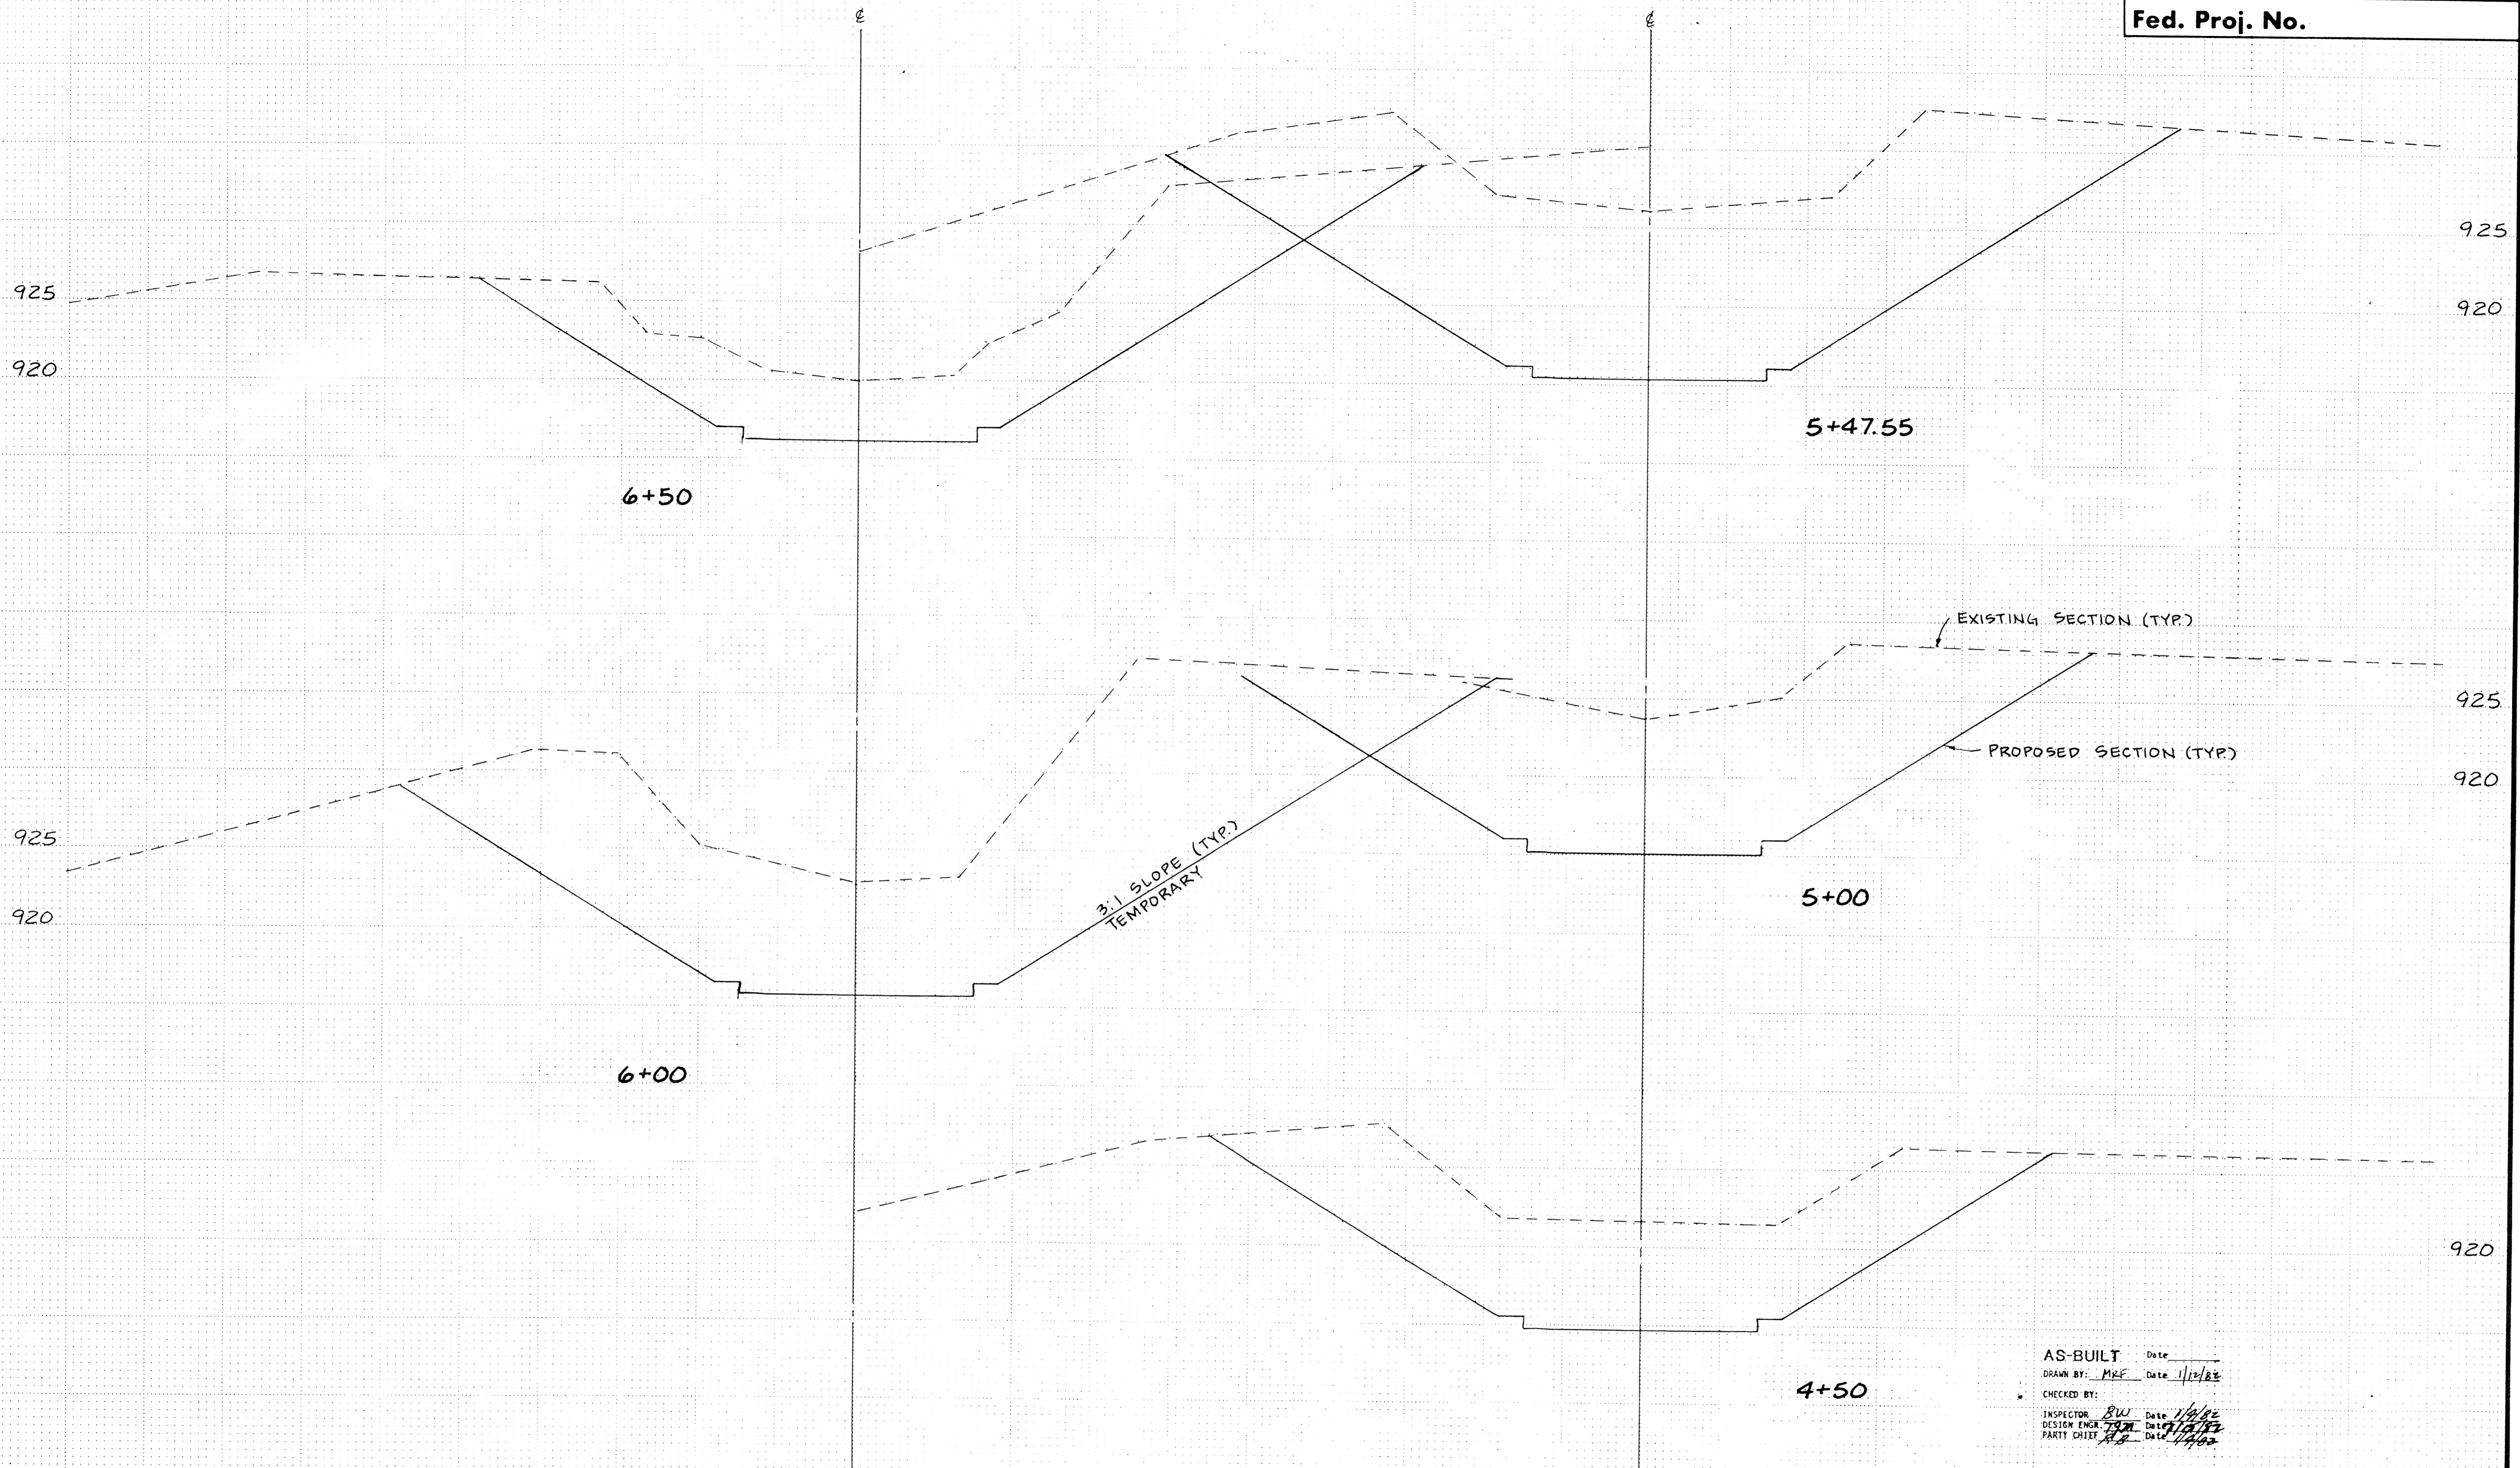

AS-BUILT Date _____
 DRAWN BY: MRF Date 1/12/82
 CHECKED BY: _____
 INSPECTOR: RW Date 1/14/82
 DESIGN ENGR: JRM Date 1/14/82
 PARTY CHIEF: JRM Date 1/14/82

I hereby certify that this plan, specification or report was prepared by me or under my direct supervision and that I am a duly Registered Professional Engineer under State of Minn. Statutes sections 326.02 to 326.16. <i>Jeffrey J. Ross</i> Date 5/12/81 Minn. Reg. No. 10206	consulting engineers diversified inc. p.o. box 1, osseo, minnesota 55369 • 612/425-2181 civil, municipal, planning, environmental, land surveying, geotechnics	REVISIONS	DESIGNED BY	CITY OF ELK RIVER CROSS-SECTIONS (PHASE 2) AUBURN PLACE
		GRAPHIC SCALE 0' 10' 0' 5' 1" 5'	CHECKED BY	