Fed. Proj. No.

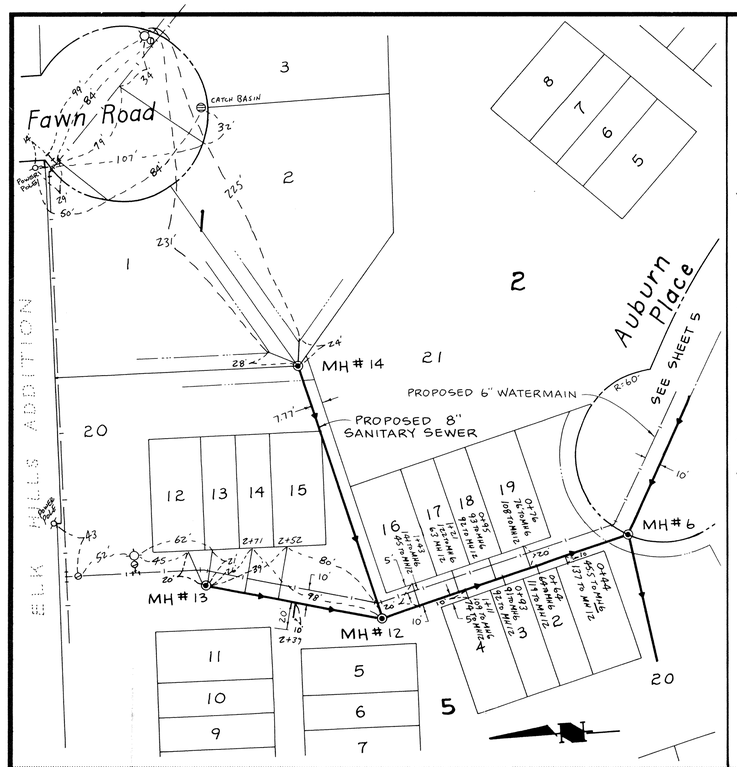

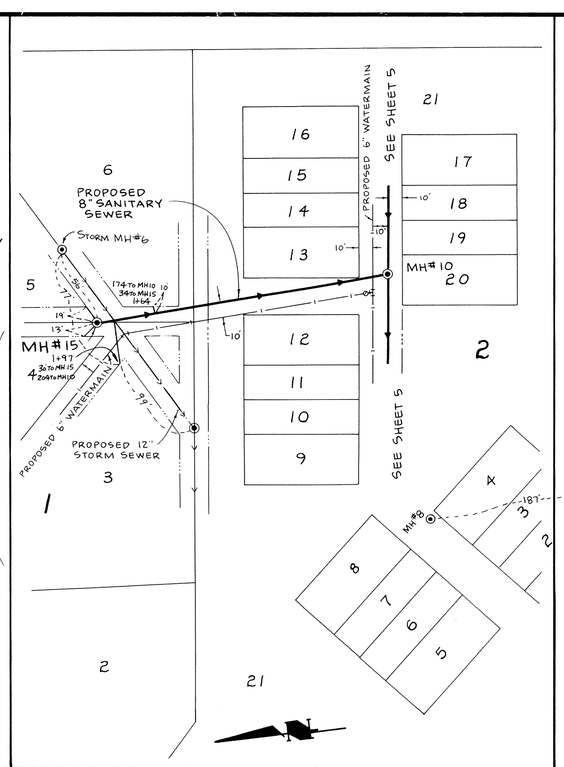

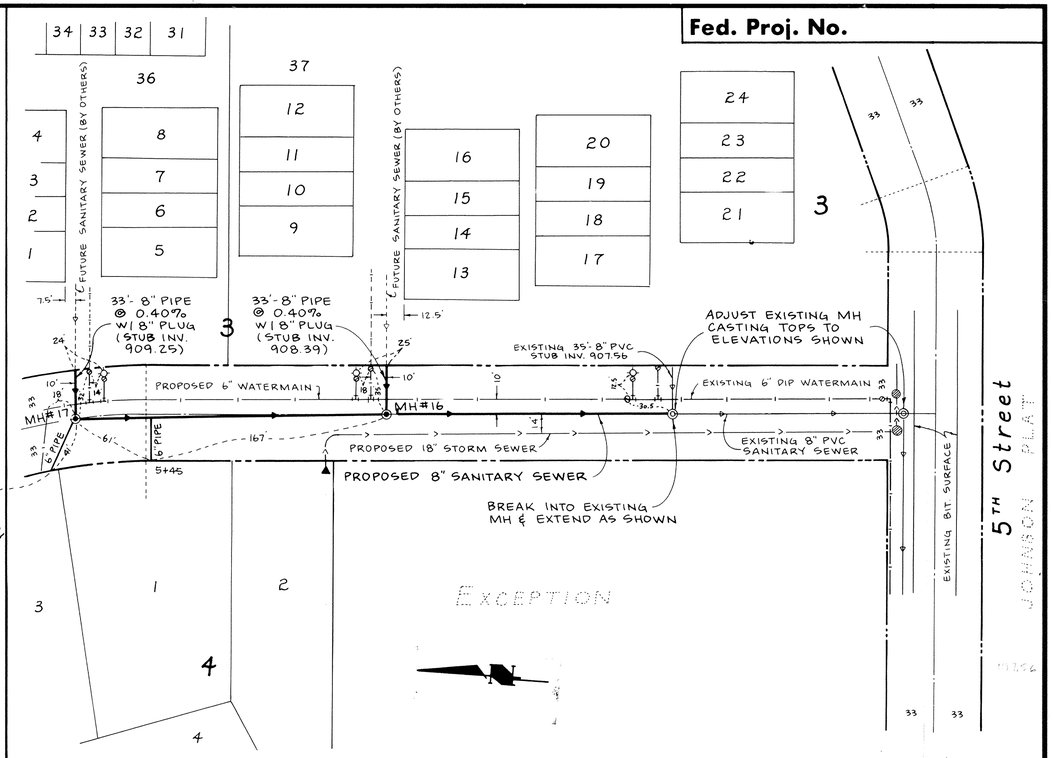

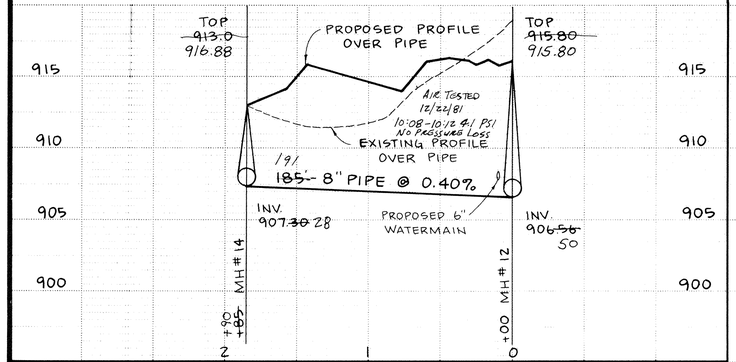

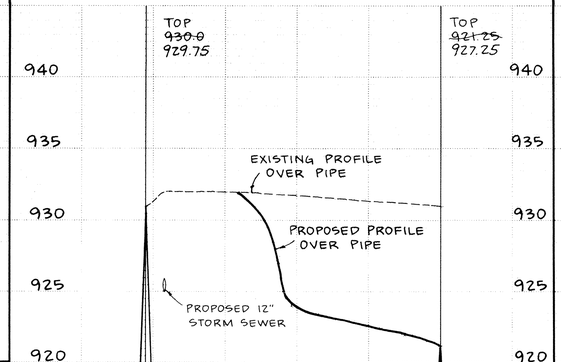

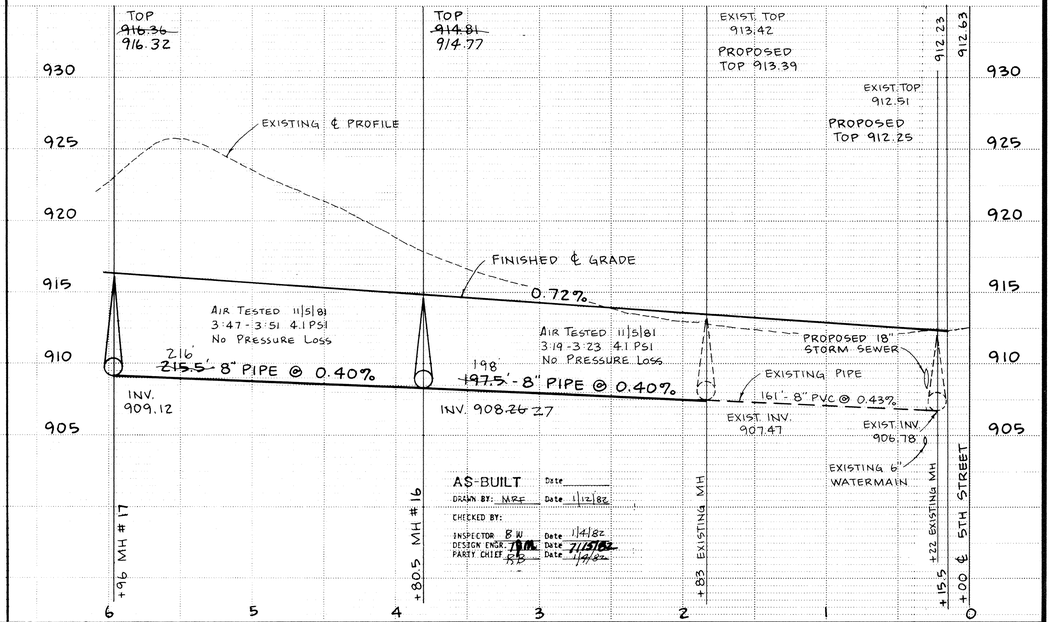

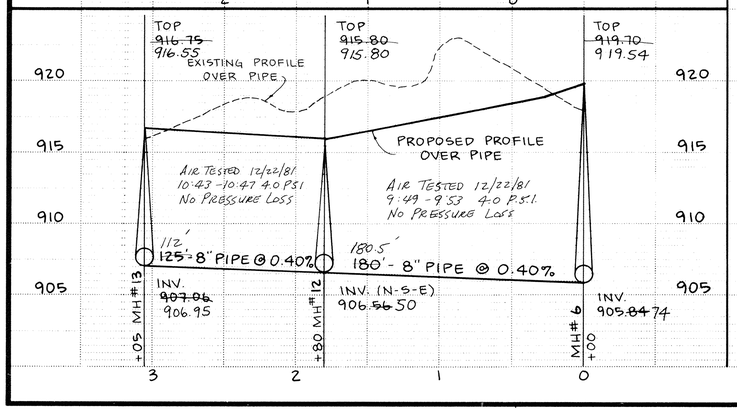

Tiffany & Rosso	consulting engineers diversified inc	REVISIONS	DESIGNED BY TAK TJM
date 5-5-81 rev. no. 10896	civil land planning environmental surveying geotechnics	GRAPHIC SCALE HORIZ 50 VERT 5	CHECKED BY PRR
			DRAWN BY TAK

AS-BUILT Date
DRAWN BY: MRF Date 1/12/82
CHECKED BY:
INSPECTOR B.W. Date 1/14/82
DESIGN ENGR. TJM Date 7/19/82
PARTY CHIEF RB Date 1/14/82

CITY OF ELK RIVER
SANITARY SEWER (PHASE 2)
AUBURN PLACE, AUBURN PLACE EXT., N.E. PLAT COR.

BK ___ PG ___ | DATE APRIL 81 | SHEET 6 OF 25 SHEETS | FILE NO ER6:02-3A

State Proj. No. | Sheet No. of Sheets

DRAWING NUMBER

DRAWING NUMBER
6
BARR1.81

ARCHITECTS • NEW HOPE, MINNESOTA
SAFECO PRODUCTS • NEW HOPE, MINNESOTA
REORDER BY PART NUMBER 6505