


# SHEET INDEX


| | |
|---|---|
| TITLE SHEET | 1 |
| INDEX AND LOCATION SHEET | 2 |
| 181ST LN NW – SANITARY SEWER, WATERMAIN, STORM SEWER, AND STREET CONSTRUCTION | 3 |
| 182ND AVE NW – SANITARY SEWER, WATERMAIN, STORM SEWER AND STREET CONSTRUCTION | 4 |
| MACON ST NW – SANITARY SEWER, WATERMAIN AND STREET CONSTRUCTION | 5 |
| LANDER ST NW – SANITARY SEWER WATERMAIN, STORM SEWER AND STREET CONSTRUCTION | 6 |
| DETAILS | 7 |
| DETAILS | 8 |
| DETAILS | 9 |


## RECORD DRAWINGS

PRIME CONTRACTOR/UTILITIES: C.W. HOULE, INC.
CURB & GUTTER: HALVORSON CURB CO.
STREETS: BAUERLY BROS., INC.
FIELD PROJECT MANAGER: FRED FRITSCHEL, JOA
INSPECTION: RALPH BADER, MSA CONSULTING ENGINEERS
SURVEY: JOHN OLIVER & ASSOCIATES, INC.
EARTHWORK: DENNIS FEHN EXCAVATING, INC.
RECORD DRAWINGS: FRED FRITSCHEL, JOA
CONSTRUCTED: 1996

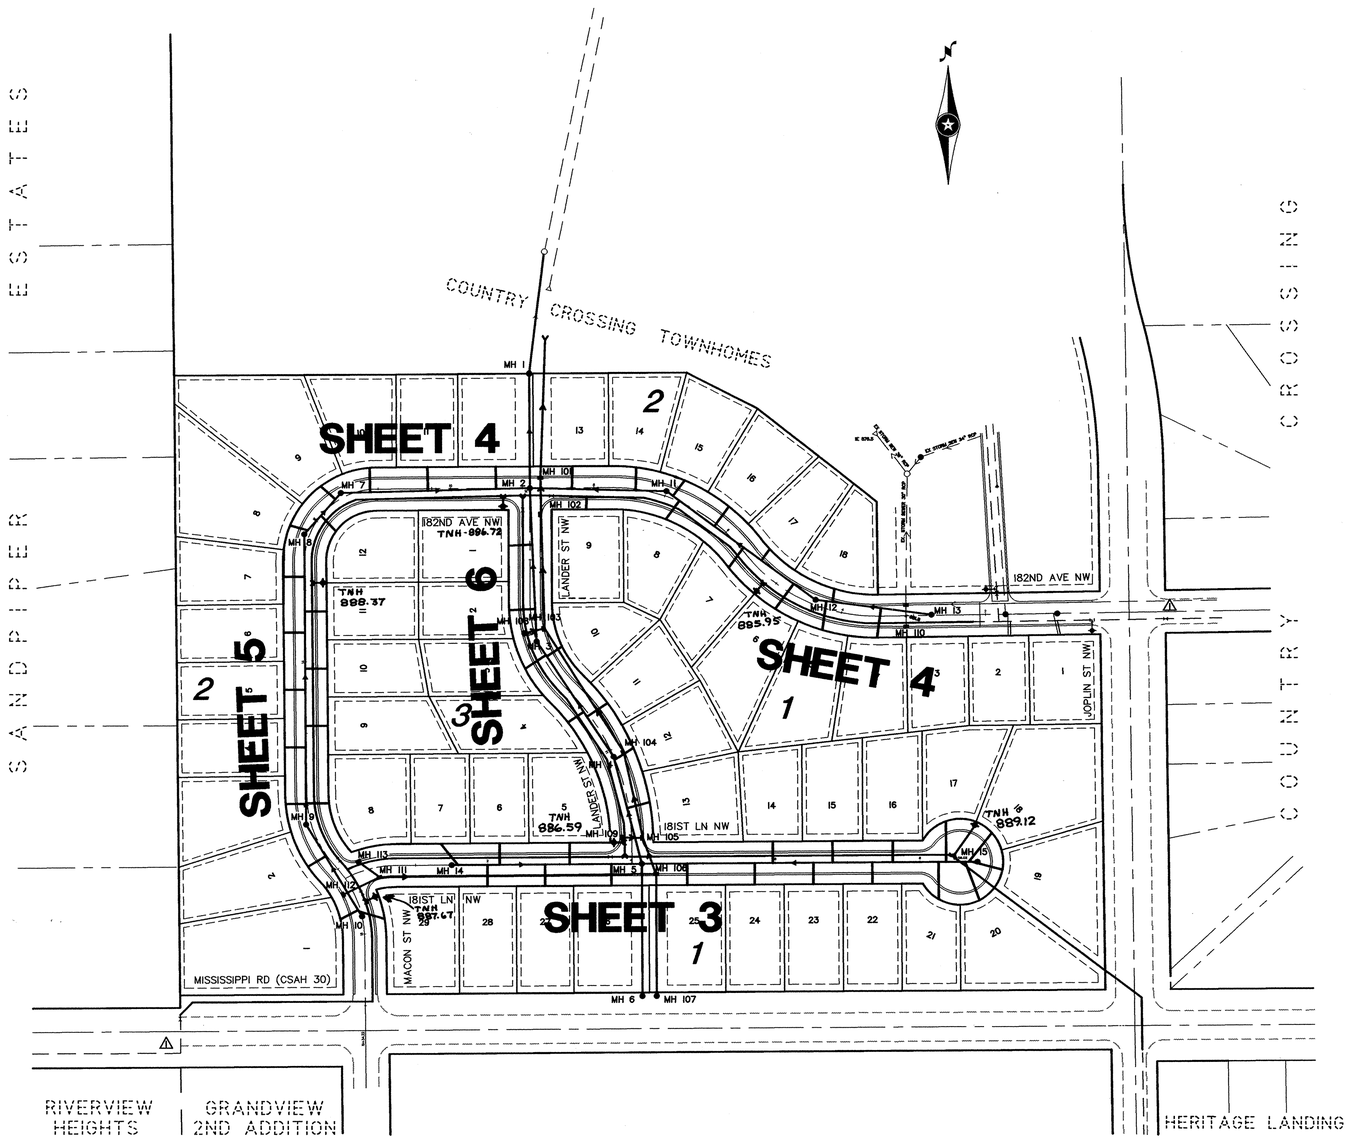


TYPICAL STREET SECTION

| REV NO. | DATE | DESCRIPTION |
|---|---|---|
| 1 | 02/29/96 | EX. WM LOCATION REVISED |
| | 12/7/96 | RECORD DRAWINGS |

DATE: 11/02/95
DESIGN BY: TM
DRAWN BY: BG
CHECKED BY: TM
DWG. FILE: CC2INDEX
TEXT FILE:
FILE NO.: 6719.20-03

I hereby certify that this plan was prepared by me or under my direct supervision and that I am a duly Registered Professional Engineer under the laws of the State of Minnesota.

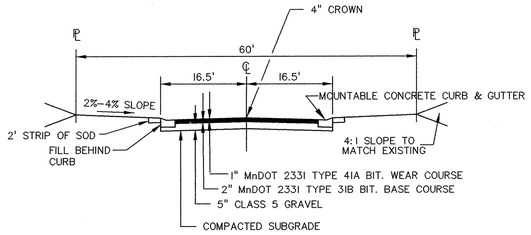Signed: [signature]
Date: 12/05/95 Reg. No. 20383


John Oliver & Associates, Inc.
Civil Engineering, Land Surveying, Land Planning
580 Dodge Avenue
Elk River, Minnesota
(612)441-2072 (FAX)441-5665
201 W. Travelers Trail, Suite 200
Burnsville, MN 55337
(612)894-3045 (FAX)894-3049


COUNTRY CROSSING
SECOND ADDITION
SHEET INDEX

SHEET NO. 2 OF 9

DRAWING NUMBER
COUNT2.96
2

1028