LANDER ST NW

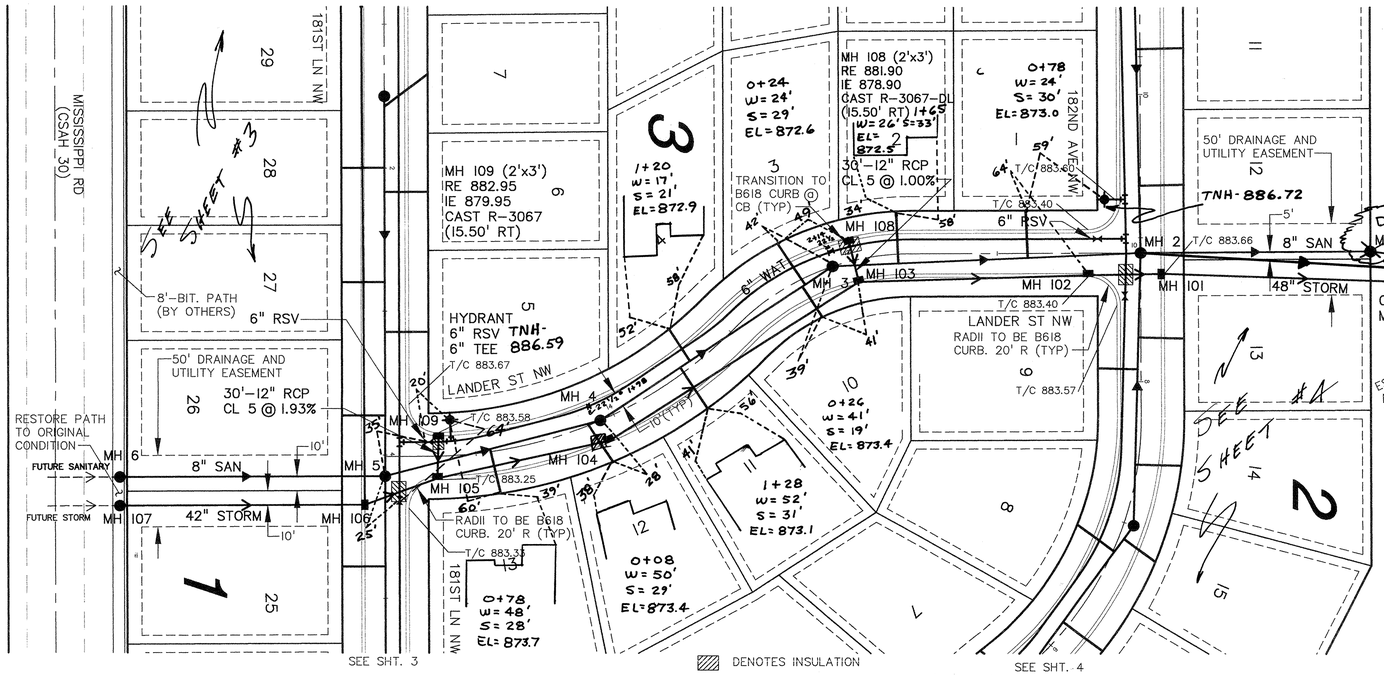

NOTE: CENTERLINE STREET ELEVATIONS WERE NOT SHOT AFTER CONSTRUCTION.

RECORD DRAWINGS

PRIME CONTRACTOR/UTILITIES: C.W. HOULE, INC.
CURB & GUTTER: HALVORSON CURB CO.
STREETS: BAUERLY BROS., INC.
FIELD PROJECT MANAGER: FRED FRITSCHEL, JOA
INSPECTION: RALPH BADER, MSA CONSULTING ENGINEERS
SURVEY: JOHN OLIVER & ASSOCIATES, INC.
EARTHWORK: DENNIS FEHN EXCAVATING, INC.
RECORD DRAWINGS: FRED FRITSCHEL, JOA
CONSTRUCTED: 1996

NOTE:
- SANITARY SEWER SERVICE ELEVATIONS ARE INVERT AT THE 45 DEGREE BEND
- SANITARY SEWER SERVICE WYES STATIONED FROM DOWNSTREAM MANHOLE, BEING 0+00
- SERVICE TIES ARE TO WATER CURB STOP
- SANITARY SEWER SERVICES ARE 4" PVC AND HAVE A 5' +/- RISER ON END
- WATER SERVICES ARE 1" COPPER

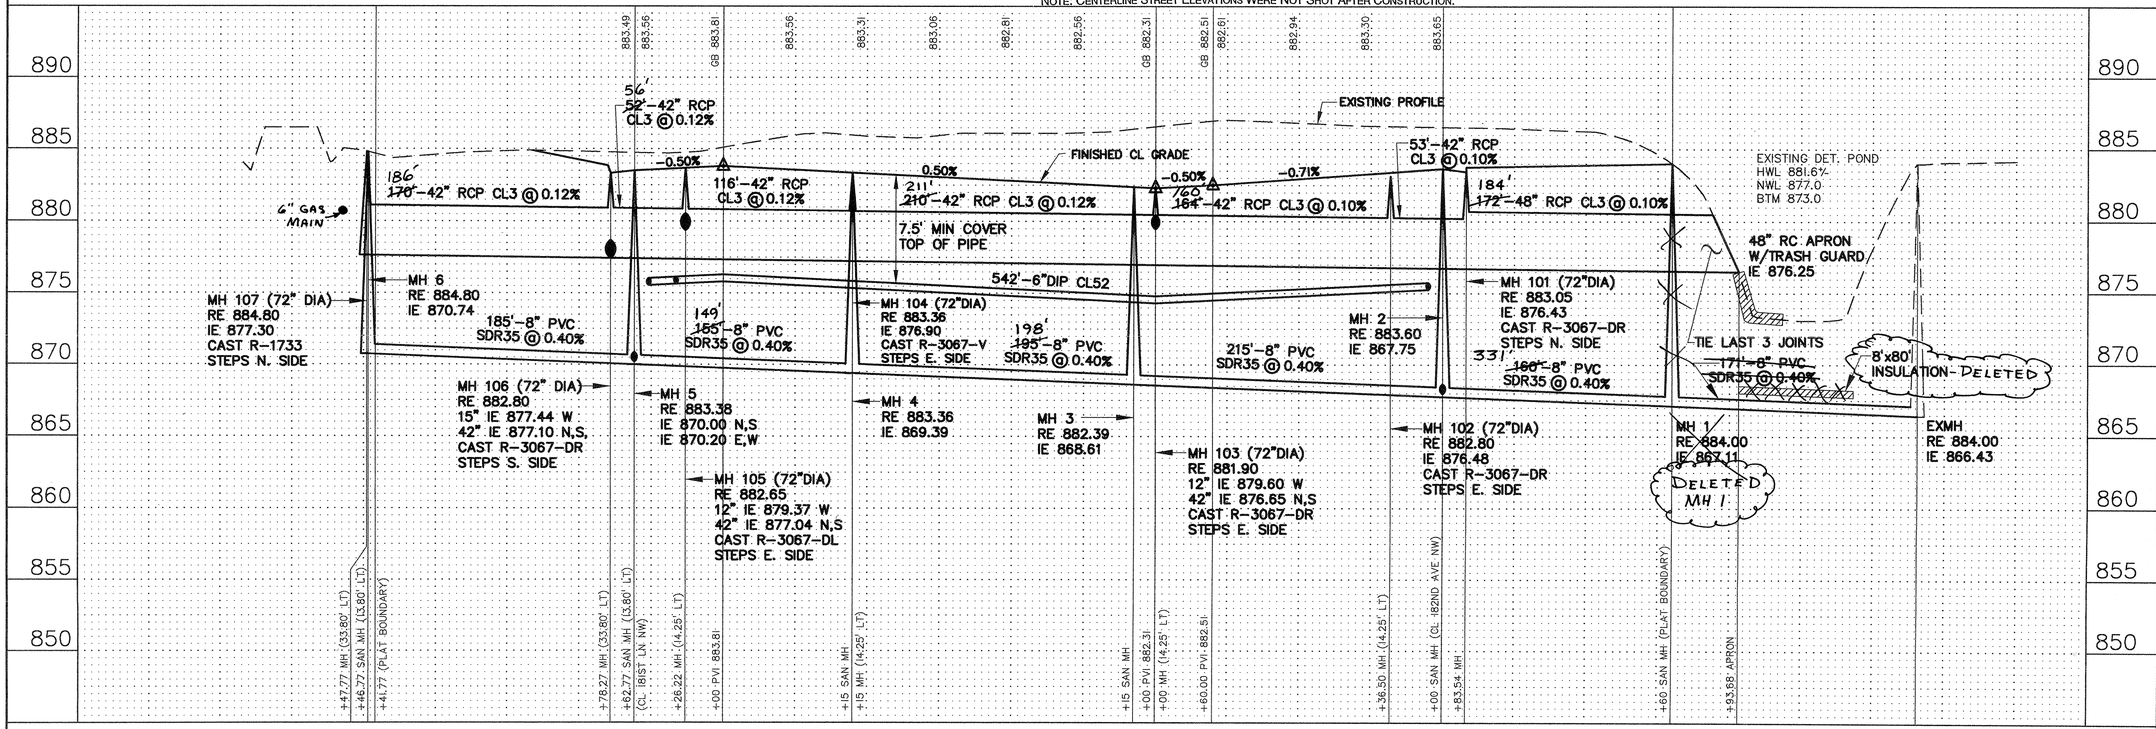

REV NO.	DATE	DESCRIPTION
	1-8-97	Record Drawing

DATE: 11/02/95
DESIGN BY: TWM
DRAWN BY: BG
CHECKED BY: TWM
DWG FILE: CC2-LAN.
TEXT FILE: NONE
FILE NO.: 7169.20-03

I hereby certify that this plan was prepared by me or under my direct supervision and that I am a duly Registered Professional Engineer under the laws of the State of Minnesota.

Signed: [signature]
Date: 12/05/95 Reg. No. 20383

John Oliver & Associates, Inc.
Civil Engineering, Land Surveying, Land Planning
580 Dodge Avenue
Elk River, Minnesota
(612)441-2072 (FAX)441-5665
201 W. Travelers Trail, Suite 200
Burnsville, MN 55337
(612)894-3045 (FAX)894-3049

COUNTRY CROSSING SECOND ADDITION
ELK RIVER, MN
COUNTRY RIDGE PARTNERSHIP
SANITARY SEWER, WATERMAIN, STREET AND STORM SEWER PLAN

SHEET NO. 6 OF 9

DRAWING NUMBER COUNT2.96 6

DRAWING NUMBER
SAFCO PRODUCTS • NEW HOPE, MINNESOTA
REORDER BY PART NUMBER 6582