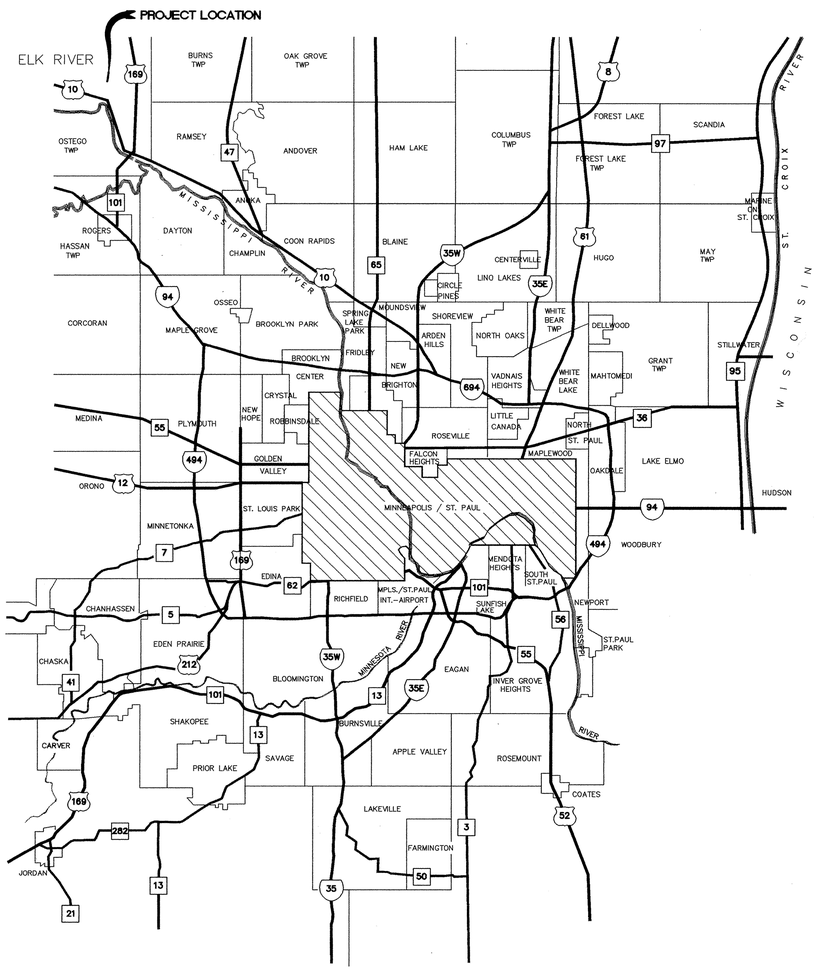

LOCATION MAP

COUNTRY CROSSING

SANITARY SEWER, WATERMAIN AND STREET IMPROVEMENTS

I HEREBY CERTIFY THAT THIS PLAN, SPECIFICATION, OR REPORT WAS PREPARED BY ME OR UNDER MY DIRECT SUPERVISION AND THAT I AM A DULY REGISTERED PROFESSIONAL ENGINEER UNDER THE LAWS OF THE STATE OF MINNESOTA.

Mark V. Graham

DATE 7/27/94 REG.NO. 19130

MSA
CONSULTING ENGINEERS

1326 ENERGY PARK DRIVE
ST. PAUL, MINNESOTA 55108
(612) 644-4389

9800 SHELARD PARKWAY
MINNEAPOLIS, MINNESOTA 55441
(612) 546-0432

PREPARED FOR:

City of Elk River

RECORD PLAN
NOVEMBER 1994

ER194-T

Wed Jul 27 18:33:33 1994

757

DRAWING NUMBER
COUNT1.94
1

SAFCO PRODUCTS • NEW HOPE, MINNESOTA
REORDER BY PART NUMBER 65552