


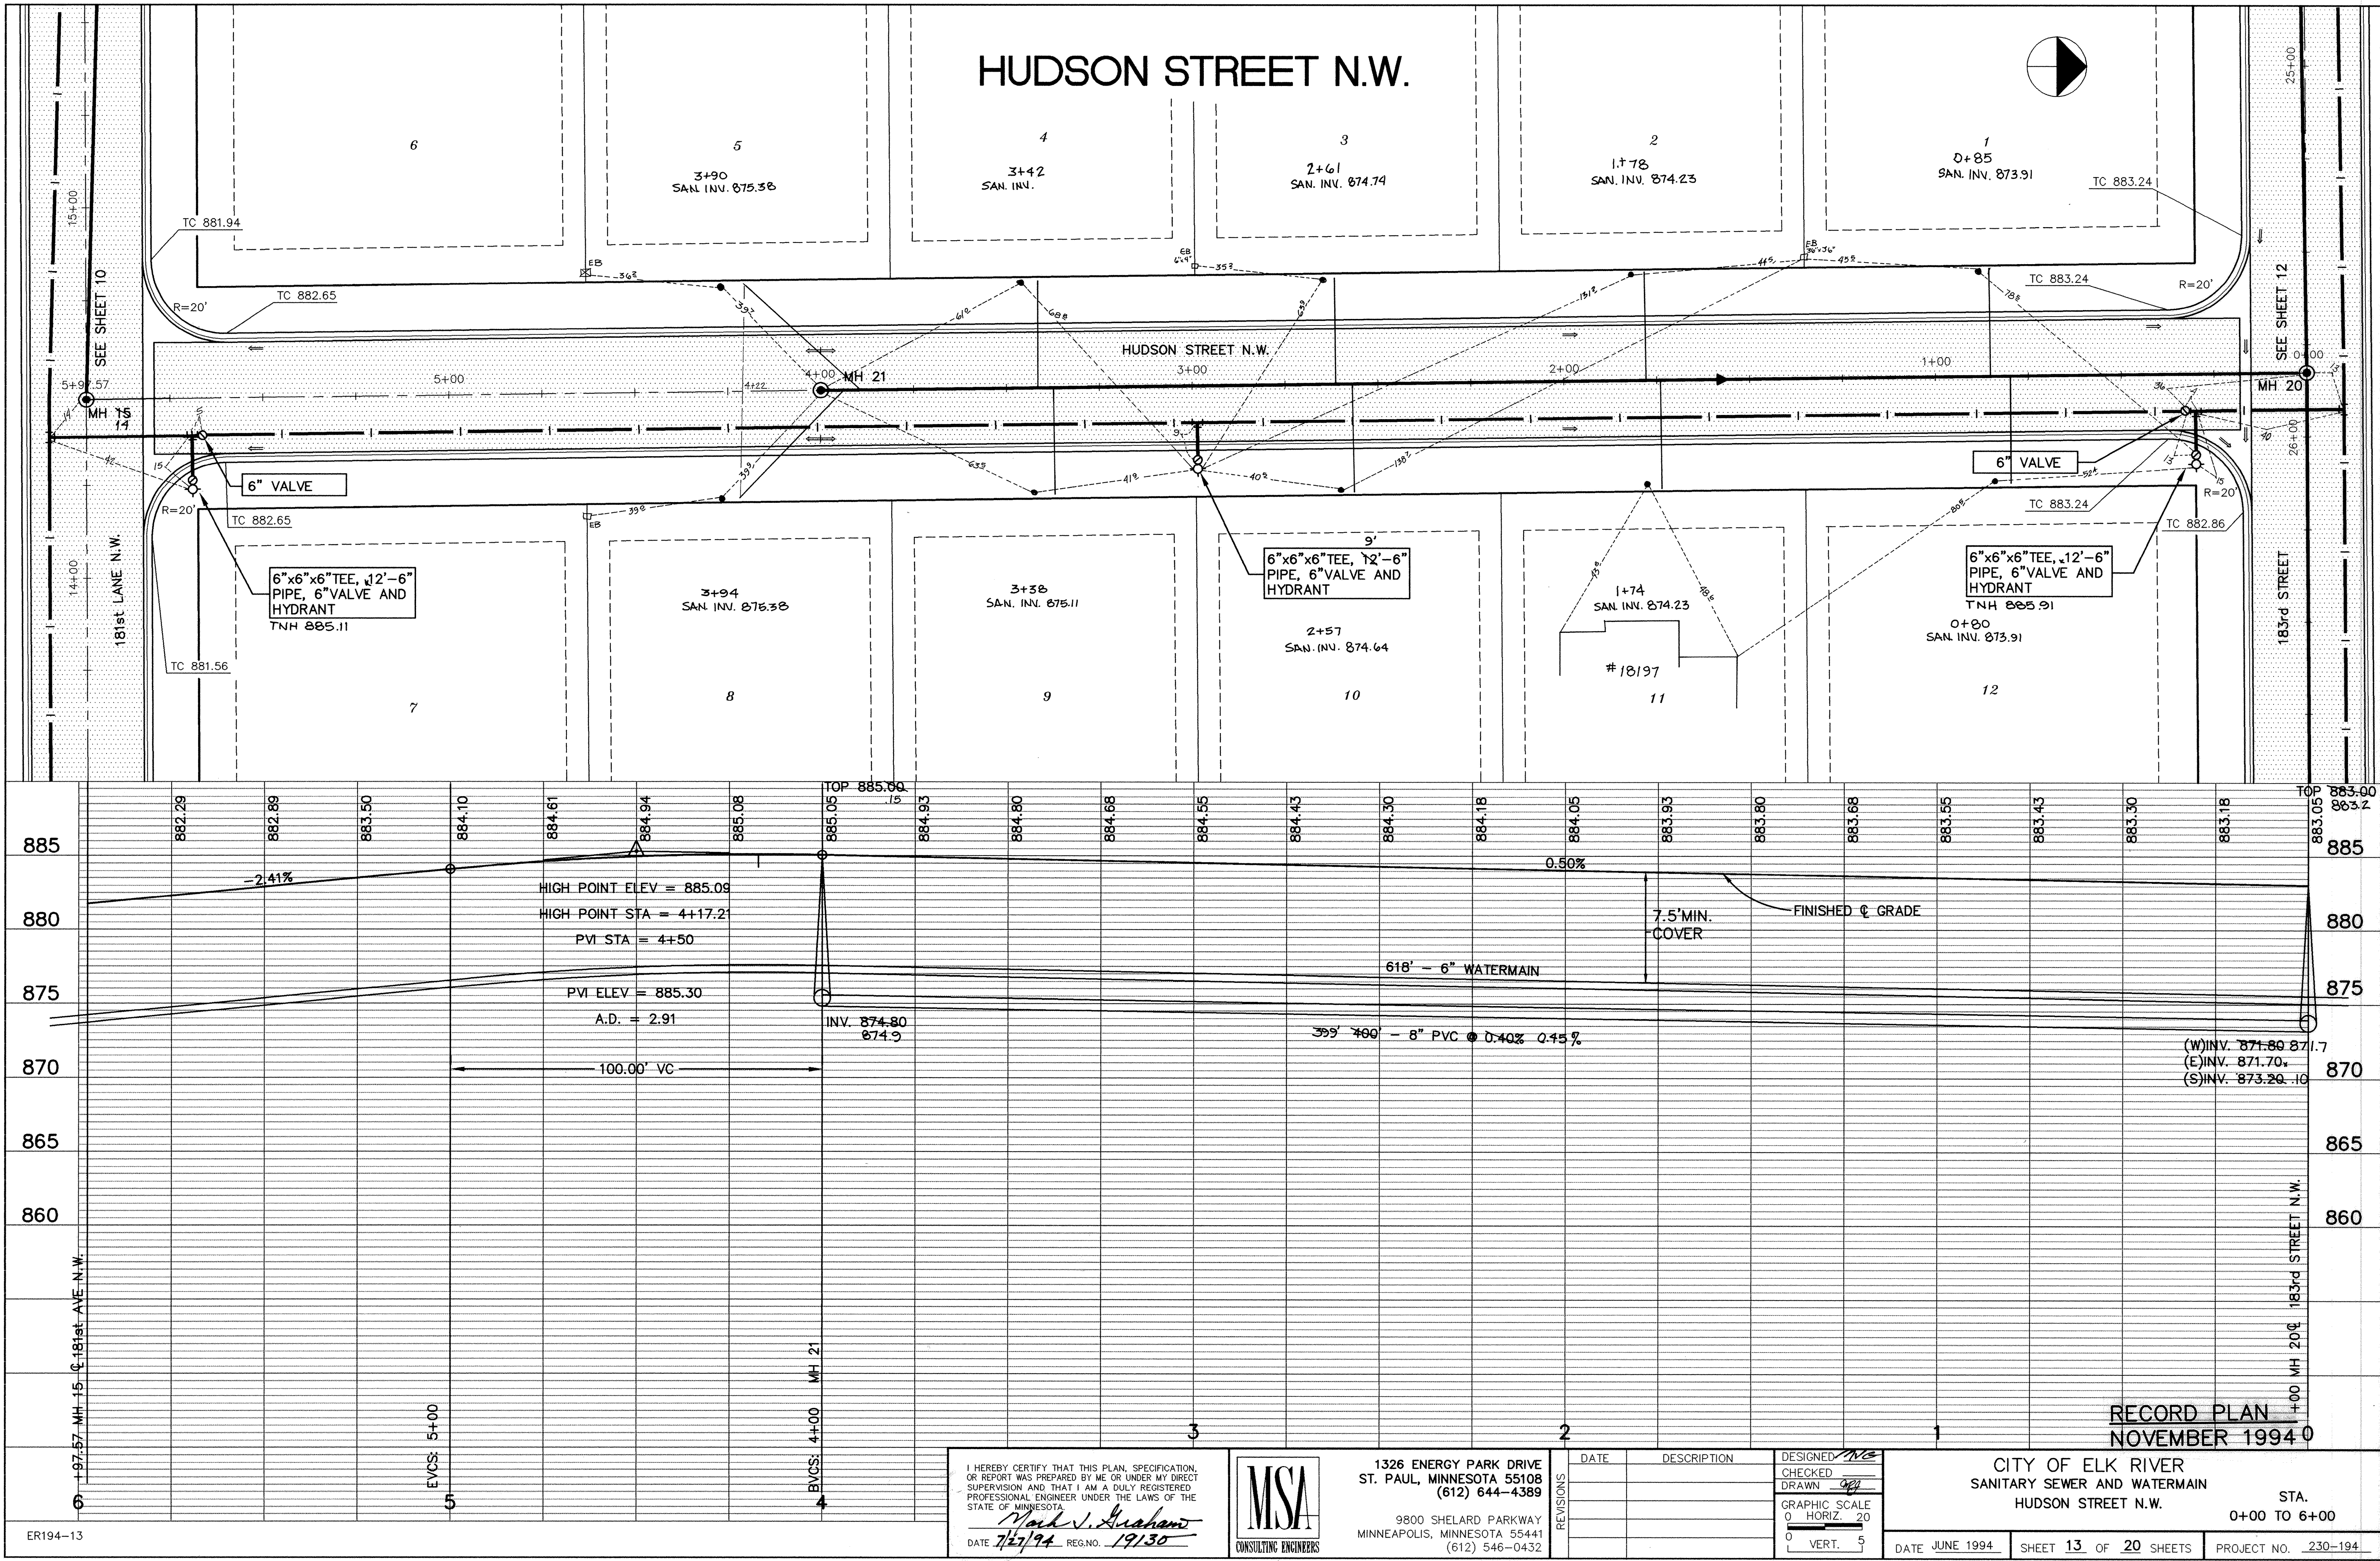

I HEREBY CERTIFY THAT THIS PLAN, SPECIFICATION, OR REPORT WAS PREPARED BY ME OR UNDER MY DIRECT SUPERVISION AND THAT I AM A DULY REGISTERED PROFESSIONAL ENGINEER UNDER THE LAWS OF THE STATE OF MINNESOTA.

*Mark S. Graham*

DATE 7/27/94 REG. NO. 19130

**MSA**

CONSULTING ENGINEERS

1326 ENERGY PARK DRIVE  
ST. PAUL, MINNESOTA 55108  
(612) 644-4389

9800 SHELARD PARKWAY  
MINNEAPOLIS, MINNESOTA 55441  
(612) 546-0432

| REVISIONS | DATE | DESCRIPTION |
|-----------|------|-------------|
| 1         |      |             |
| 2         |      |             |

DESIGNED: *MS*

CHECKED: *MS*

DRAWN: *MS*

GRAPHIC SCALE  
0 HORIZ. 20  
0 VERT. 5

**CITY OF ELK RIVER**

SANITARY SEWER AND WATERMAIN

HUDSON STREET N.W.

STA. 0+00 TO 6+00

DATE JUNE 1994 SHEET 13 OF 20 SHEETS PROJECT NO. 230-194