

DRAWING NUMBER

DRAWING NUMBER

DRAWING NUMBER

DRAWING NUMBER

STANDARD PRODUCTS • NEW HAVEN, CONNECTICUT
REPRODUCTION BY PLANT NUMBER 6503

STANDARD PRODUCTS • NEW HAVEN, CONNECTICUT
REPRODUCTION BY PLANT NUMBER 6503


STANDARD PRODUCTS • NEW HAVEN, CONNECTICUT
REPRODUCTION BY PLANT NUMBER 6503

STANDARD PRODUCTS • NEW HAVEN, CONNECTICUT
REPRODUCTION BY PLANT NUMBER 6503

192ND AVENUE


US HIGHWAY NO 169

EDGE BIT. SHOULDER LANE

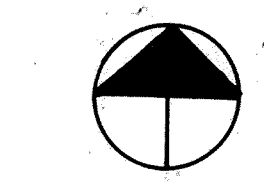

DEERFIELD
9

PARK
3RD
10
ADD.

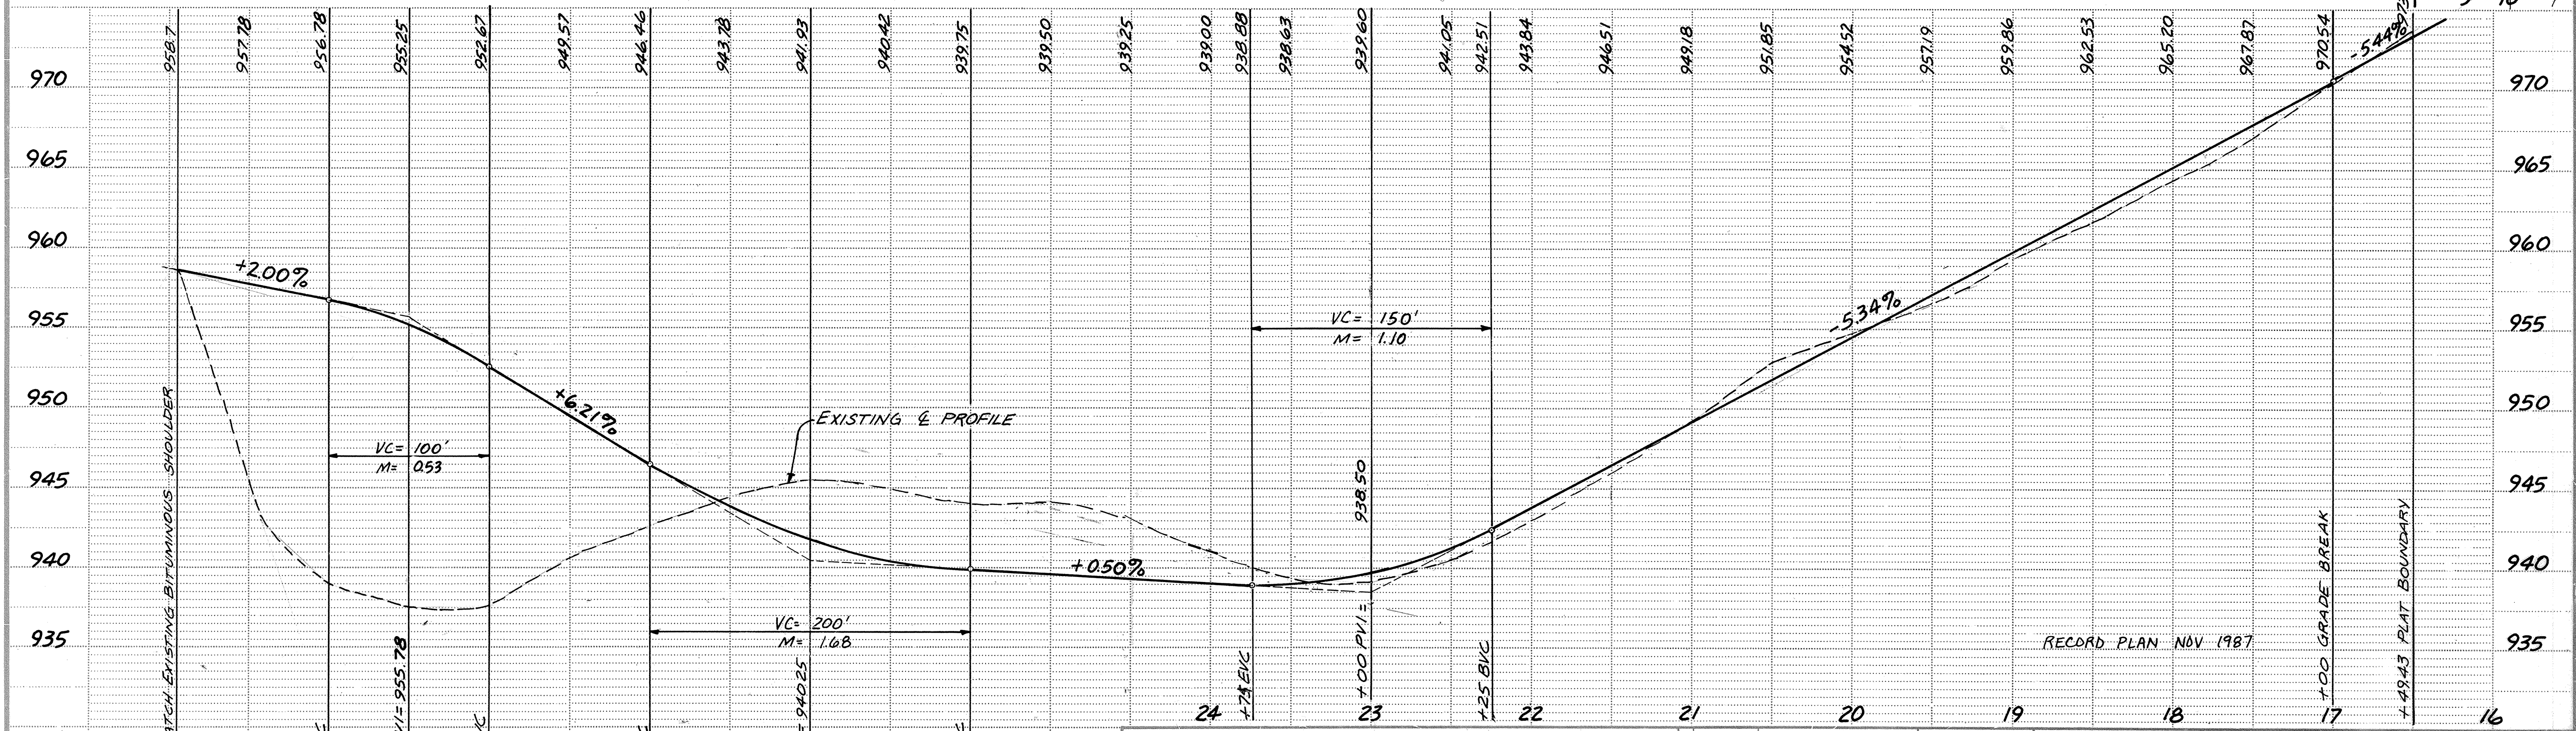

CONSULTING ENGINEERS
Maier Stewart & Associates Inc.

480 CEDAR STREET (612) 227-9475 ST. PAUL, MINNESOTA 55101

REVISIONS	DATE	DESCRIPTION

DESIGNED	
CHECKED	
DRAWN	MRJ
GRAPHIC SCALE	
0 HORIZ. 50	
0 VERT. 5	

CITY OF ELK RIVER	
STREET CONSTRUCTION	
192ND AVENUE	
DATE APRIL 1987	SHEET 28A OF 31 SHEETS
PROJECT NO 230-720	