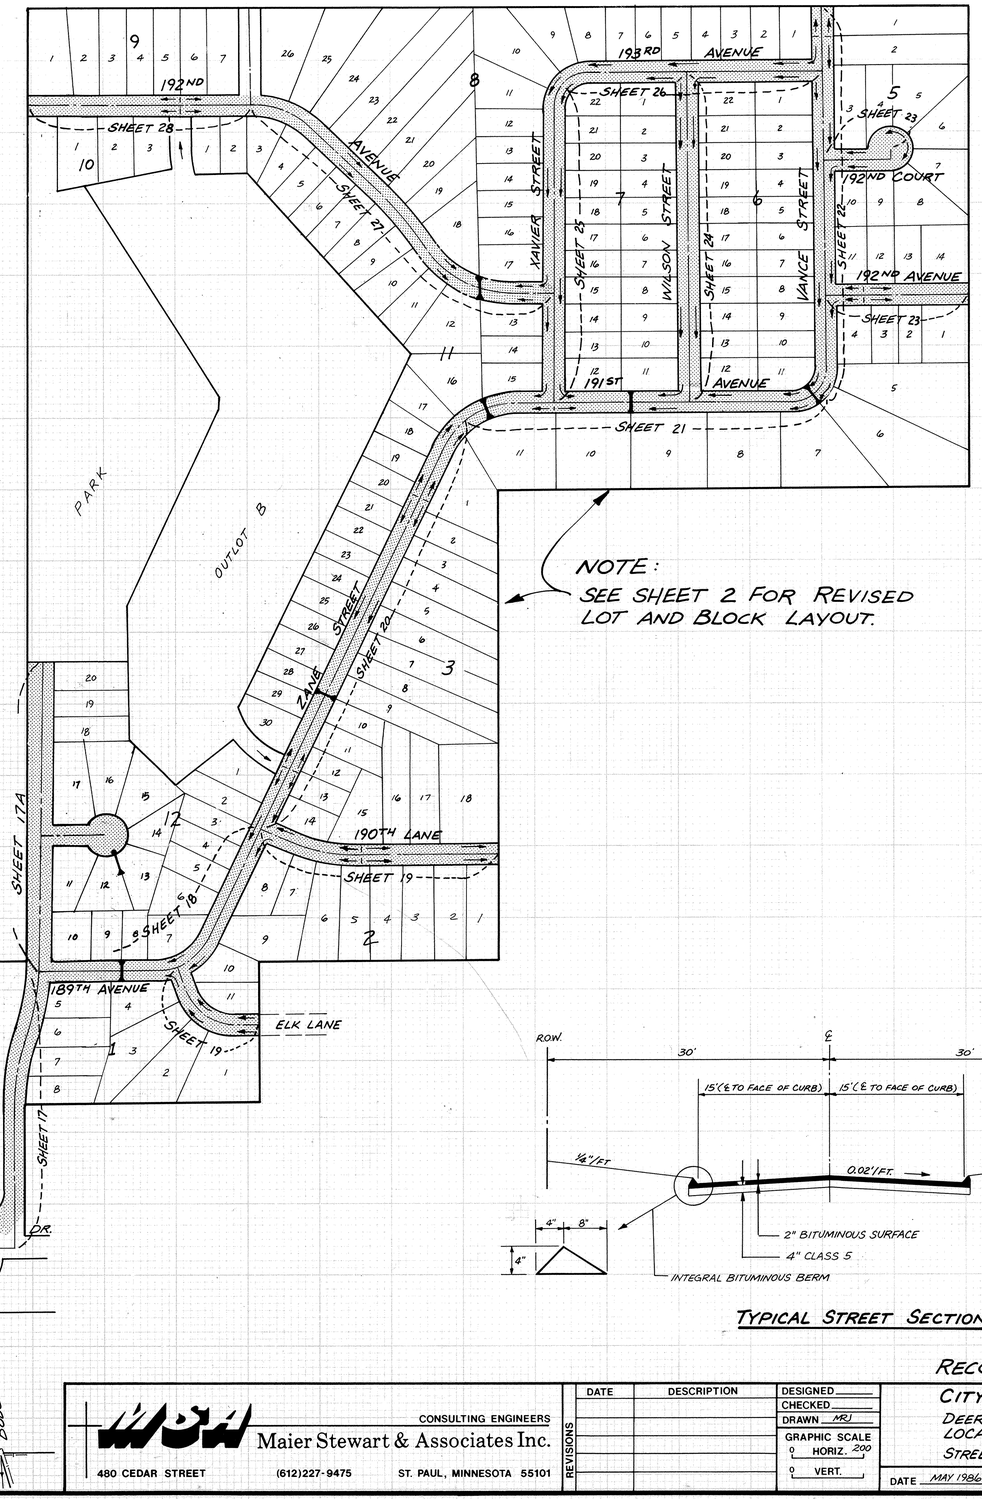

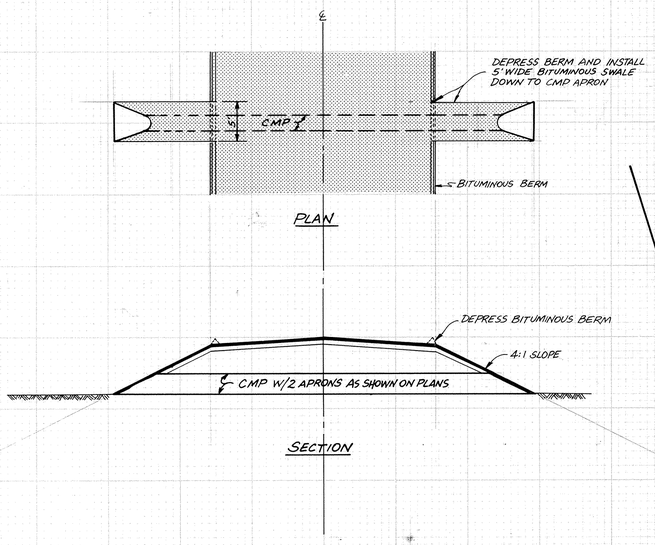

TYPICAL CMP INSTALLATION

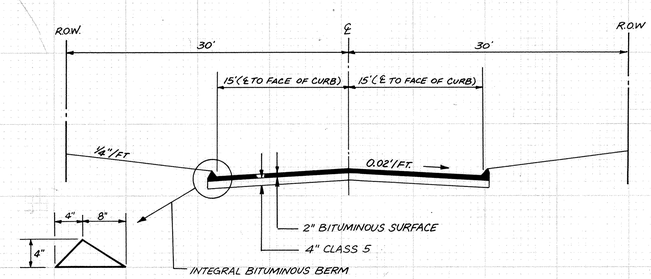

TYPICAL STREET SECTION

RECORD PLAN ~~DEC.~~ NOV. 1987 1986

MSA
Maier Stewart & Associates Inc.
CONSULTING ENGINEERS
480 CEDAR STREET (612)227-9475 ST. PAUL, MINNESOTA 55101

REVISIONS	DATE	DESCRIPTION

DESIGNED
CHECKED
DRAWN MRJ
GRAPHIC SCALE
0 HORIZ. 200
0 VERT.

CITY OF ELK RIVER
DEERFIELD 3RD ADDITION
LOCATION MAP
STREET AND STORM DRAINAGE

DATE MAY 1986 | SHEET 3 OF 31 SHEETS | PROJECT NO. 230-020

172

DRAWING NUMBER
DRAWING NUMBER
DRAWING NUMBER
DEERF3.86
3

MINNESOTA BLUEPRINT