


AUBURN STREET

192ND AVENUE

NOT
CONTRACT

30 SEE THIS SHEET

SEE SHEET 2

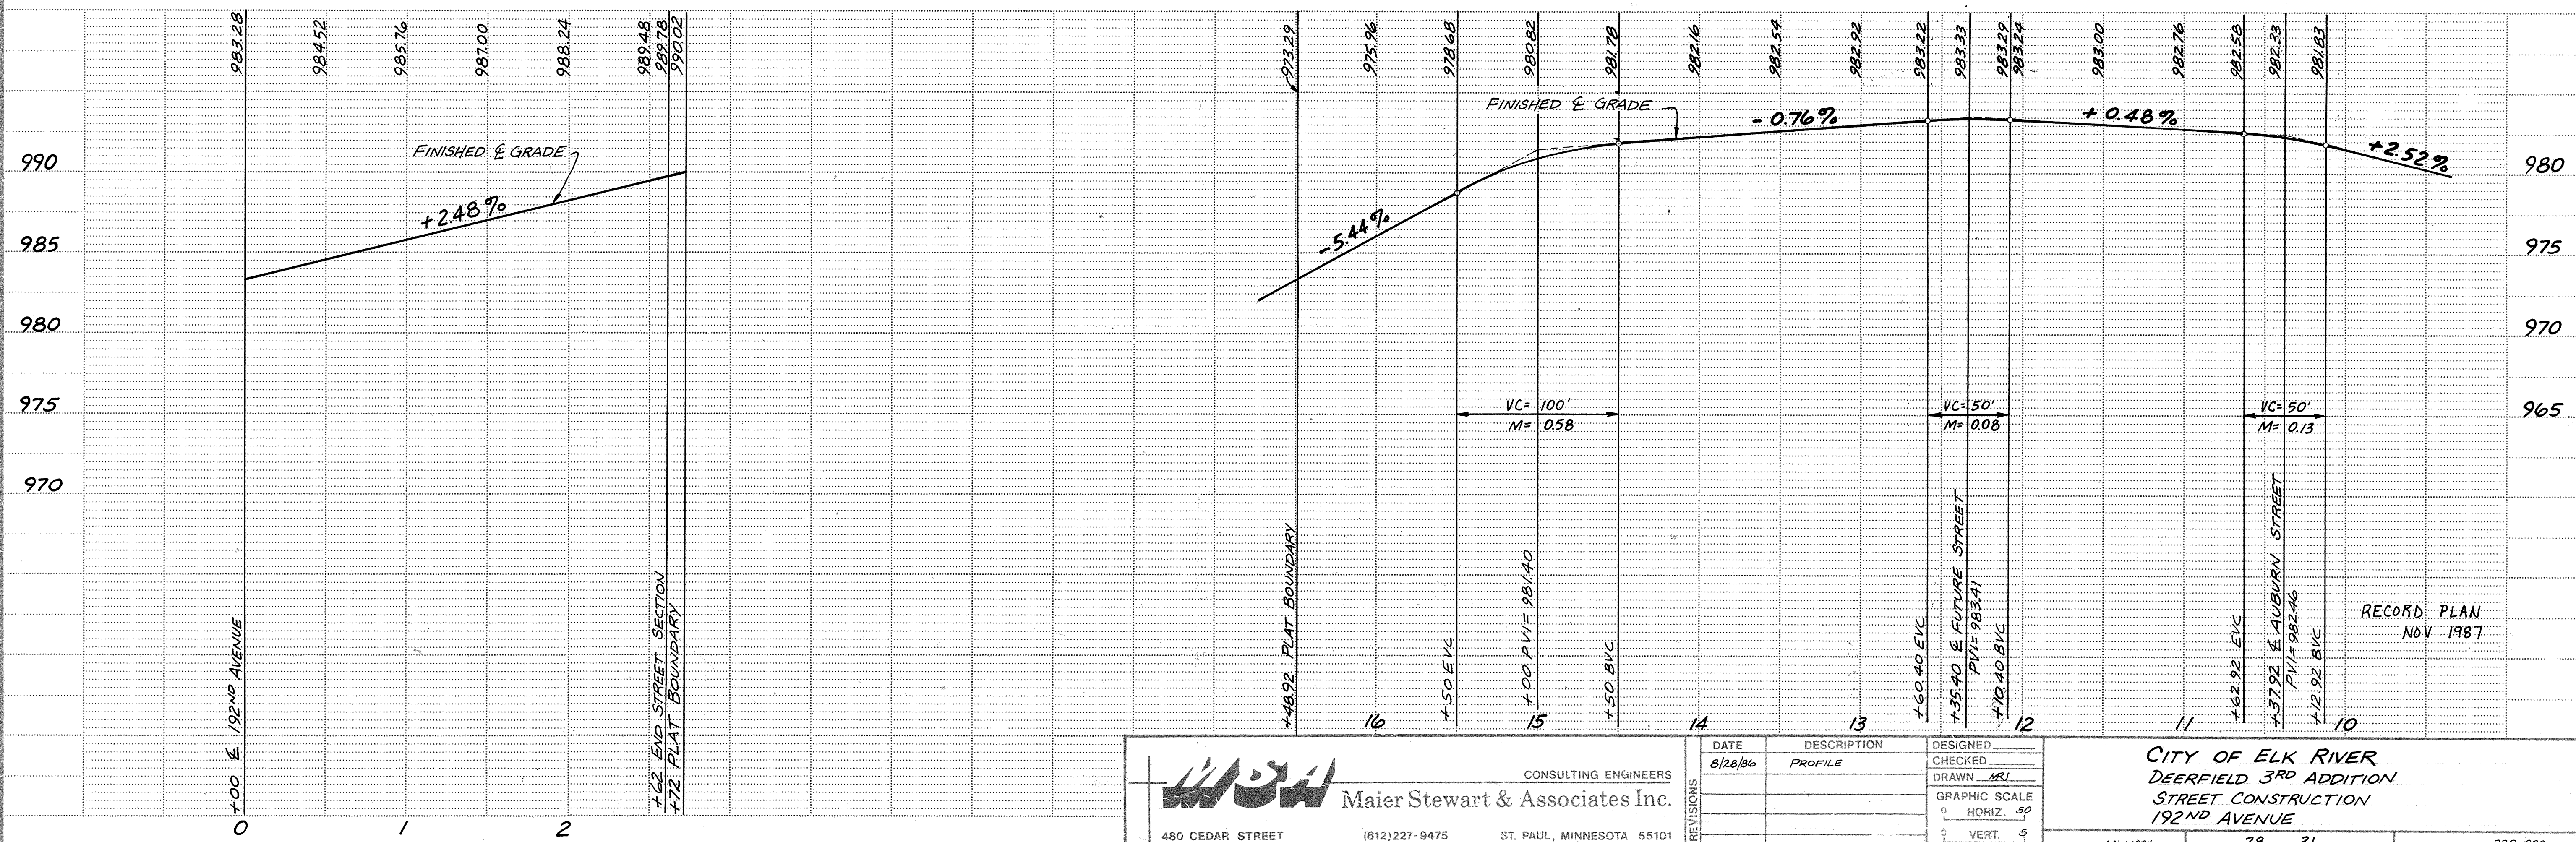

CITY OF ELK RIVER
DEERFIELD 3RD ADDITION
STREET CONSTRUCTION
192ND AVENUE

DATE MAY 1986 SHEET 28 OF 31 SHEETS PROJECT NO. 230-020

145