


DATE July 1989 SHEET 8 of 16 SHEETS PROJECT NO. 230-073  
 DESIGNED: [ ]  
 CHECKED: [ ]  
 DRAWN: [ ]  
 GRAPHIC SCALE: 1" = 100'  
 HORIZ. SCALE: 1" = 100'  
 VERT. SCALE: 1" = 100'

DATE	DESCRIPTION
12-17-89	Final Limits

1959 SLOAN PLACE  
 Mather Stewart & Associates Inc.  
 CONSULTING ENGINEERS  
 ST. PAUL, MINNESOTA 55117  
 (612) 774-6021

DATE 8/14/89 REG. NO. 15316  
 State of Minnesota  
 PROFESSIONAL ENGINEER UNDER THE LAWS OF THE STATE OF MINNESOTA  
 REPORT WAS PREPARED BY ME OR UNDER MY DIRECT SUPERVISION AND THAT I AM A DULY REGISTERED PROFESSIONAL ENGINEER UNDER THE LAWS OF THE STATE OF MINNESOTA

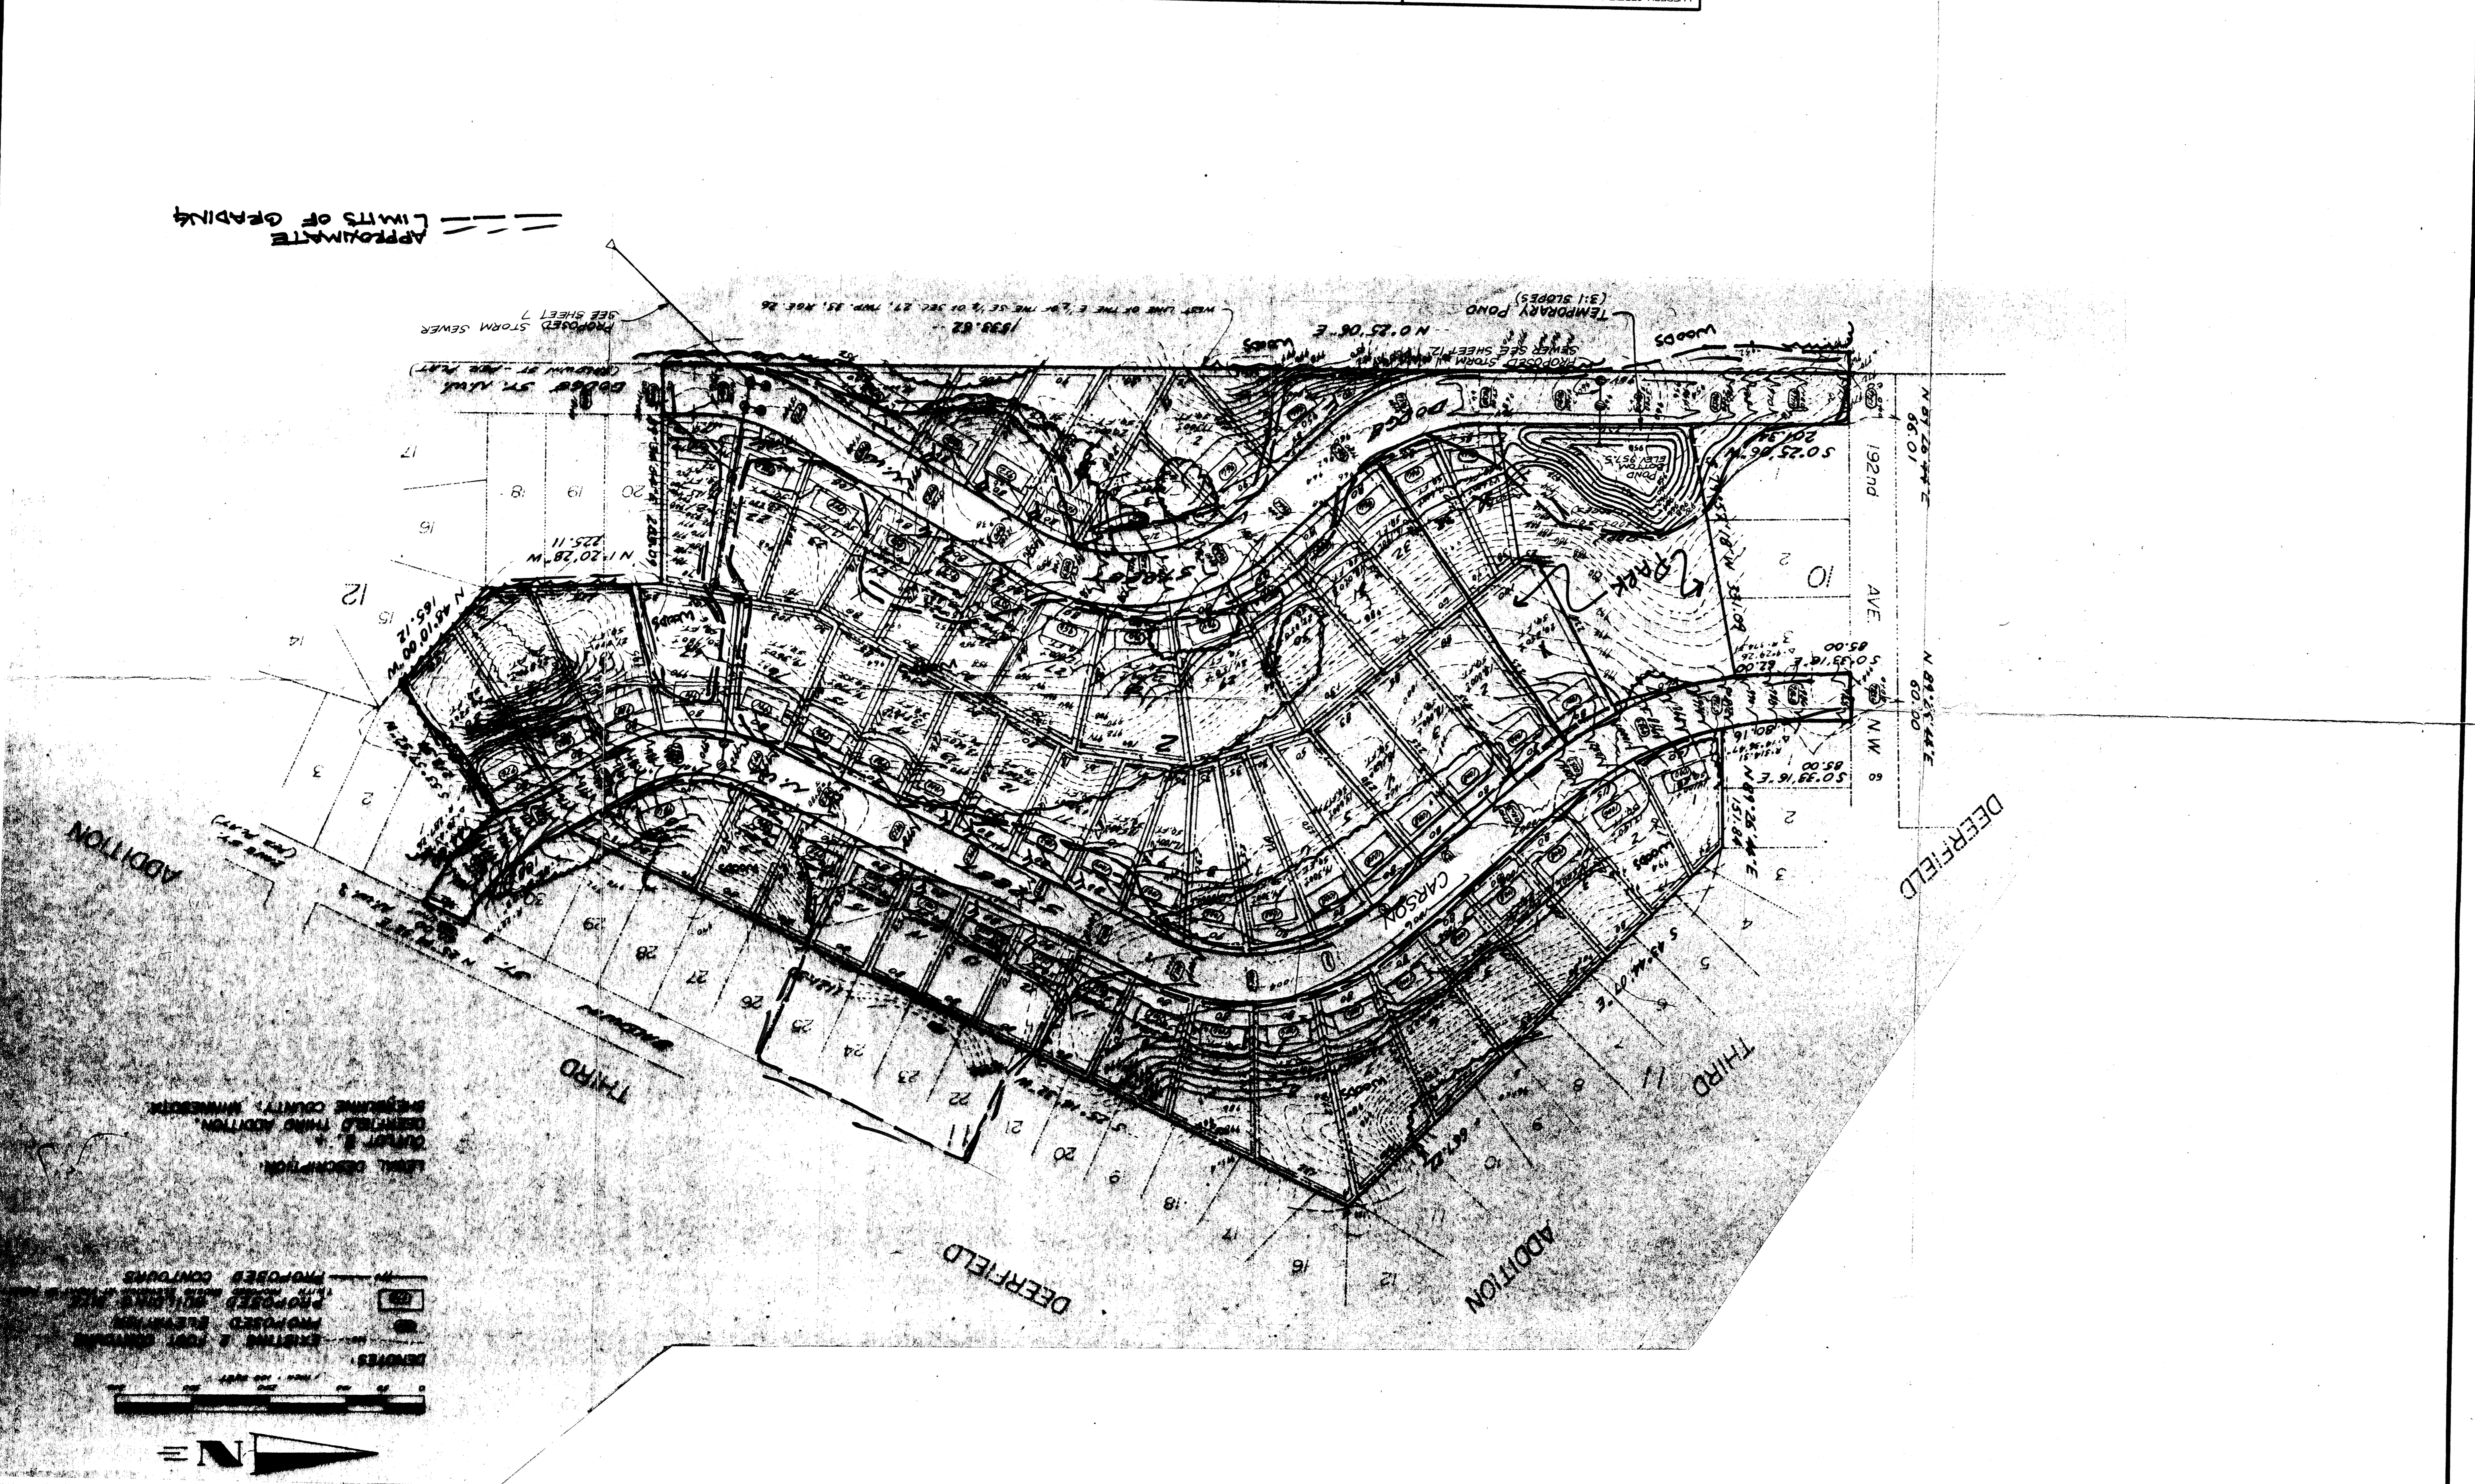

LEGEND:  
 PROPOSED CONTOURS  
 LEVEL DESCRIPTION:  
 DEERFIELD THIRD ADDITION  

Scale bar: 0 10 20 30 40 50 60 70 80 90 100  
 North arrow pointing up.

--- APPROXIMATE LIMITS OF GRADING