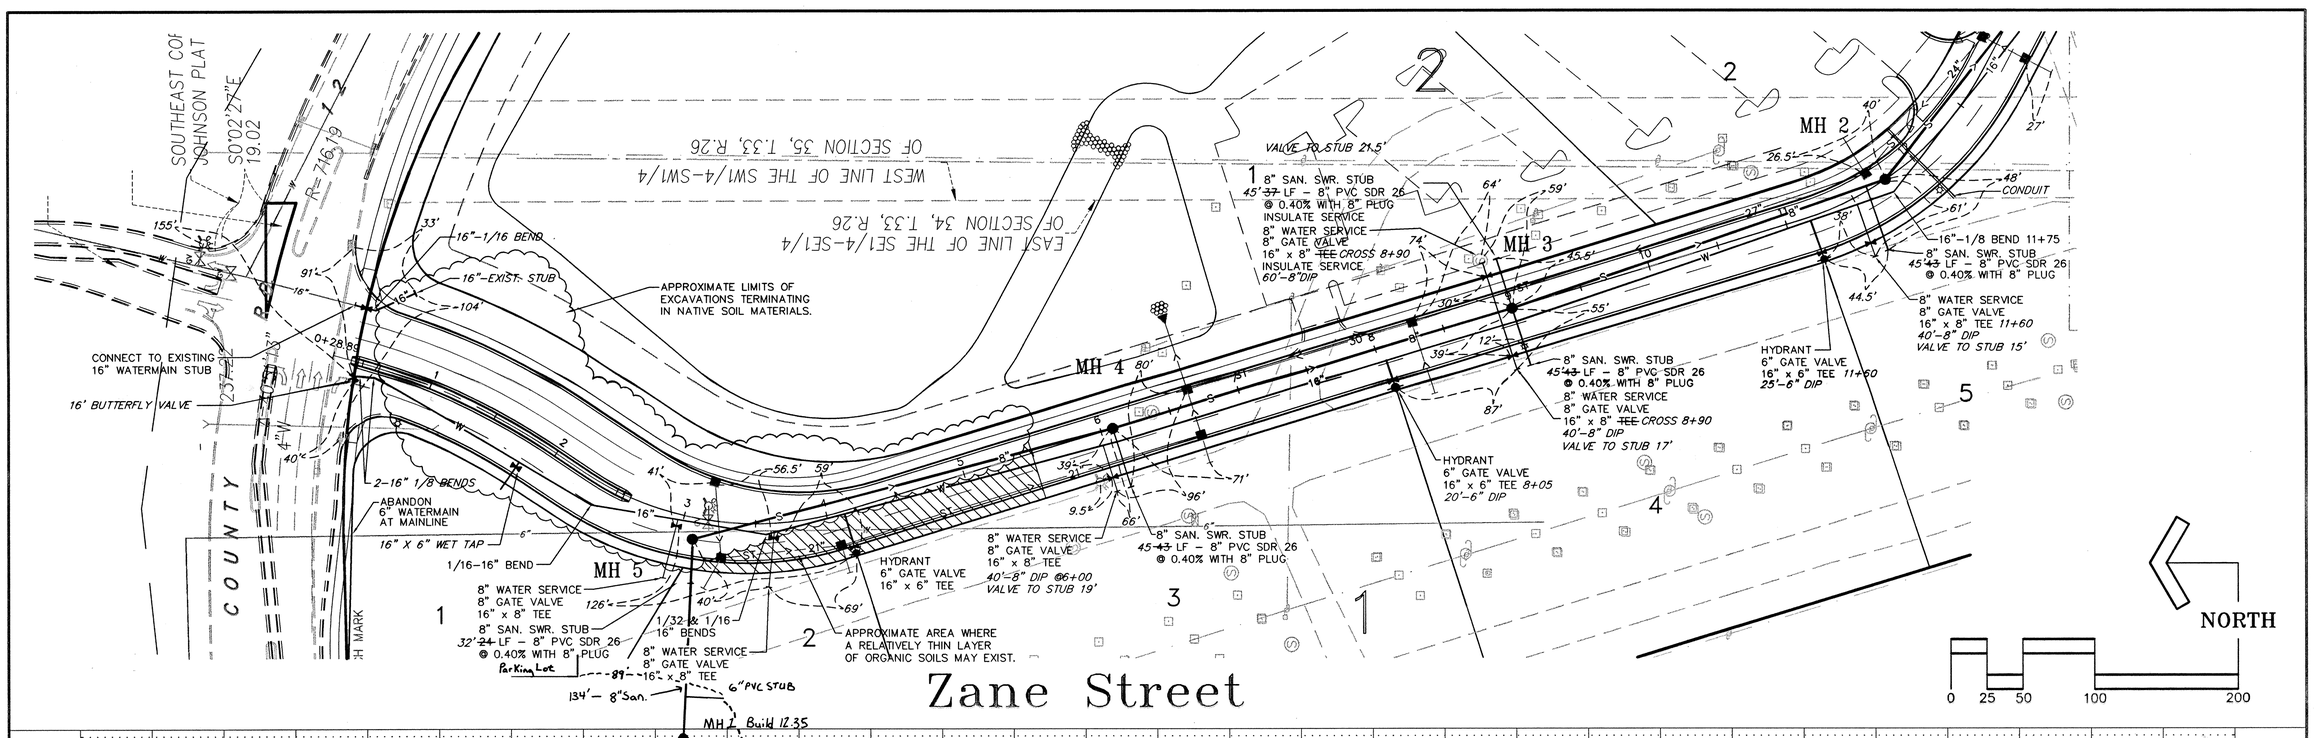

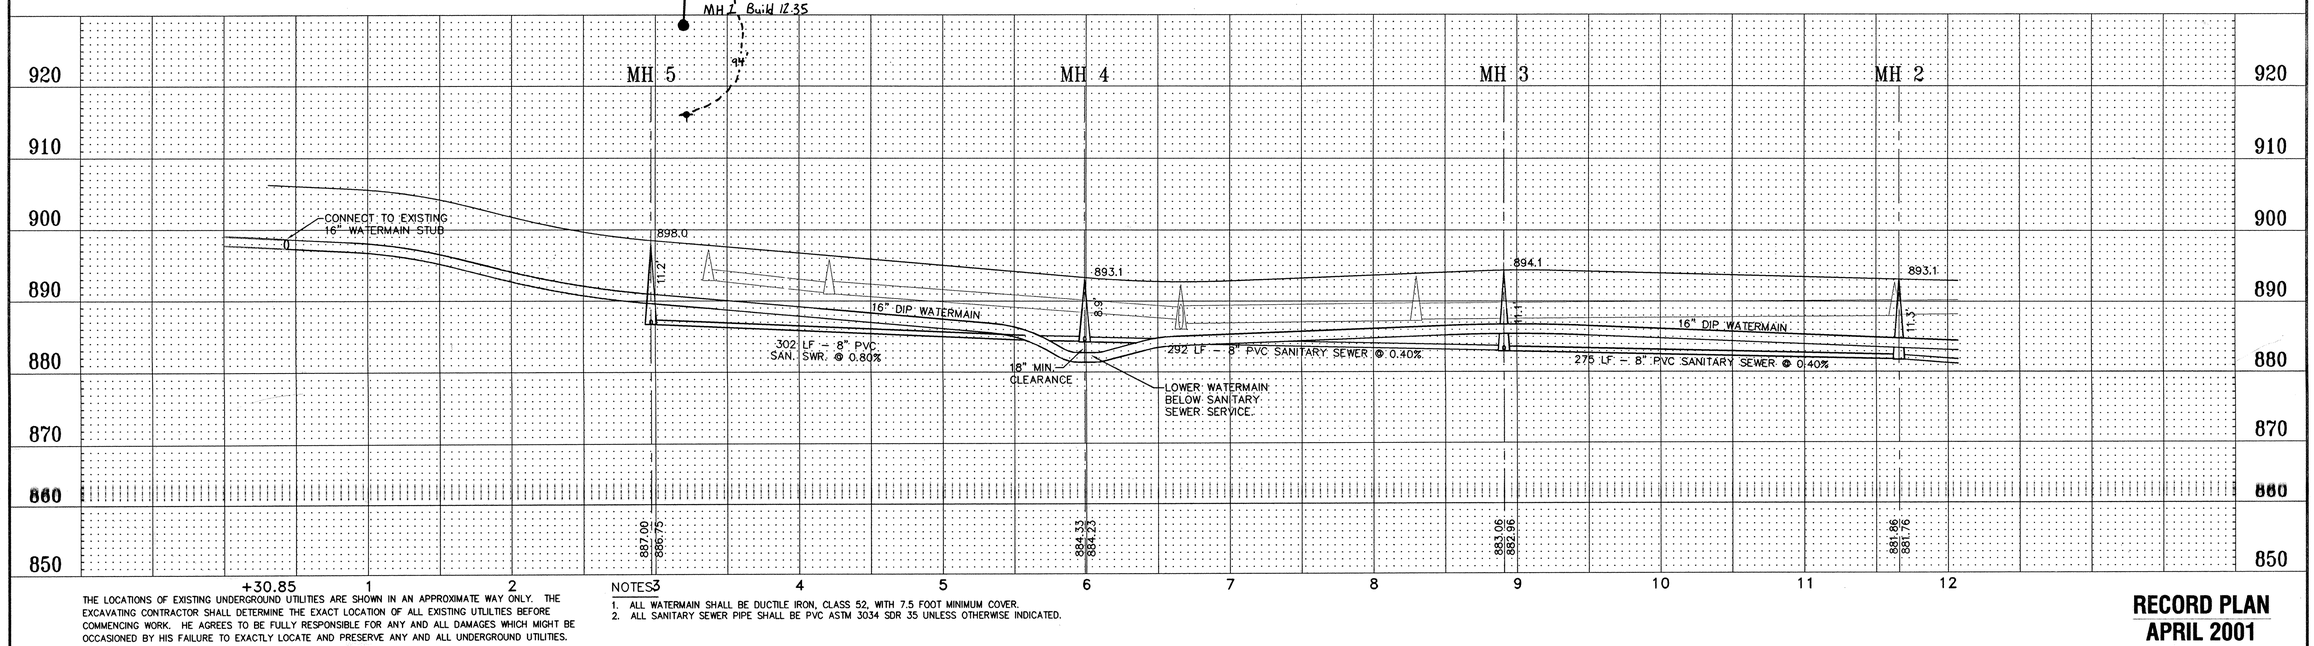

THE LOCATIONS OF EXISTING UNDERGROUND UTILITIES ARE SHOWN IN AN APPROXIMATE WAY ONLY. THE EXCAVATING CONTRACTOR SHALL DETERMINE THE EXACT LOCATION OF ALL EXISTING UTILITIES BEFORE COMMENCING WORK. HE AGREES TO BE FULLY RESPONSIBLE FOR ANY AND ALL DAMAGES WHICH MIGHT BE OCCASIONED BY HIS FAILURE TO EXACTLY LOCATE AND PRESERVE ANY AND ALL UNDERGROUND UTILITIES.

NOTES

1. ALL WATERMAIN SHALL BE DUCTILE IRON, CLASS 52, WITH 7.5 FOOT MINIMUM COVER.
2. ALL SANITARY SEWER PIPE SHALL BE PVC ASTM 3034 SDR 35 UNLESS OTHERWISE INDICATED.

RECORD PLAN
APRIL 2001

Revisions

No.	Date	By	Remarks
A	9/9/99	EWM	Revised per city comment
B	10/7/99	EWM	Revised San. MH 1,2 locations
C	11/18/99	EWM	Revised per city comment
D	2/28/00	EWM	Miscellaneous revisions
E	9/8/00	EWM	Rev. utilities per Zane Strt. re-alignment
F	9/25/00	EWM	Rev. MH 5 location
G	4/11/01	MRJ	Record Plan

I hereby certify that this plan was prepared by me or under my direct supervision and that I am a duly Registered Professional Engineer under the laws of the State of Minnesota:

Name David Nash — David J. Nash
Date 9/9/99
Registration Number 21836

Scale 1"=50'
Designed EWM
Drawn EWM
Date 8/2/99
Checked DJN
Approved

MFRA
McCombs Frank Roos Associates, Inc.

Engineering • Planning • Surveying

15050 23rd Avenue North • Plymouth, Minnesota • 55447
phone 612/476-6010 • fax 612/476-8532
E-Mail: cadd@mfra.com

Client
Associated Developers
Apple Valley, MN

Project
Elk River Crossing
Elk River, MN

Sheet Title
Sanitary Sewer and Watermain

Sheet 6/13 **Revision** G

MFRA FILE NO.: 10667

DRAWING NUMBER
ERCRO.99
6