






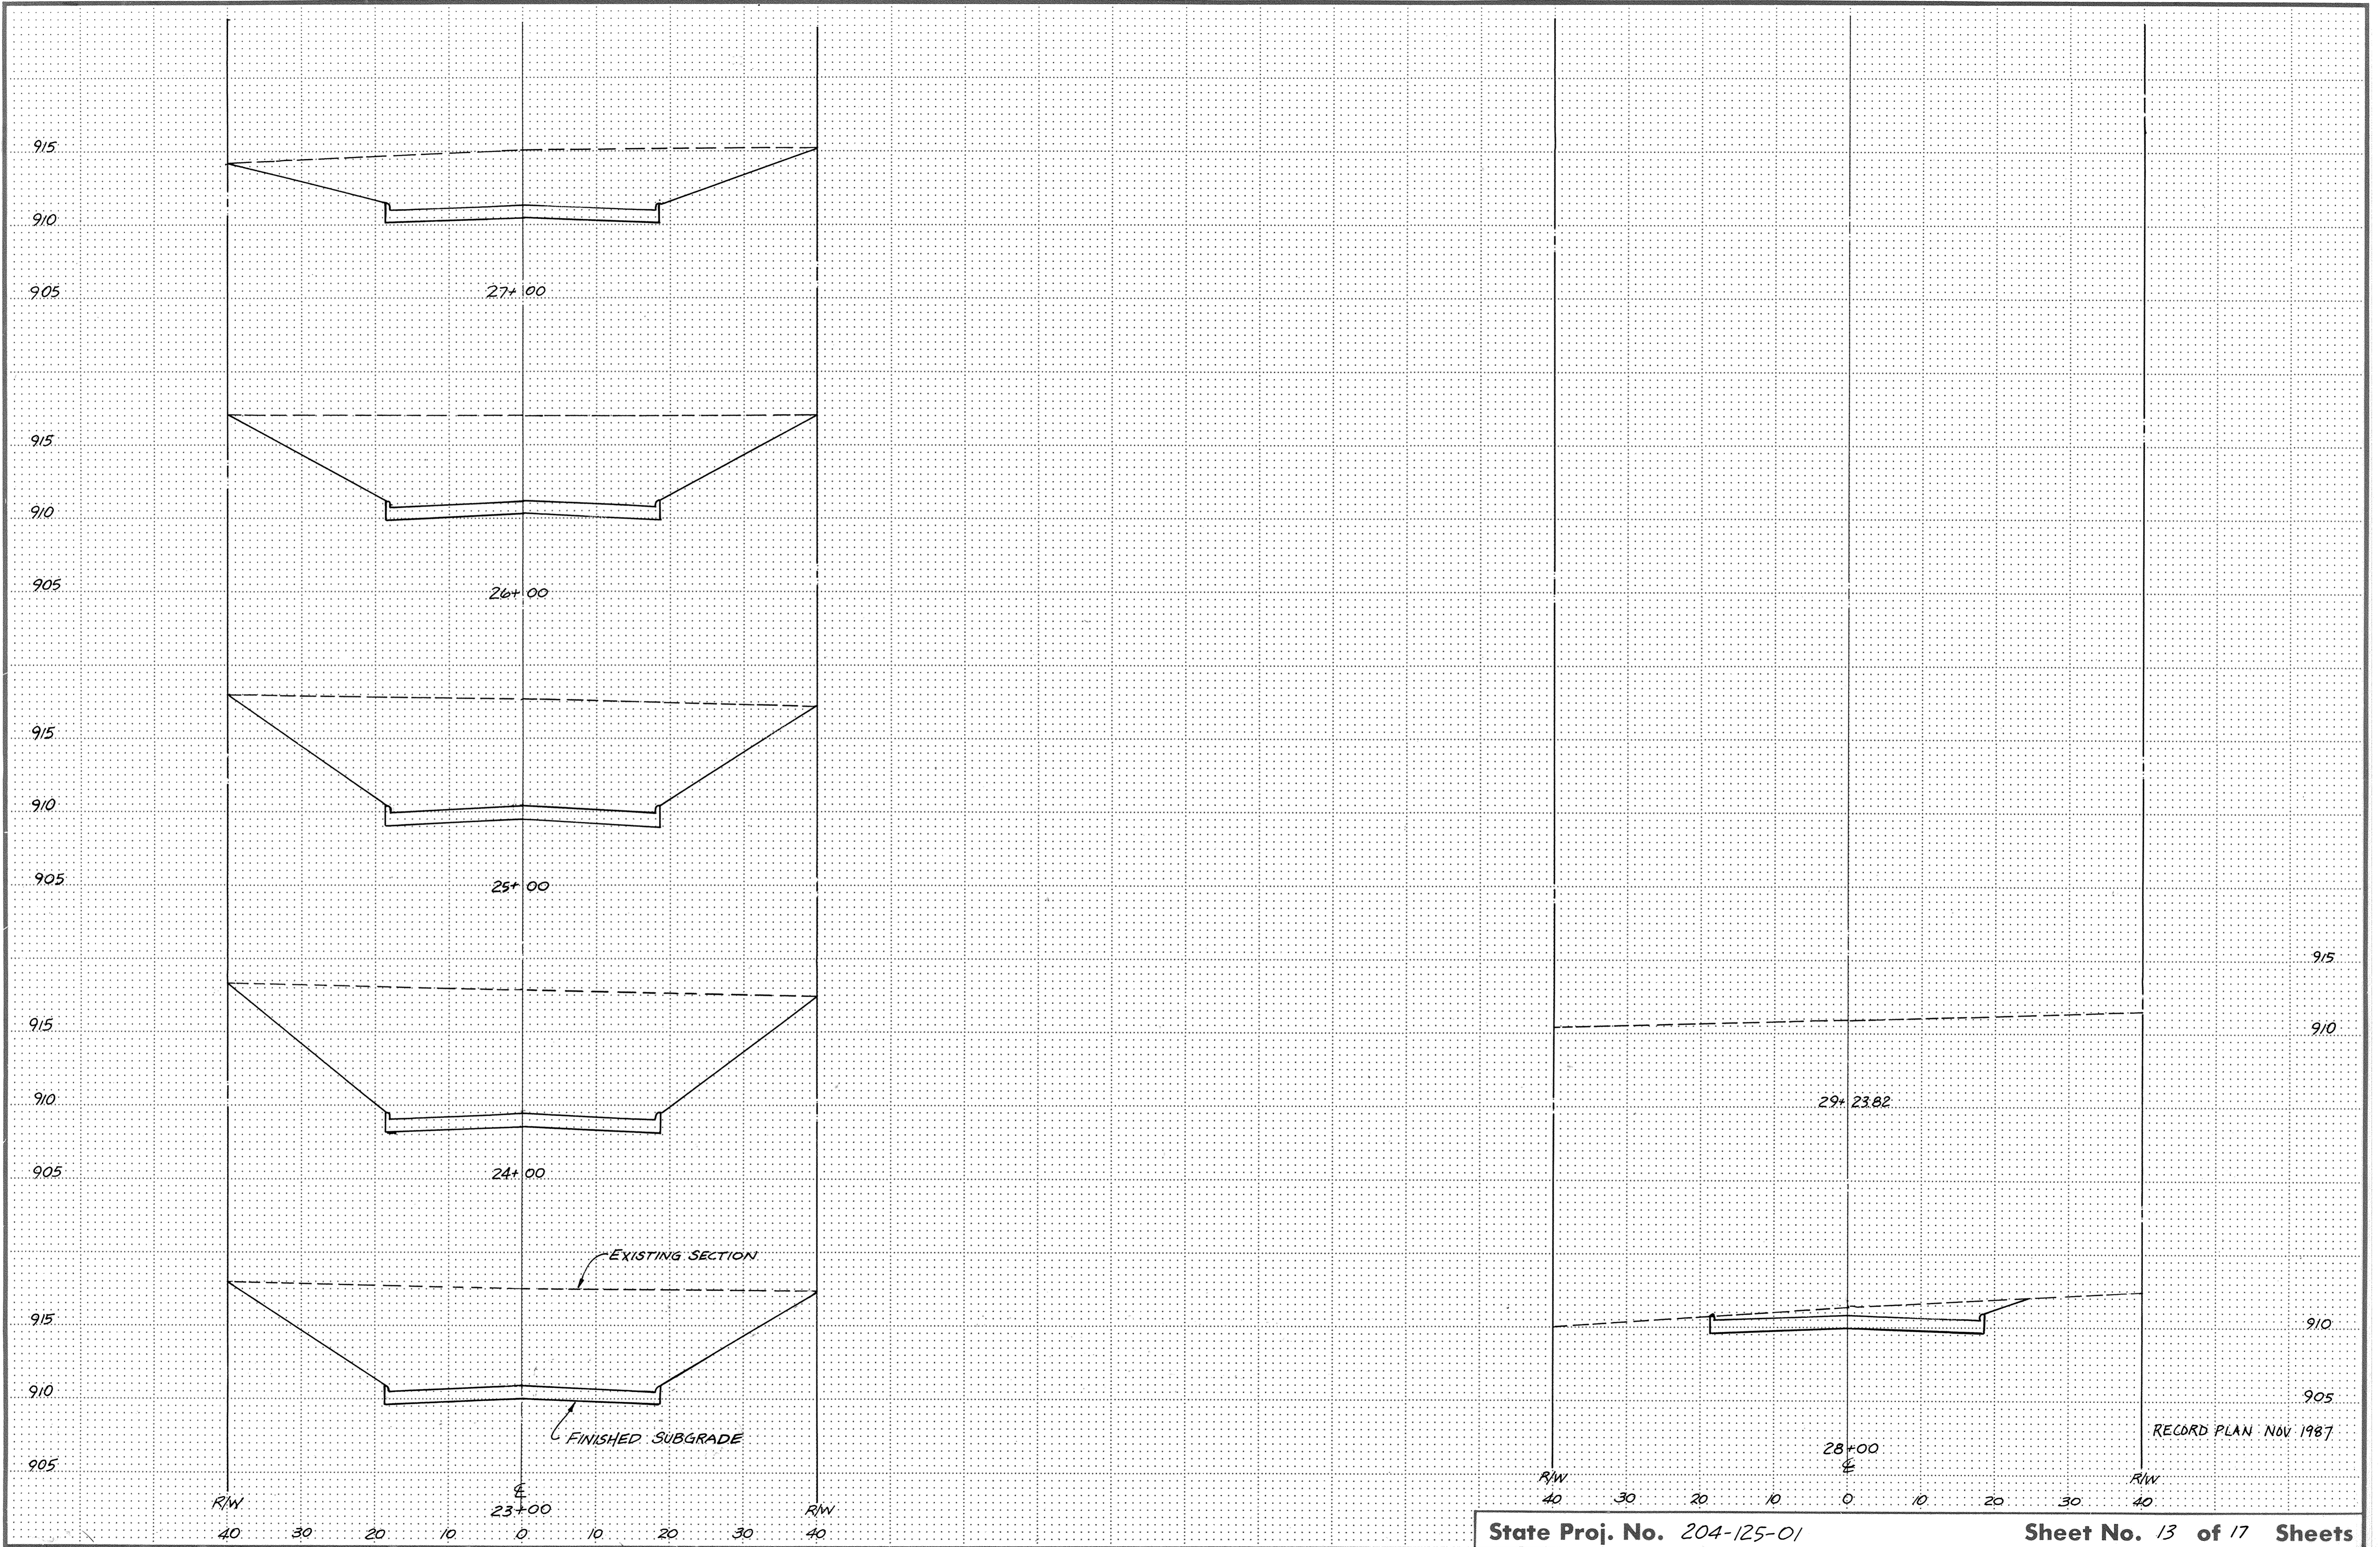

State Proj. No. 204-125-01

Sheet No. 13 of 17 Sheets