©2003 Westwood Professional Services, Inc.

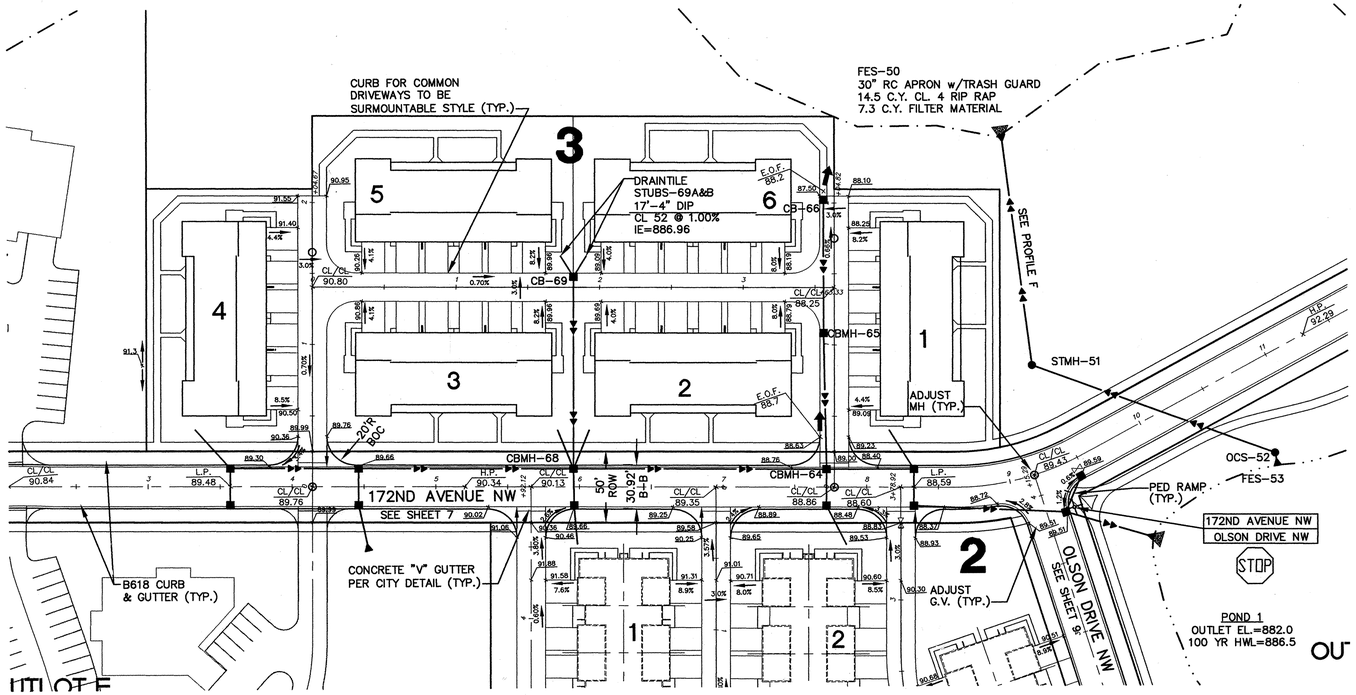

Call 48 Hours before digging:
GOPHER STATE ONE CALL
Twin City Area 651-454-0002
Mn. Toll Free 1-800-252-1166

GENERAL NOTES:

- RADIUS TO BE TYPE B618 CURB AND GUTTER WITH 5 FOOT TRANSITION FROM SURMOUNTABLE CURB PER CITY OF ELK RIVER STANDARDS.
- TYPE B618 CURB & GUTTER SHALL BE CONSTRUCTED AT ALL INTERSECTIONS AND CATCH BASINS.
- 48.09 = 848.09
- RADIUS TO BE B618 C. & G. AS PER ELK RIVER DETAIL 2000 (TYP.)
- ALL RADII TO BE 20' BOC UNLESS OTHERWISE NOTED
- STEEL ADJUSTING RINGS SHOULD BE USED FOR MANHOLE ADJUSTMENTS PRIOR TO WEAR COURSE PLACEMENT AND SHOULD BE TYPE R-1979.

11.90 + DENOTES GUTTER LINE ELEVATION AT INTERSECTIONS

CASTING NOTE:

ALL CATCH BASIN CASTINGS IN CURB SHALL BE SUMPED 0.10 FEET AND MANHOLE CASTINGS IN PAVED AREAS SHALL BE SUMPED 0.05 FEET. RIM ELEVATIONS ON PLAN PROFILES REFLECT THE SUMPED ELEVATIONS.

0' 50' 100' 150'

Quincy Street NW — 172nd Lane NW — Polk Street NW

Profile F

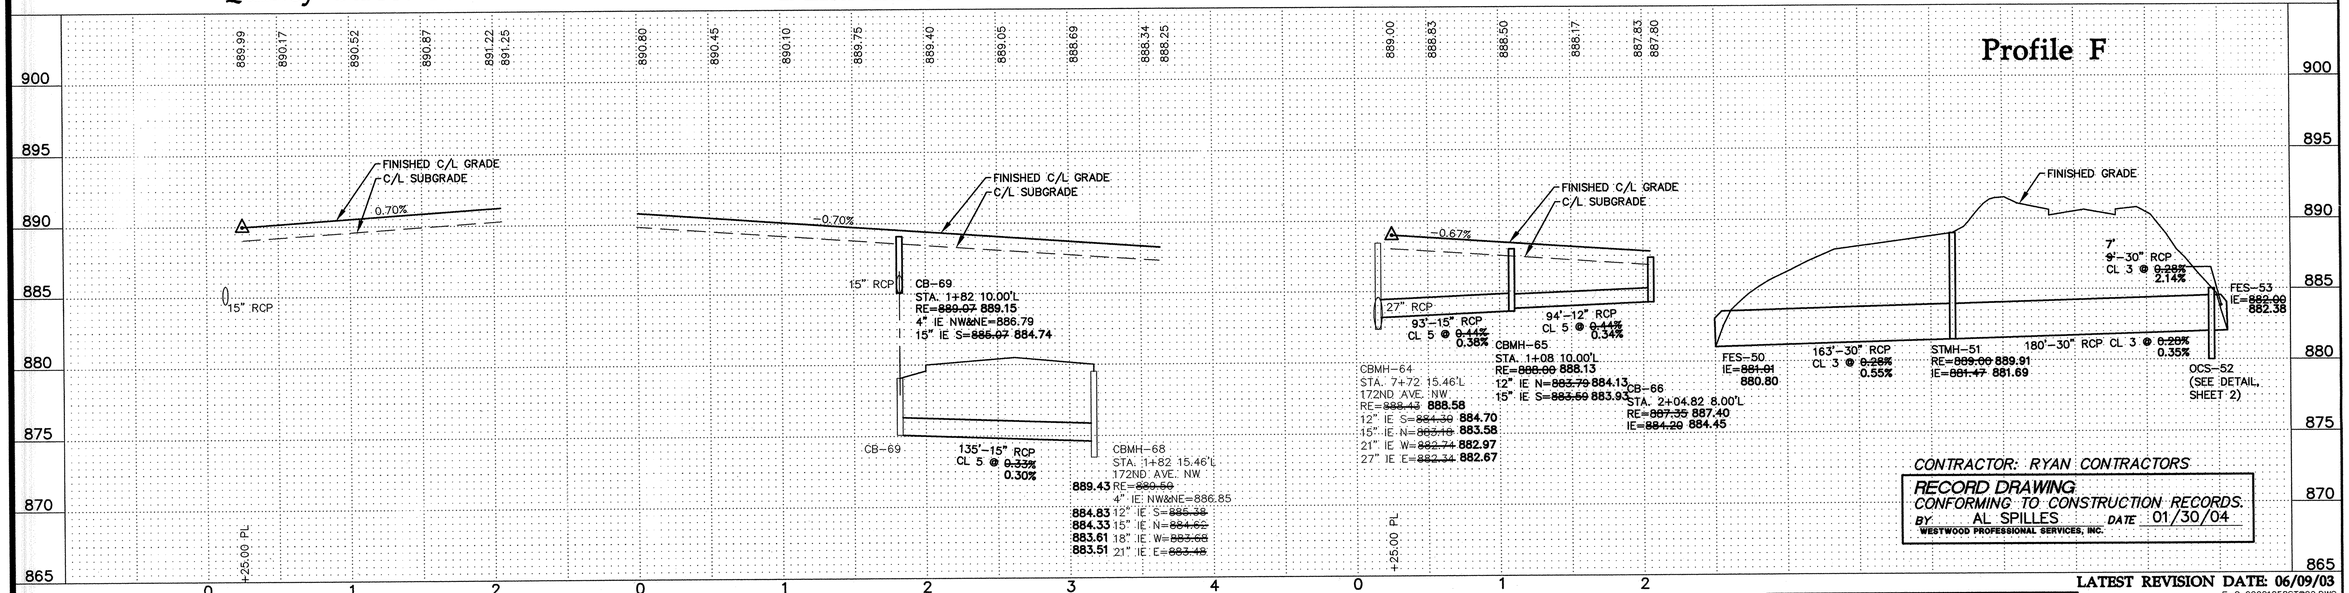

CONTRACTOR: RYAN CONTRACTORS

RECORD DRAWING
CONFORMING TO CONSTRUCTION RECORDS.
BY: AL SPILLES DATE: 01/30/04
WESTWOOD PROFESSIONAL SERVICES, INC.

LATEST REVISION DATE: 06/09/03
E-8 20021058ST002.DWG

Date: 03/21/03 Sheet: 8 OF 16

Westwood Professional Services, Inc.
7599 Anagram Drive
Eden Prairie, MN 55344
Phone: 952/937-5150 Fax: 952/937-5822

I hereby certify that this plan was prepared by me or under my direct supervision and that I am a duly licensed PROFESSIONAL ENGINEER under the laws of the State of Minnesota.

Jason M. McCarty
Date: 01/30/04 License No. 41955

Revisions:
04/02/03 General Comments - CLJ
05/05/03 City Review - CLJ
05/21/03 City Review - CLJ
06/09/03 Drainitle Stubs - CLJ
01/30/04 RECORD DRAWING (AS)

Designed: JMM
Checked: JMM
Drawn: WH
Record Drawing by/date: AS 01/30/04

Prepared for:

CENTEX HOMES
12400 Whitewater Drive, Suite #120
Minnetonka, Minnesota 55343

Elk River Station
Phase I
Elk River, Minnesota

Storm Sewer and Street Construction Plans
Quincy Street NW, 172nd Lane NW & Polk Street NW

DRAWING NUMBER
DRAWING NUMBER ERSTA1.03 8