©2004 Westwood Professional Services, Inc.

Construction Plans

for

Sanitary Sewer, Water Main, Storm Sewer and Streets

for

Elk River Station 2nd Addition

Elk River, Minnesota

Prepared for:

CENTEX HOMES
12701 Whitewater Drive, Suite #300
Minnetonka, Minnesota 55343
Contact: Ian Peterson
Phone: (952) 988-8210
Fax: (952) 936-7839

Prepared by:

Westwood Professional Services, Inc.
7599 Anagram Drive
Eden Prairie, MN 55344
Phone: 952/937-5150 Fax: 952/937-5822

Project Number: 20021058.02
Contact: Jason McCarty

Vicinity Map

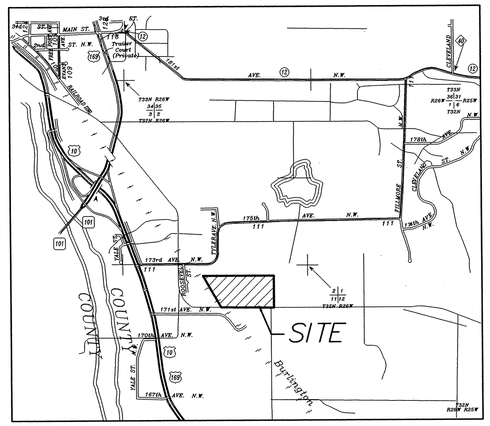

(Not to Scale)

CONTRACTOR:
COMPANY: RYAN COTRACTOR INC.
CONTACT: SCOTT ENRIGHT
ADDRESS: 8700 13TH AVE. E.
SHAKOPEE, MN. 55379
PHONE: (952) 894-3200

NO.	DATE	REVISION	SHEETS
1	02/05/04	PER CITY REVIEW	ALL
2	04/22/04	STORM SEWER REVISION	ALL
3	05/03/05	RECORD DRAWINGS	ALL

INDEX

SHEET NO.	DESCRIPTION
1	COVER
2	OVERALL PLAN
3	SANITARY SEWER & WATER MAIN – 172nd AVENUE NW (STA 11+00 TO 20+76.49)
4	SANITARY SEWER & WATER MAIN – 172nd LANE NW, NIXON STREET NW, MONROE STREET NW
5	SANITARY SEWER & WATER MAIN – NIXON STREET NW & MONROE STREET NW (STA. 21+50 TO 26+31)
6	SANITARY SEWER & WATER MAIN – 171st LANE NW / MONROE STREET NW (STA. 13+50 TO 21+50)
7	STORM SEWER & STREET CONST. – 172nd AVENUE NW (STA. 9+46 TO 20+76.49)
8	STORM SEWER & STREET CONST. – 172nd LANE NW, NIXON STREET NW, MONROE STREET NW
9	STORM SEWER & STREET CONST. – NIXON STREET NW & MONROE STREET NW (STA. 21+50 TO 26+31)
10	STORM SEWER & STREET CONST. – 171st LANE NW / MONROE STREET NW (STA. 13+50 TO 21+50)
11–14	DETAILS

CONTRACTOR: RYAN CONTRACTING
RECORD DRAWING
CONFORMING TO CONSTRUCTION RECORDS.
BY ALLAN SPILLES DATE 05/03/05
WESTWOOD PROFESSIONAL SERVICES

Construction Plans
for
Sanitary Sewer, Water Main, Storm Sewer and Streets
for
Elk River Station - 2nd Addition
Elk River, Minnesota

Date: 12/01/03 Sheet: 1 of 14

E-8 20021058.02CV001.DWG

P:\20021058.02\dwg\RECORD\20021058.02CV001.dwg 5/2/2005 12:48:02 PM CST

DRAWING NUMBER
SAFCO PRODUCTS • NEW HOPE, MINNESOTA
REORDER BY PART NUMBER 6532
PRINTED FREE OF PRINT ON THIS LINE

DRAWING NUMBER
SAFCO PRODUCTS • NEW HOPE, MINNESOTA
REORDER BY PART NUMBER 6532
PRINTED FREE OF PRINT ON THIS LINE

DRAWING NUMBER
ERSTA2.04
1
SAFCO PRODUCTS • NEW HOPE, MINNESOTA
REORDER BY PART NUMBER 6532
PRINTED FREE OF PRINT ON THIS LINE

2nd ADDITION - 2004