


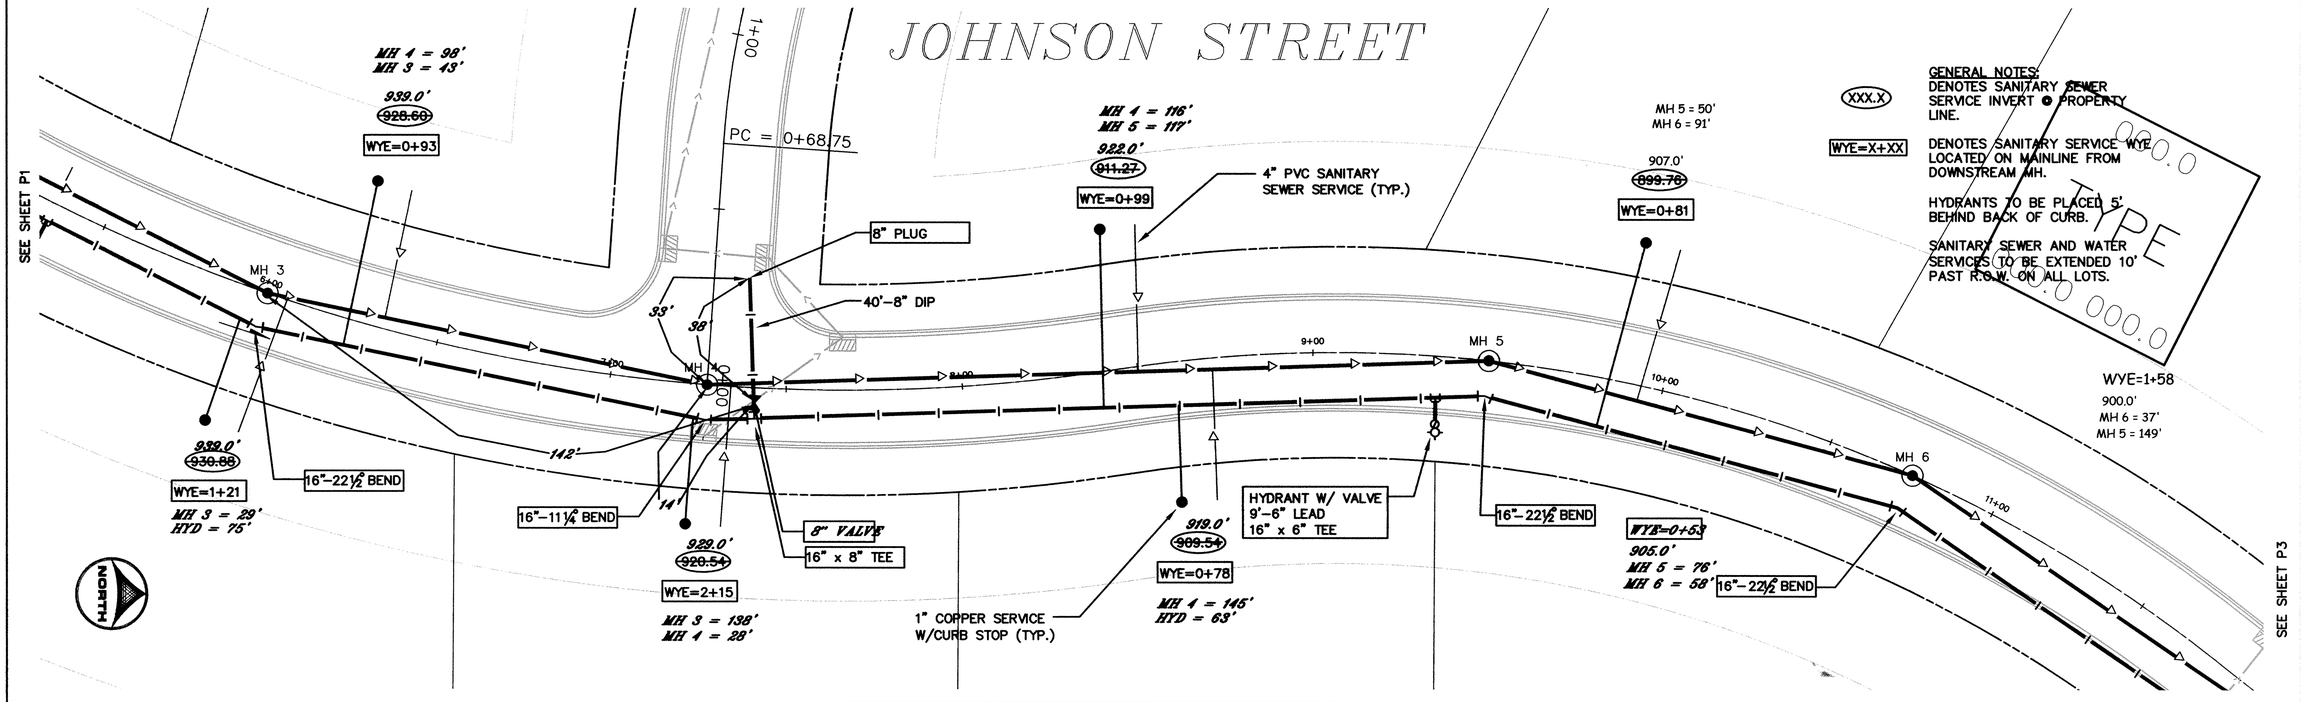


Xrefs: 200378BA.DWG

DESIGNED BY: KT DRAWN BY: EY/RM
APPROVED BY: – JOB NUMBER 816050J
CAD DATE: February 01, 2003 9:06:48 a.m.
CAD FILE: 816050j\dwg\XCS-BASE.DWG (JLALLEN)

I HEREBY CERTIFY THAT THIS PLAN, SPECIFICATION, OR REPORT WAS PREPARED BY ME OR UNDER MY DIRECT SUPERVISION AND THAT I AM A DULY LICENSED PROFESSIONAL ENGINEER UNDER THE LAWS OF THE STATE OF MINNESOTA.

SIGNATURE _____ DATE _____

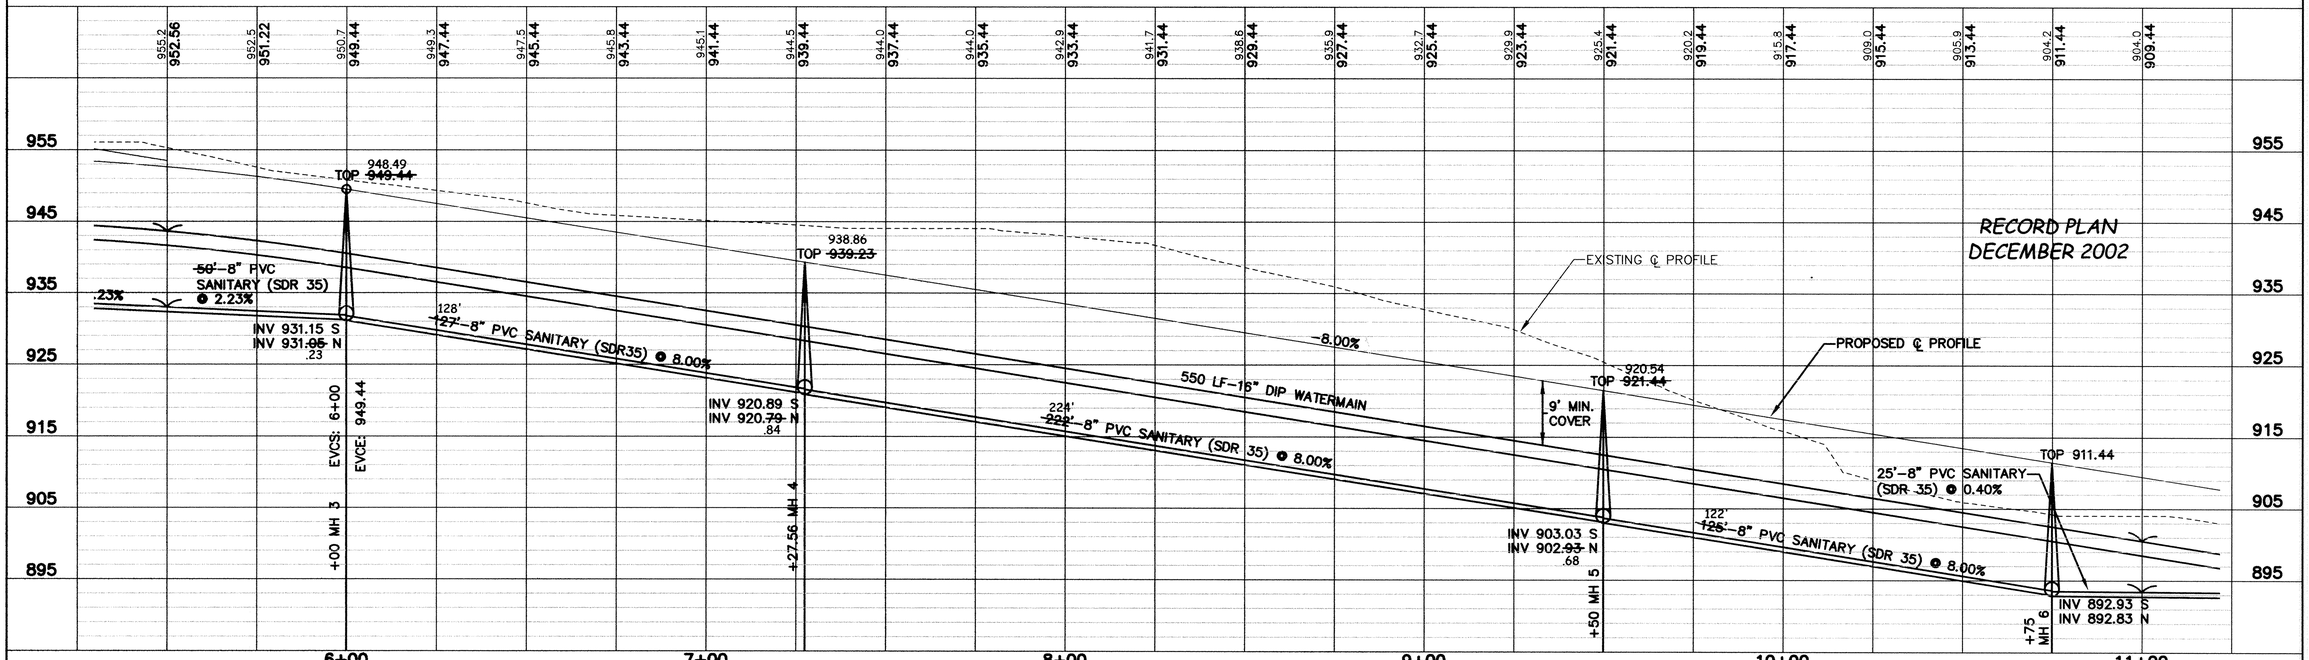PRINTED NAME TERRY J. MAURER LIC.NO. 15316

| NO. | DATE | BY | REVISION DESCRIPTION |
|---|---|---|---|
| | | | |

ELK RIVER MUNICIPAL UTILITIES
EAGLE MARSH

SANITARY SEWER AND
WATERMAIN IMPROVEMENTS
STA. 5+50 TO 11+00

SHEET NO.
P2

DRAWING NUMBER
SAFCO PRODUCTS • NEW HOPE, MINNESOTA
REORDER BY PART NUMBER 6550
EAGLE 02
4