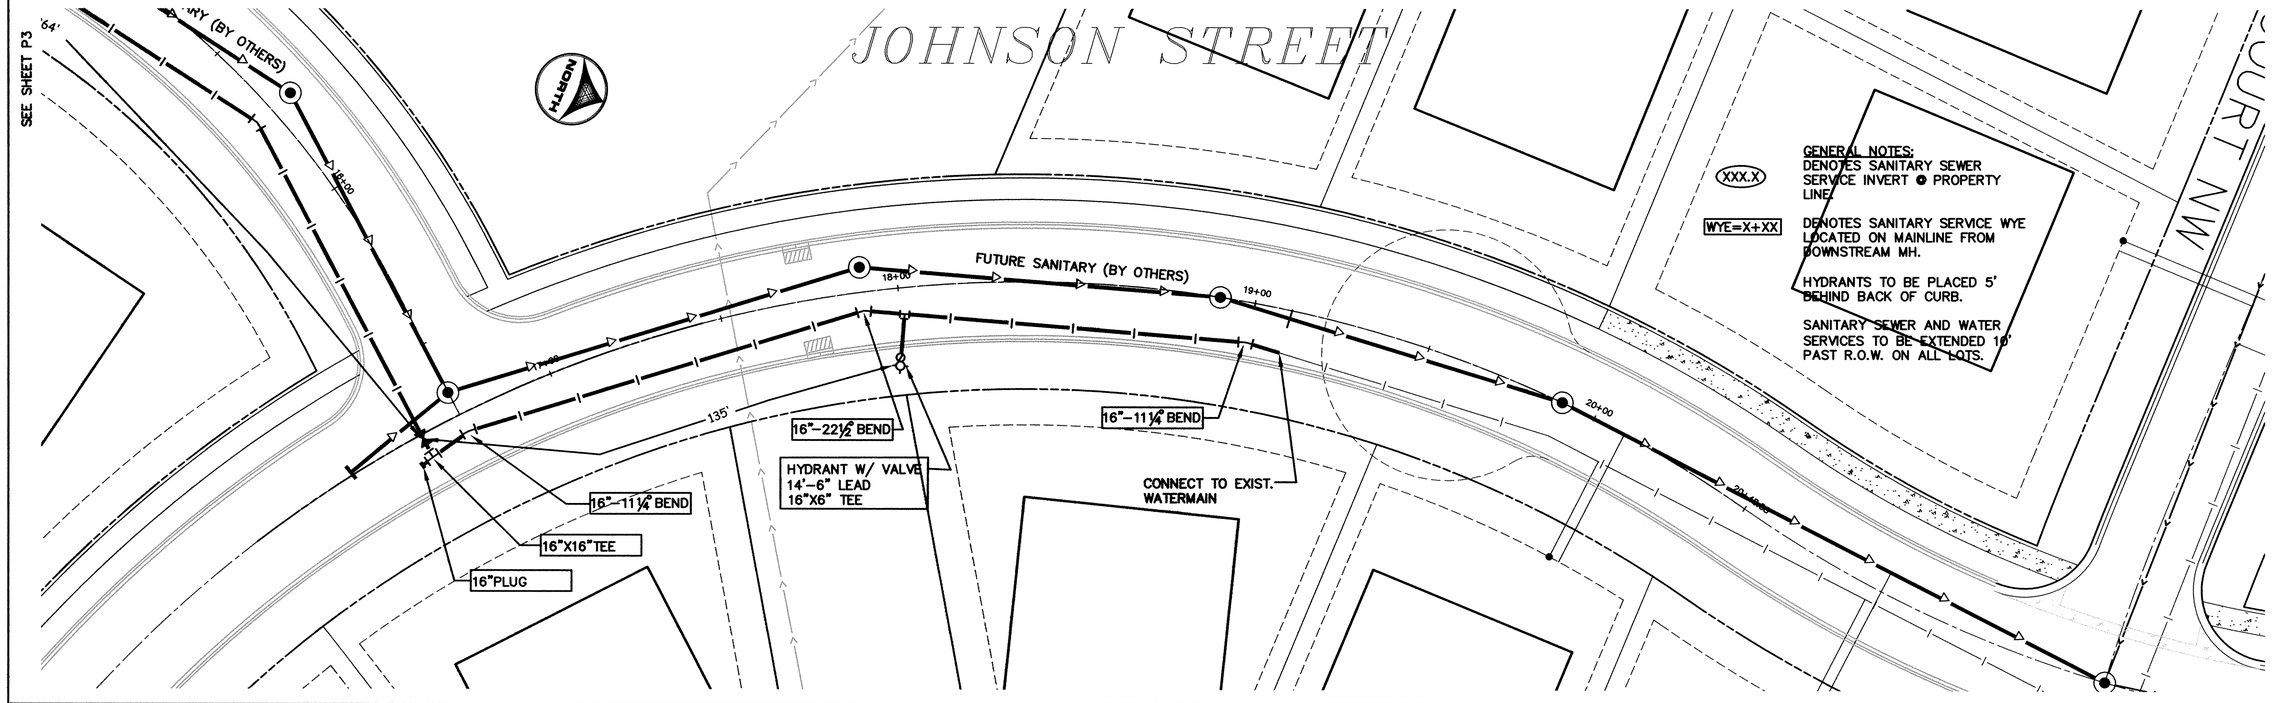

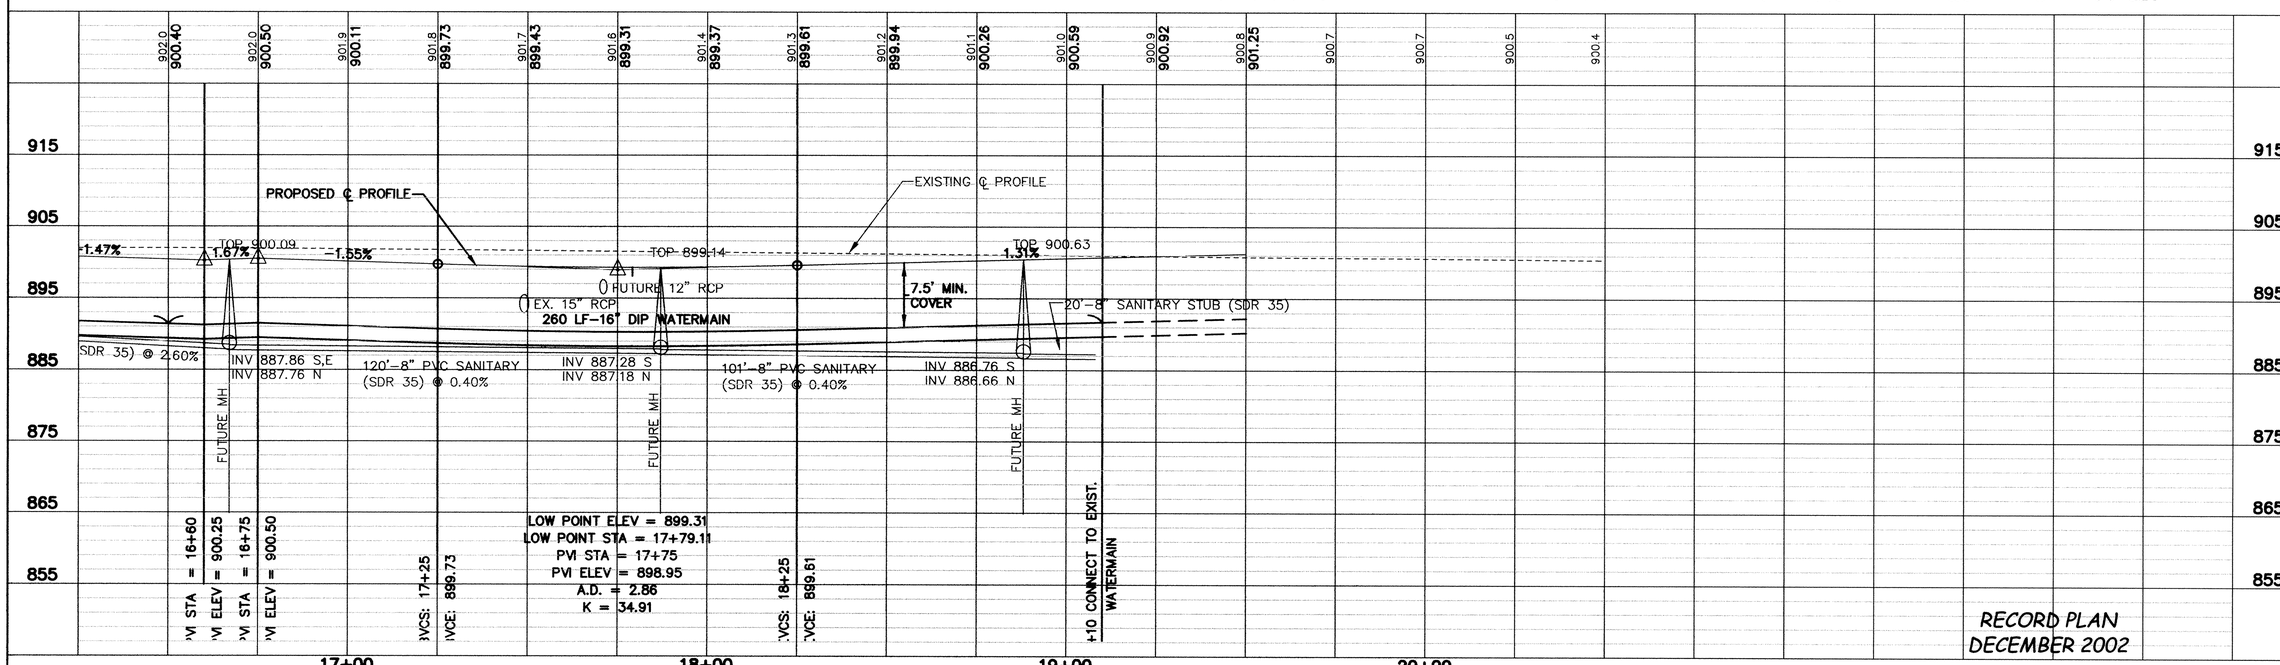

Xrefs: 2003768A.DWG

DESIGNED BY: KT DRAWN BY: EY/RM
APPROVED BY:– JOB NUMBER 816050J
CAD DATE: February 01, 2003 9:06:48 a.m.
CAD FILE: 816050j\dwg\XCS-BASE.DWG (JLALLEN)

I HEREBY CERTIFY THAT THIS PLAN, SPECIFICATION, OR REPORT WAS PREPARED BY ME OR UNDER MY DIRECT SUPERVISION AND THAT I AM A DULY LICENSED PROFESSIONAL ENGINEER UNDER THE LAWS OF THE STATE OF MINNESOTA.

SIGNATURE _____ DATE _____
PRINTED NAME TERRY J. MAURER LIC.NO. 15316

NO.	DATE	BY	REVISION DESCRIPTION

ELK RIVER MUNICIPAL UTILITIES
EAGLE MARSH

WATERMAIN IMPROVEMENTS
STA. 16+50 TO 20+48.88

SHEET NO.
P4

DRAWING NUMBER
EAGLE.02
6

SAFCO PRODUCTS • NEW HOPE, MINNESOTA
REORDER BY PART NUMBER 6938