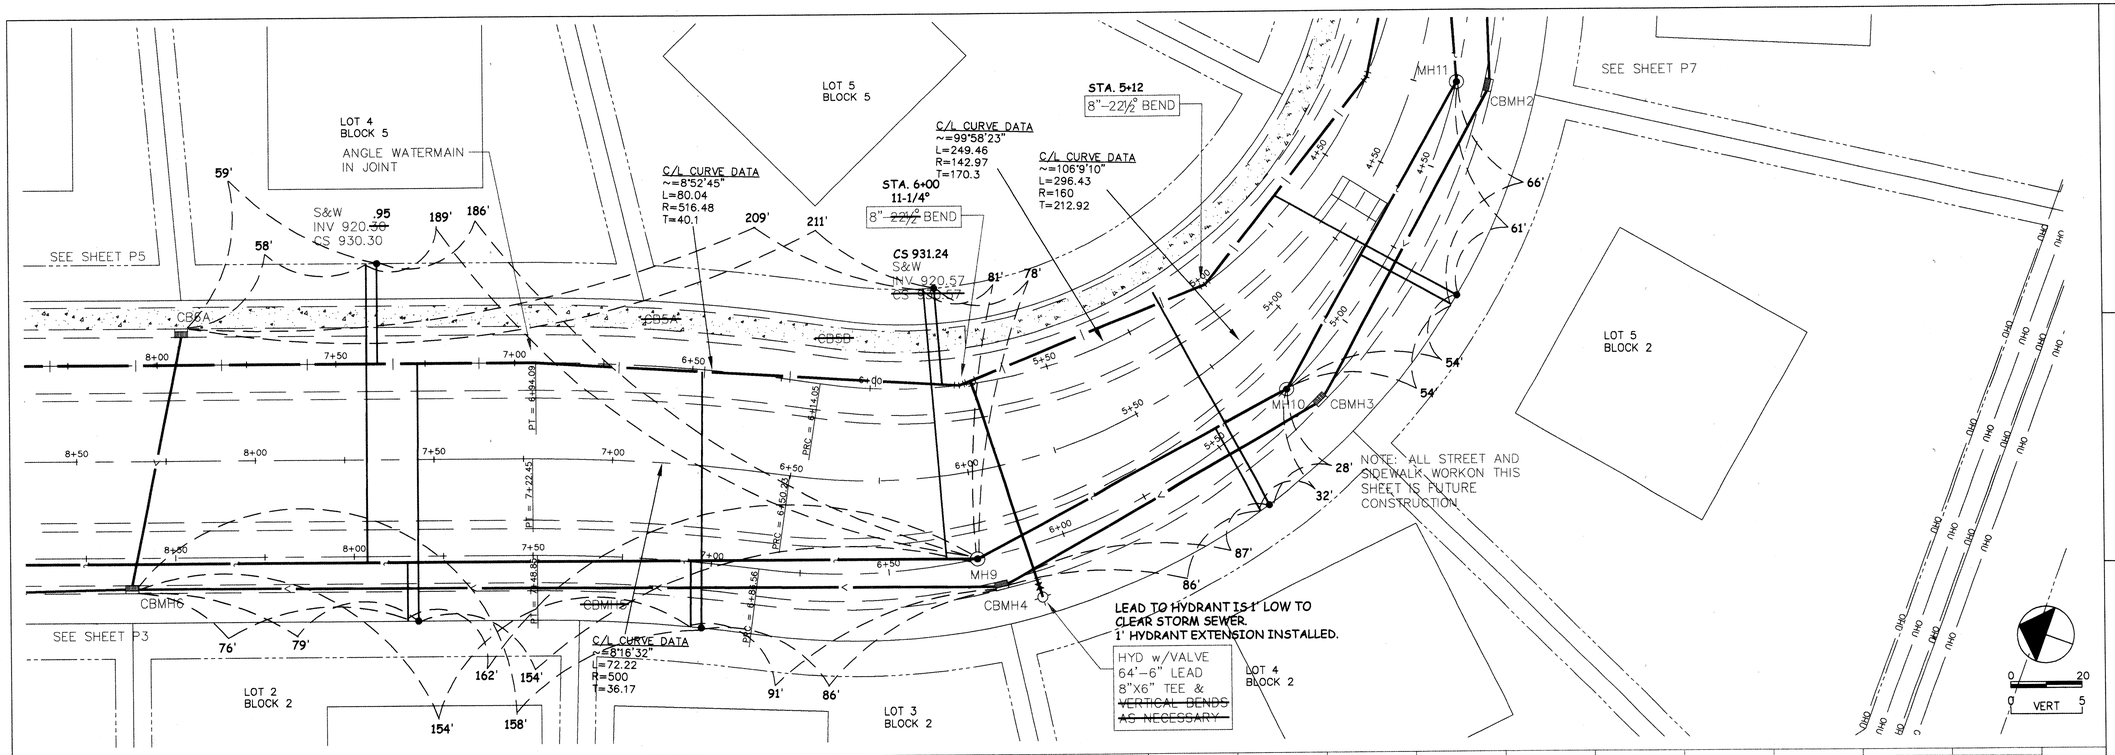

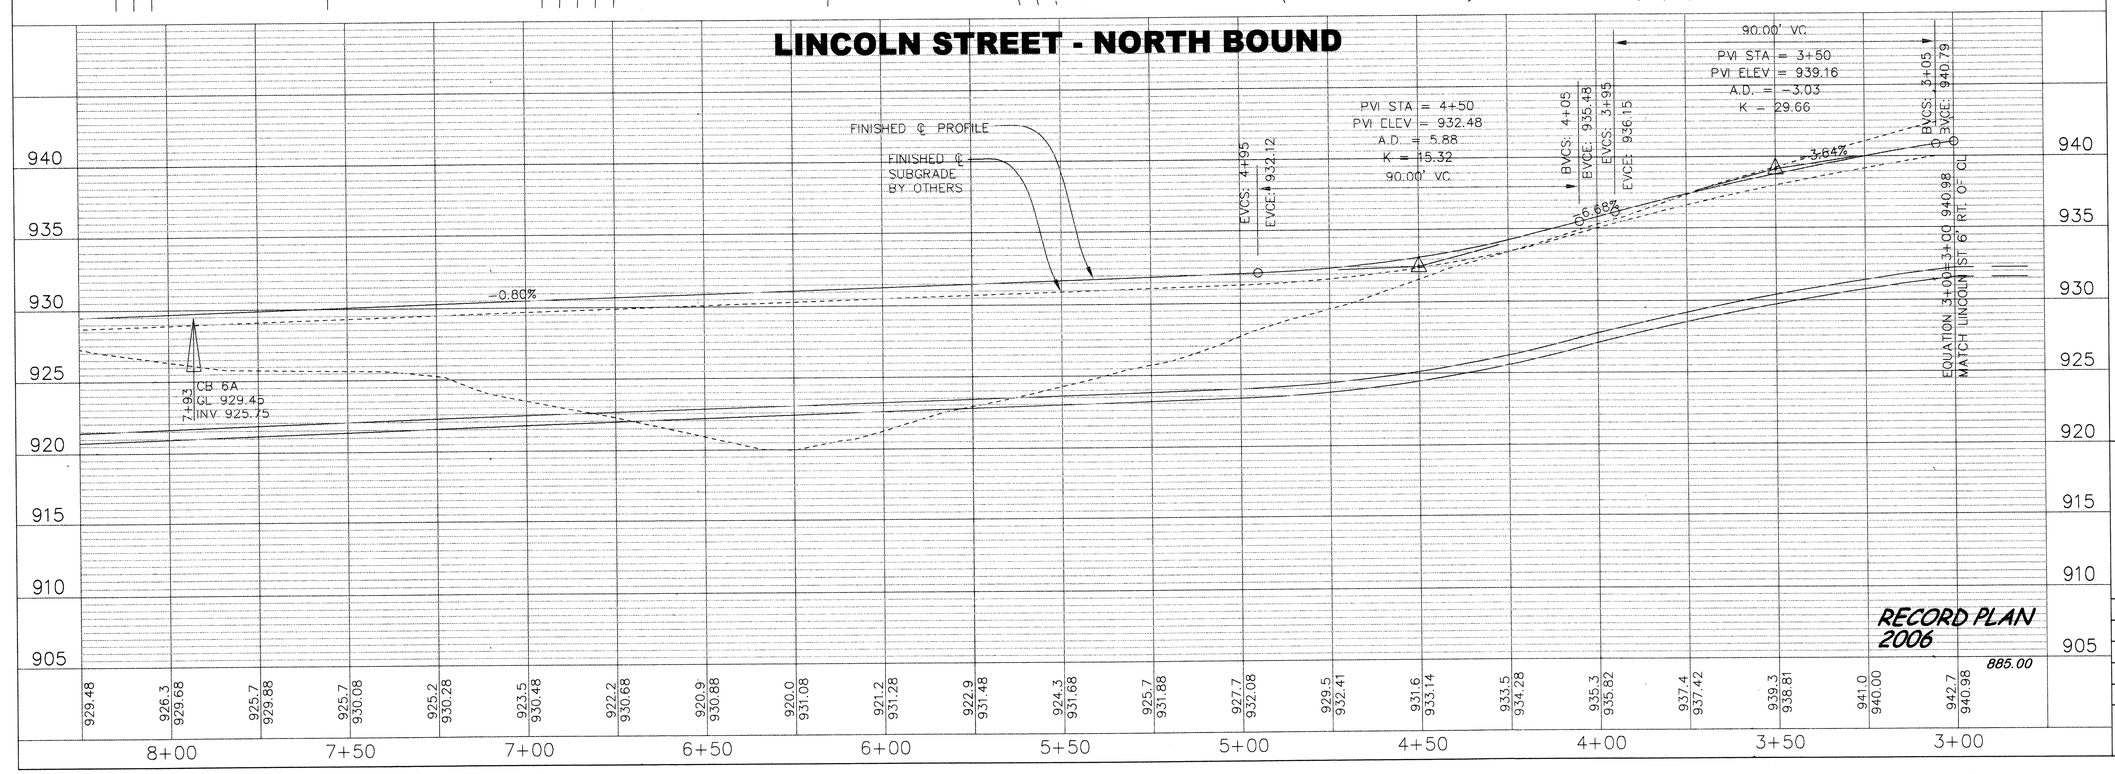

REVISIONS			
NO.	DATE	BY	DESCRIPTION
	01/27/08	EY	AS-BUILT PER CITY

I HEREBY CERTIFY THAT THIS PLAN, SPECIFICATION, OR REPORT WAS PREPARED BY ME OR UNDER MY DIRECT SUPERVISION AND THAT I AM A DULY LICENSED PROFESSIONAL ENGINEER UNDER THE LAWS OF THE STATE OF MINNESOTA.

JOHN M. ANDERSON
March 17, 2006 25889
DATE LIC. NO.

RIVERSIDE COMPANIES
EAGLES MARSH 2ND ADDITION
PLAN AND PROFILE
LINCOLN STREET - NORTHBOUND LANE

BDM
CONSULTING ENGINEERS, PLC
Engineers and Surveyors
4175 Lovell Road, Suite 112
Lexington, MN 55014
Phone: (763) 786-4570
Fax: (763) 786-4574
bdmce.com

DRAWN BY: JL
CHECKED BY: JMA
DESIGNED BY: JL
JOB NO. 226088

SHEET P6 SHEETS 26

DRAWING NUMBER