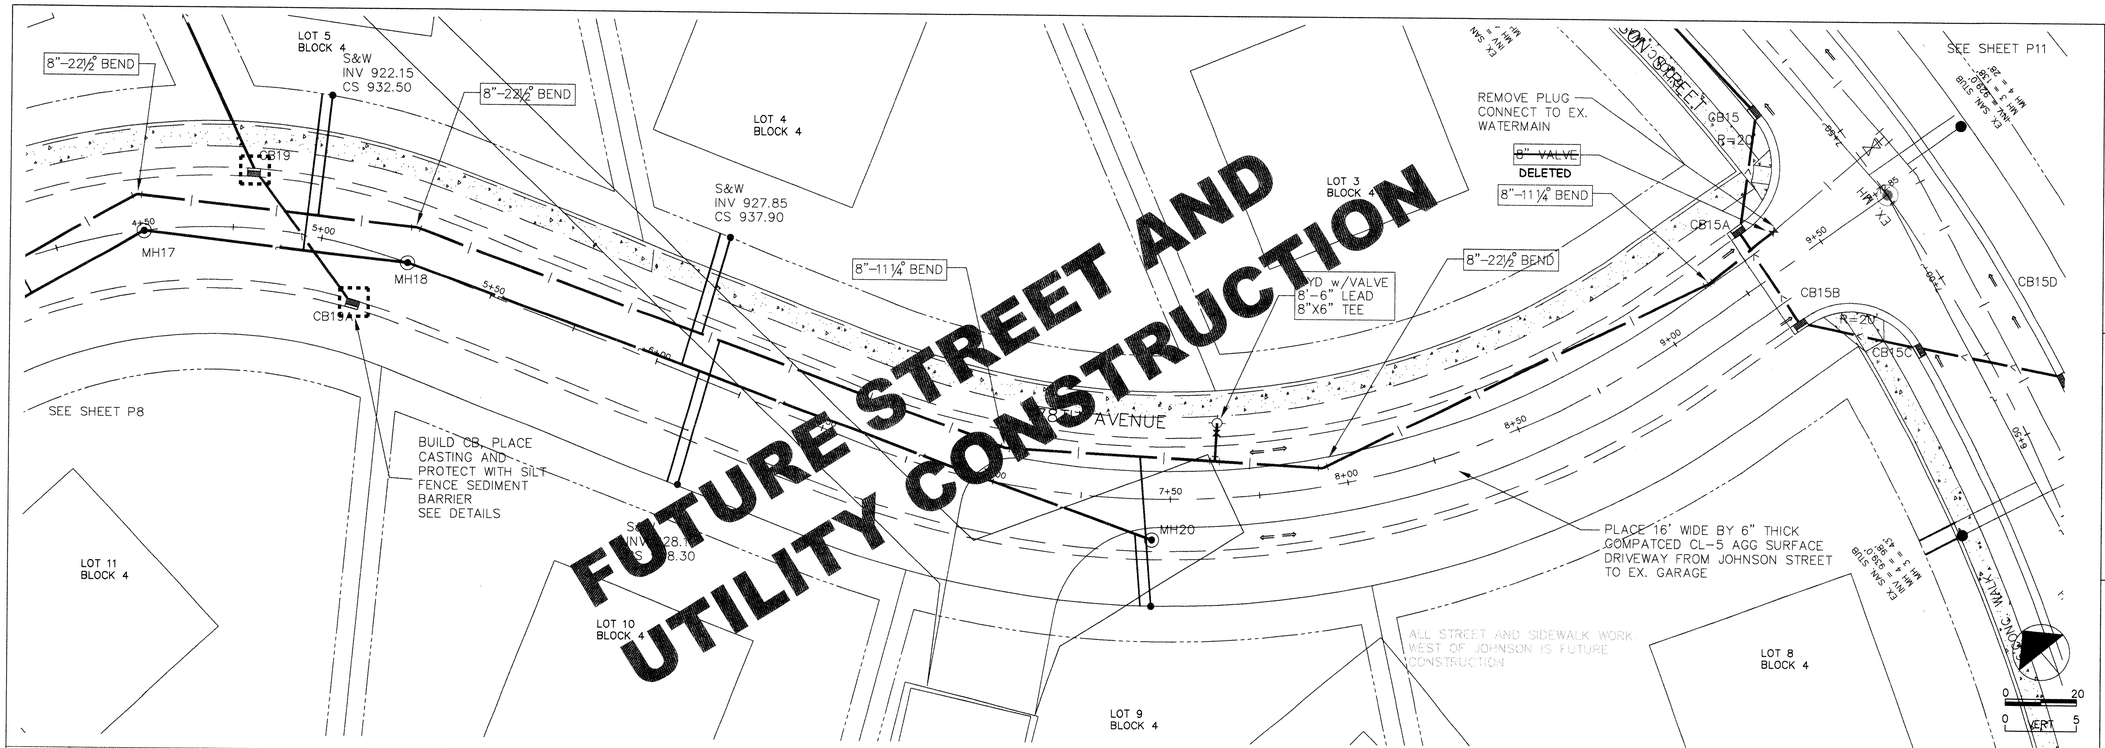

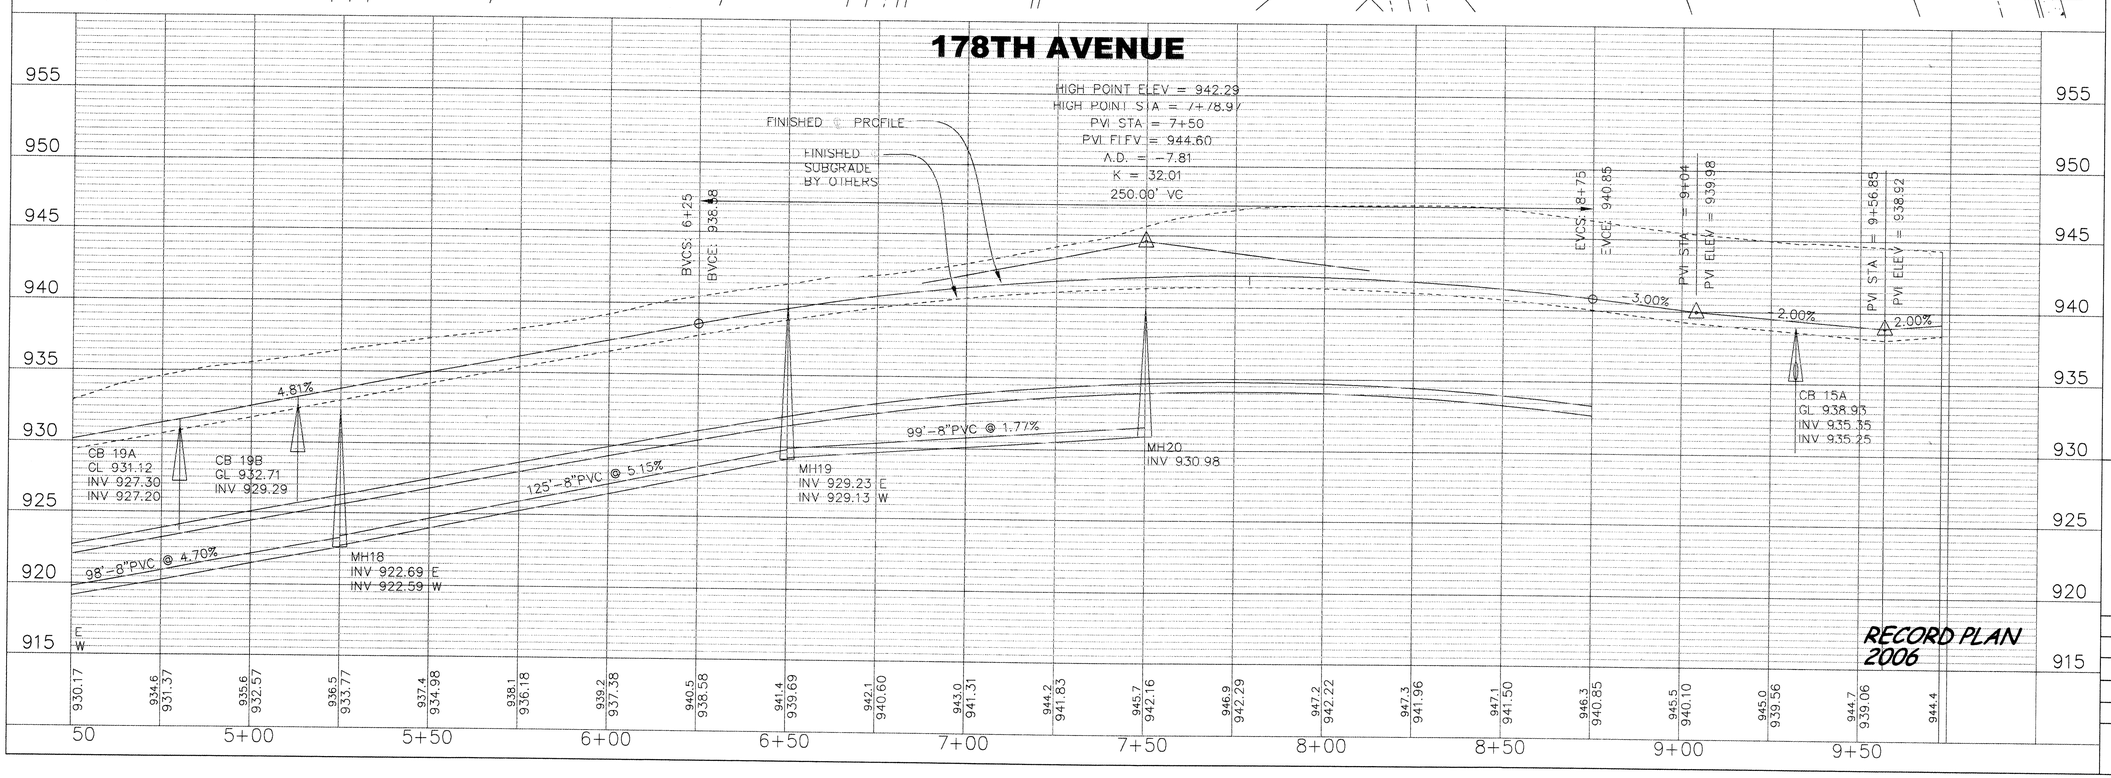

REVISIONS			
NO.	DATE	BY	DESCRIPTION
	01/27/08	EY	AS-BUILT PER CITY

I HEREBY CERTIFY THAT THIS PLAN, SPECIFICATION, OR REPORT WAS PREPARED BY ME OR UNDER MY DIRECT SUPERVISION AND THAT I AM A DULY LICENSED PROFESSIONAL ENGINEER UNDER THE LAWS OF THE STATE OF MINNESOTA.

Date: 2006/03/17 Time: 08:30:57 User: John Anderson

JOHN M. ANDERSON

March 17, 2006 — 25889

DATE — LIC. NO.

RIVERSIDE COMPANIES
EAGLES MARSH 2ND ADDITION
PLAN AND PROFILE
178TH AVENUE

BDM
CONSULTING ENGINEERS, PLC
Engineers and Surveyors
4175 Lovell Road, Suite 112
Lexington, MN 55014
Phone: (763) 786–4570
Fax: (763) 786–4574
bdmce.com

DRAWN BY:	JL
CHECKED BY:	JMA
DESIGNED BY:	JL
JOB NO.	226088

SHEET	SHEETS
P9	26