
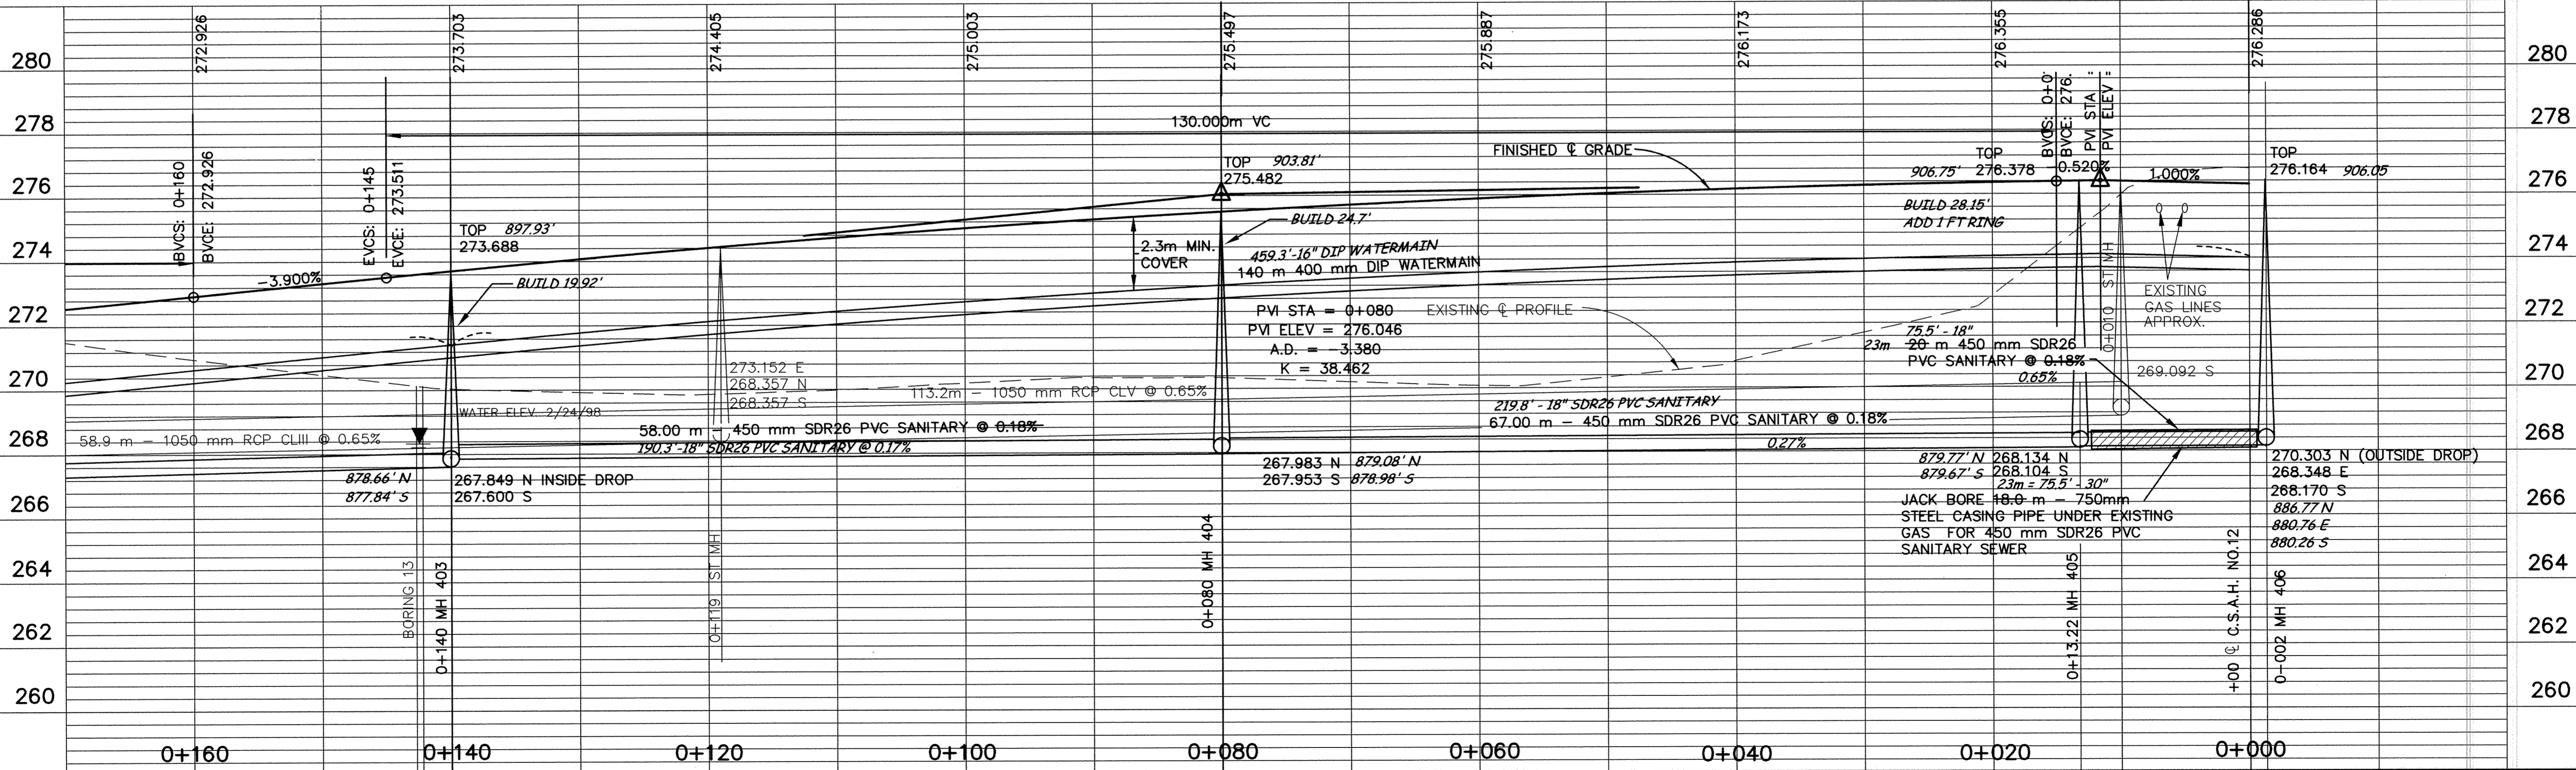


TYLER STREET

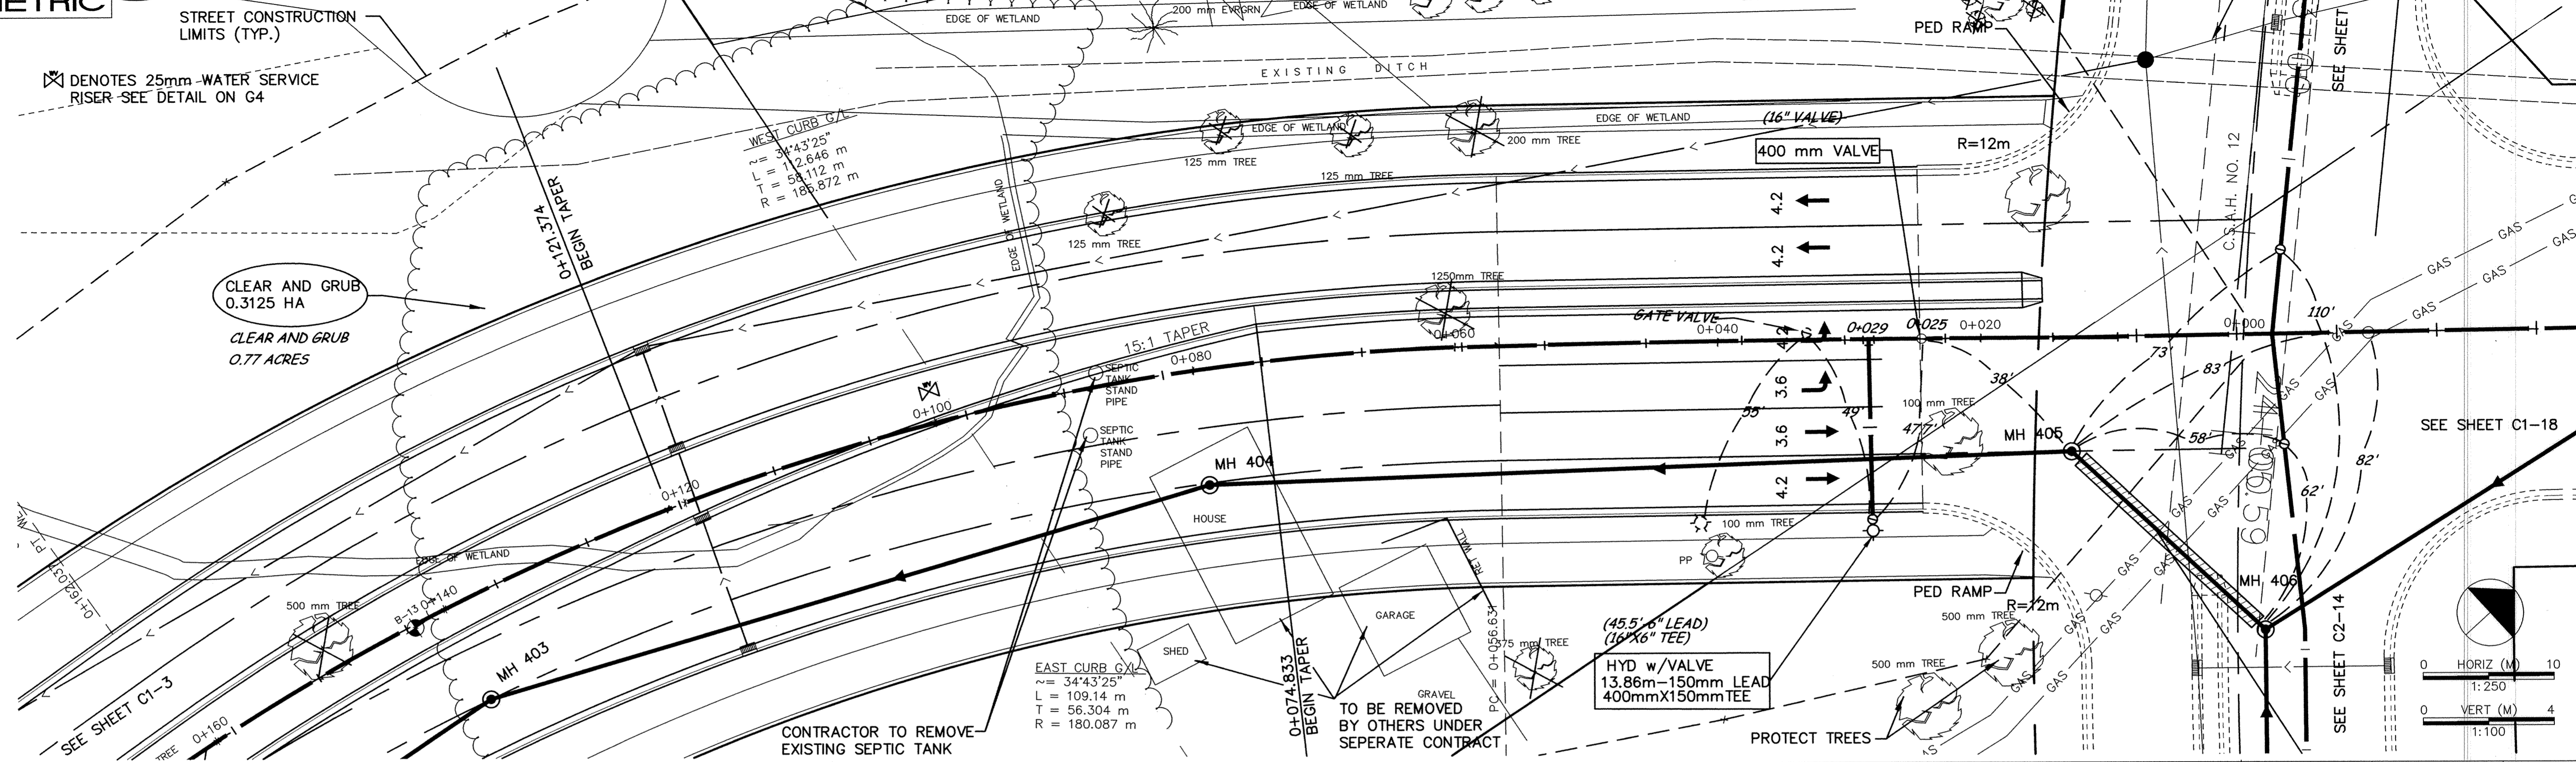

DESIGNED BY: X JOB DATE: MARCH 1998
 DRAWN BY: Job NUMBER: 800110J
 APPROVED: CAD DATE:
 CAD FILE: February 08, 1999 10:54:35 a.m.
 800110J\Drawg\Tyler_BASE\01.DWG

I HEREBY CERTIFY THAT THIS PLAN, SPECIFICATION, OR REPORT WAS PREPARED BY ME OR UNDER MY DIRECT SUPERVISION AND THAT I AM A DULY REGISTERED PROFESSIONAL ENGINEER UNDER THE LAWS OF THE STATE OF MINNESOTA.
 DATE 10/15/98 REG. NO. 15316

NO.	DATE	BY	REVISION DESCRIPTION
1	1-21-99	PH	PROTECT TREES NOTE

1326 ENERGY PARK DRIVE
 ST. PAUL, MINNESOTA 55108
 (612) 644-4389

Howard R. Green Company
 CONSULTING ENGINEERS

CITY OF ELK RIVER
 EASTERN AREA
 PHASE I IMPROVEMENTS

STREET AND UTILITY IMPROVEMENTS
 TYLER STREET
 0+000 TO 0+140

SHEET NO.
C1-2