C.S.A.H. NO.12

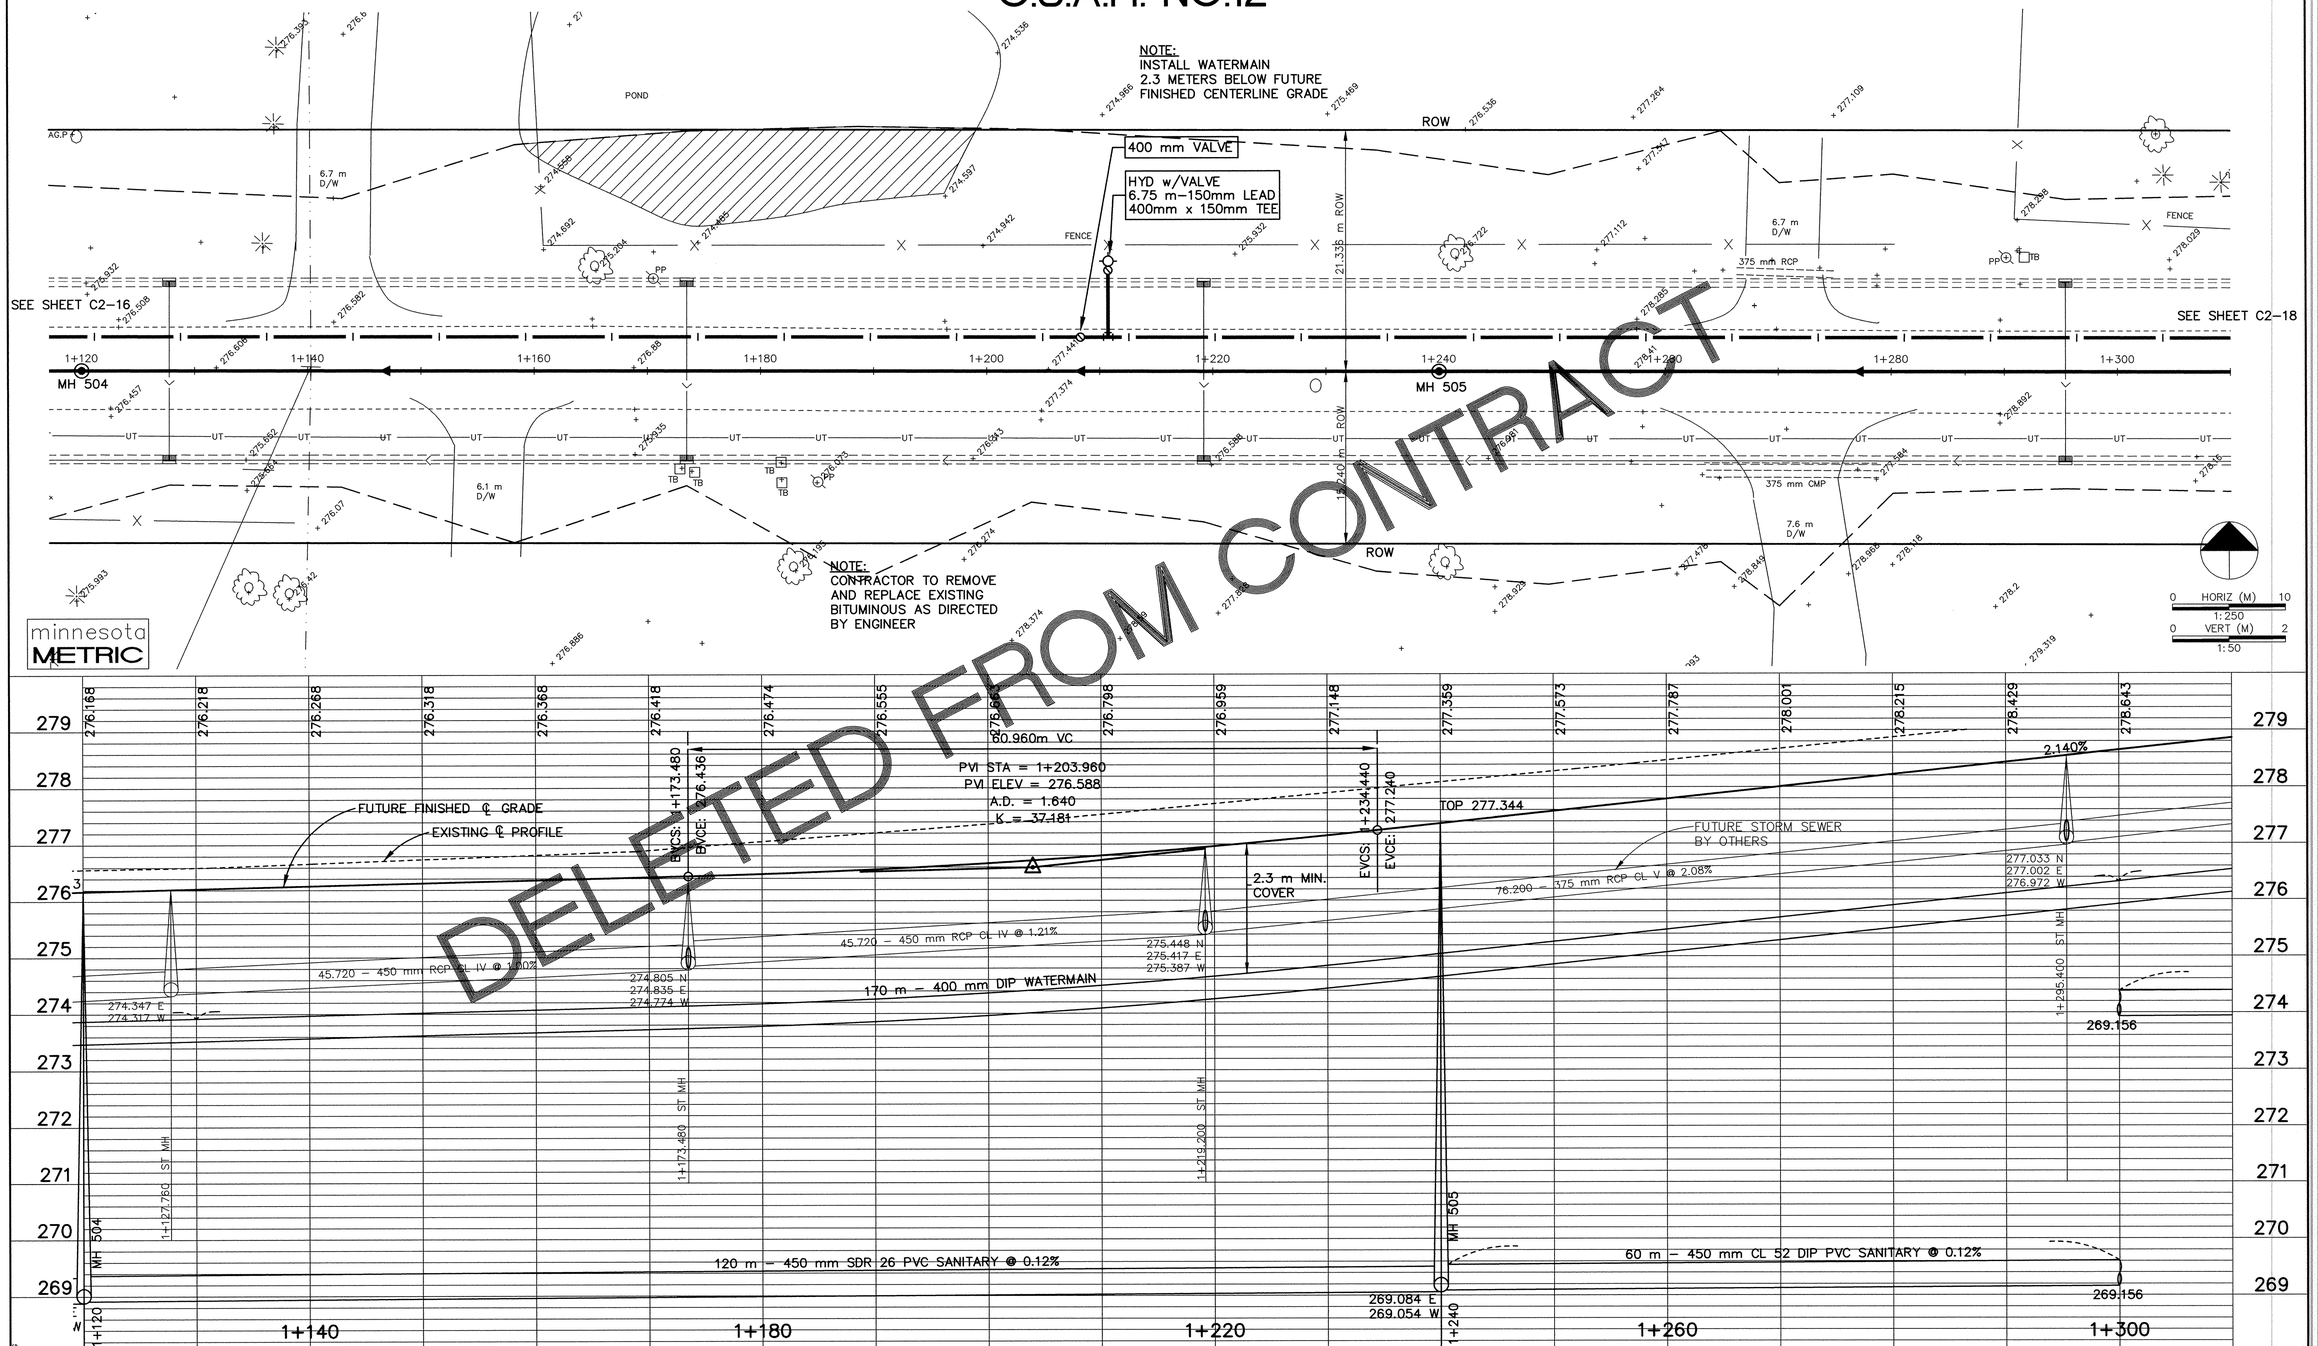

DELETED FROM CONTRACT

DESIGNED BY:	JOB DATE: JULY 1998
DRAWN BY: WGJ	JOB NUMBER 800110J
APPROVED:	CAD DATE: JULY 1998
CAD FILE: February 08, 1999 2:08:26 p.m. 800110J\Dwgs\BALDWIN\16.DWG	

I HEREBY CERTIFY THAT THIS PLAN, SPECIFICATION, OR REPORT WAS PREPARED BY ME OR UNDER MY DIRECT SUPERVISION AND THAT I AM A DULY REGISTERED PROFESSIONAL ENGINEER UNDER THE LAWS OF THE STATE OF MINNESOTA.

DATE _____ REG.NO. 15316

NO.	DATE	BY	REVISION DESCRIPTION
1	1-19-99	PH	C.O. NO. 1

Howard R. Green Company
CONSULTING ENGINEERS
1326 ENERGY PARK DRIVE
ST. PAUL, MINNESOTA 55108
(612) 644-4389

CITY OF ELK RIVER
EASTERN AREA
PHASE I IMPROVEMENTS

WATERMAIN IMPROVEMENTS
C.S.A.H. NO.12
1+130 TO 1+300

SHEET NO.
C2-17

DRAWING NUMBER
SAFCO PRODUCTS • NEW HOPE, MINNESOTA
REORDER BY PART NUMBER 6595
POSITIVE EDGE OF PAPER ON THIS LINE
DRAWING NUMBER
SAFCO PRODUCTS • NEW HOPE, MINNESOTA
REORDER BY PART NUMBER 6595
POSITIVE EDGE OF PAPER ON THIS LINE
DRAWING NUMBER
SAFCO PRODUCTS • NEW HOPE, MINNESOTA
REORDER BY PART NUMBER 6595
POSITIVE EDGE OF PAPER ON THIS LINE
DRAWING NUMBER
EASTE1.98
102
SAFCO PRODUCTS • NEW HOPE, MINNESOTA
REORDER BY PART NUMBER 6595
POSITIVE EDGE OF PAPER ON THIS LINE