C.S.A.H. NO.12

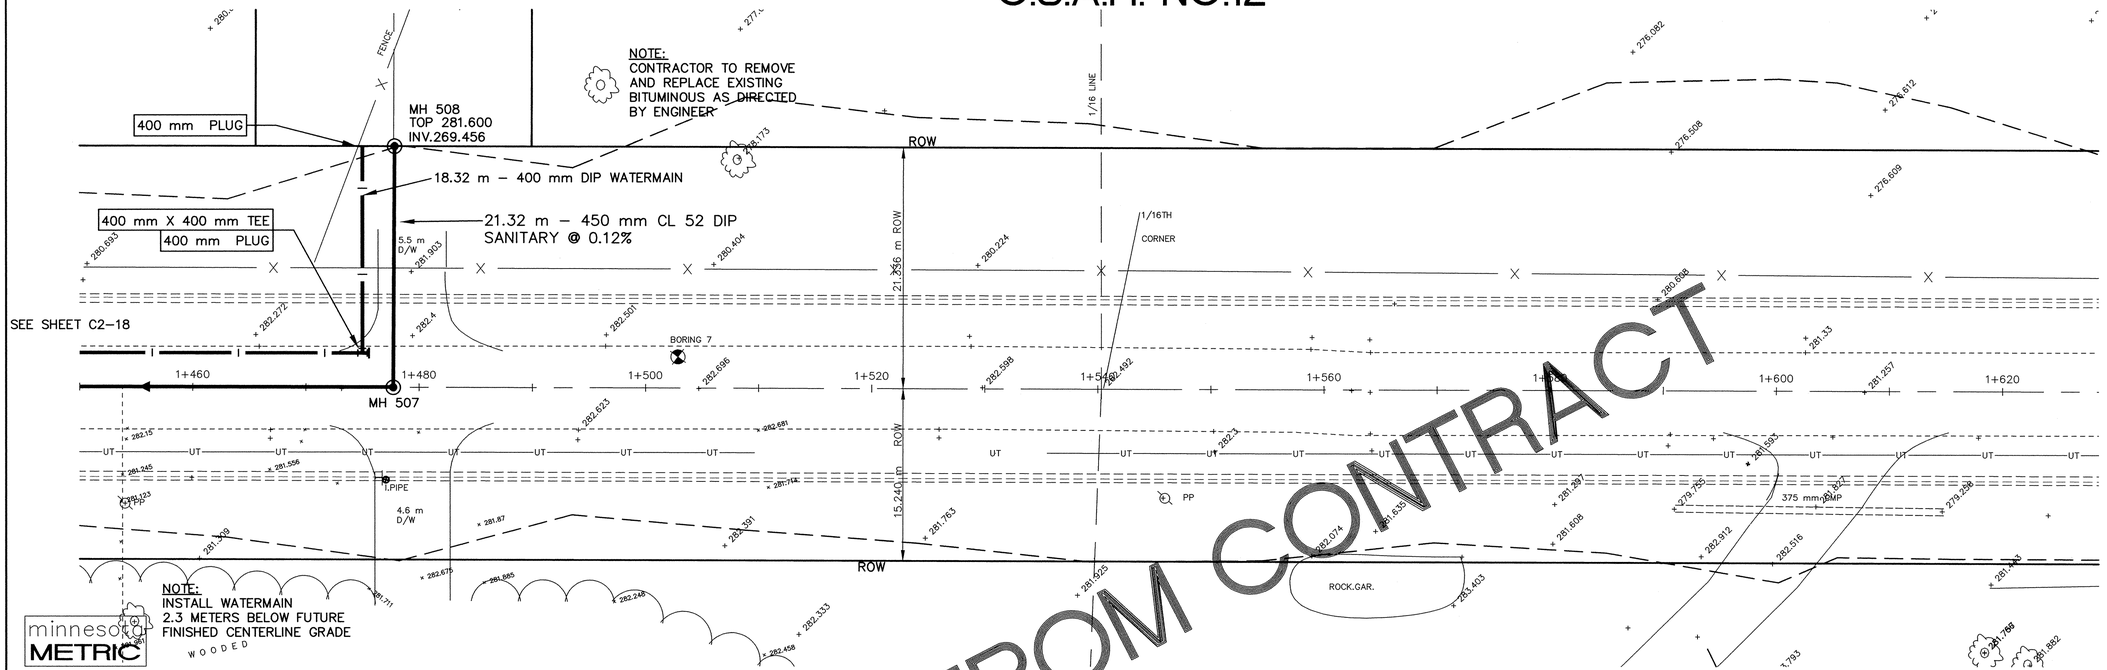

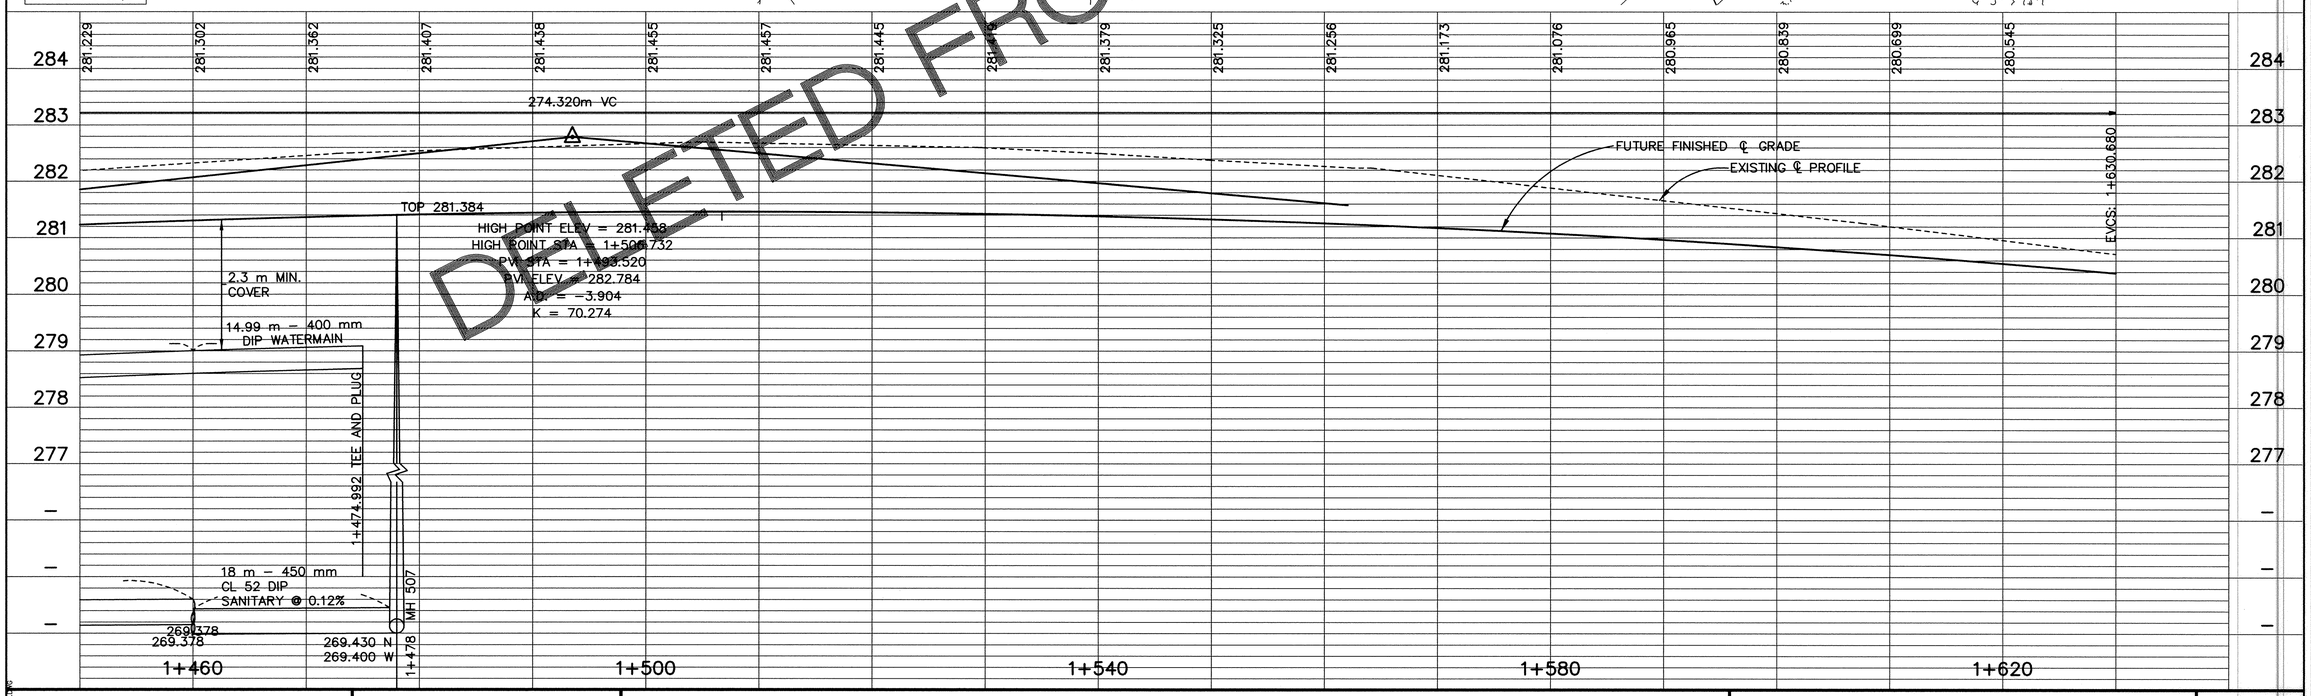

DELETED FROM CONTRACT

DESIGNED BY: _____ JOB DATE: JULY 1998
DRAWN BY: _____ JOB NUMBER 800110J
APPROVED: _____ CAD DATE: JULY 1998
CAD FILE: February 08, 1999 2:23:13 p.m. 800110J\Dwgs\BALDWIN\18.DWG

I HEREBY CERTIFY THAT THIS PLAN, SPECIFICATION, OR REPORT WAS PREPARED BY ME OR UNDER MY DIRECT SUPERVISION AND THAT I AM A DULY REGISTERED PROFESSIONAL ENGINEER UNDER THE LAWS OF THE STATE OF MINNESOTA.

DATE _____ REG.NO. 15316

NO.	DATE	BY	REVISION DESCRIPTION
1	1–19–99	PH	C.O. NO. 1

1326 ENERGY PARK DRIVE
ST. PAUL, MINNESOTA 55108
(612) 644–4389
Howard R. Green Company
CONSULTING ENGINEERS

CITY OF ELK RIVER
EASTERN AREA
PHASE I IMPROVEMENTS

WATERMAIN IMPROVEMENTS
C.S.A.H. NO.12
1+460 TO 1+620

SHEET NO.
C2-19

CONTRACT DOCUMENTS • PREPARED BY HOWARD R. GREEN COMPANY
CONTRACT DOCUMENTS • PREPARED BY HOWARD R. GREEN COMPANY
CONTRACT DOCUMENTS • PREPARED BY HOWARD R. GREEN COMPANY
EASTE1.98
104