FORCEMAIN

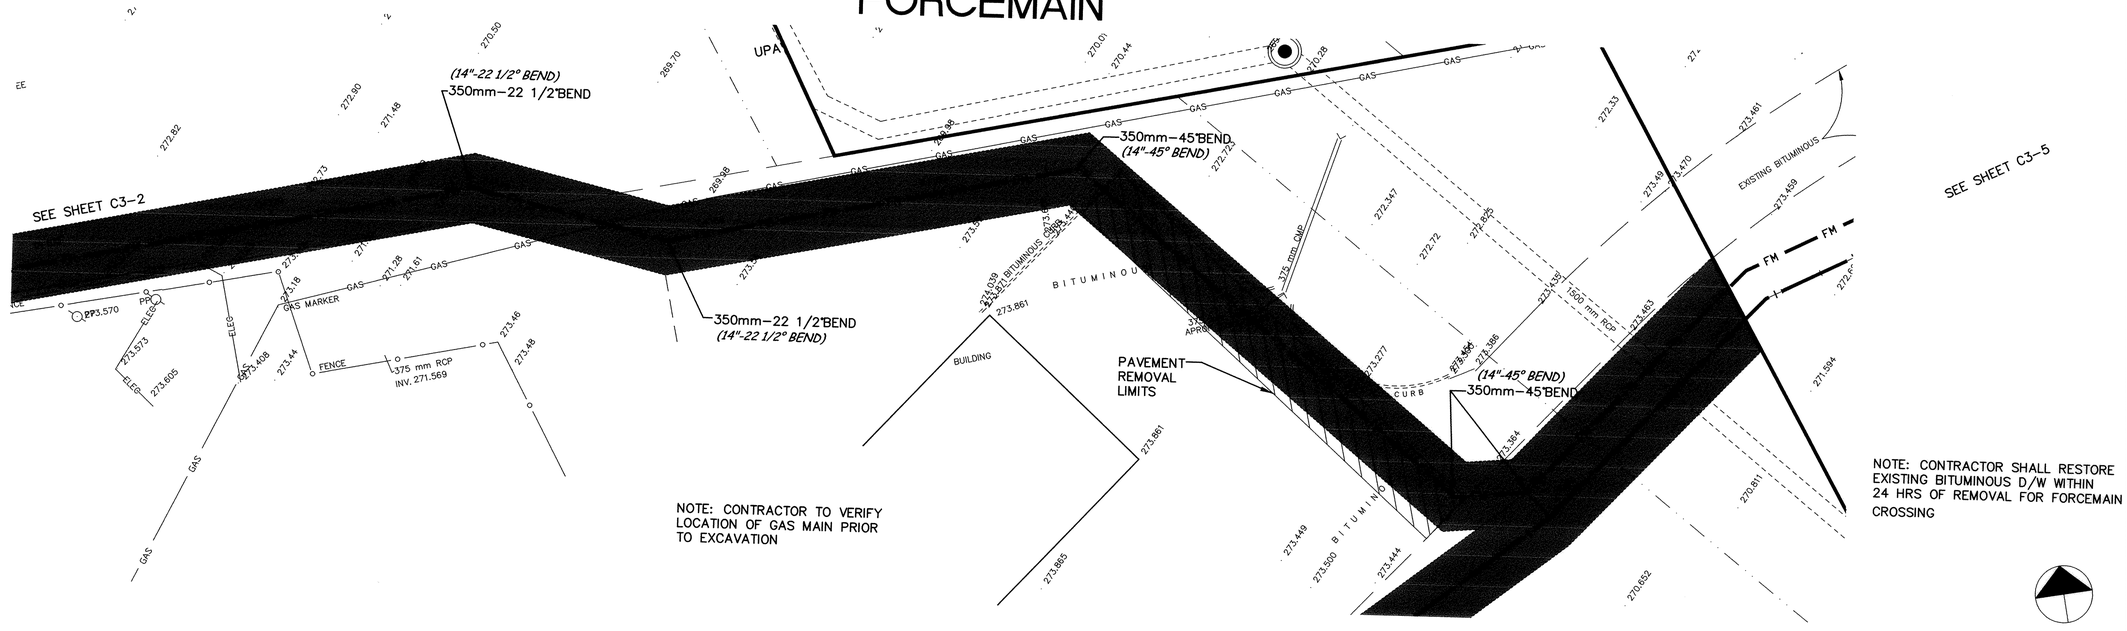

NOTE: CONTRACTOR TO VERIFY LOCATION OF GAS MAIN PRIOR TO EXCAVATION

NOTE: CONTRACTOR SHALL RESTORE EXISTING BITUMINOUS D/W WITHIN 24 HRS OF REMOVAL FOR FORCEMAIN CROSSING

FOR WATERMAIN CONSTRUCTION

minnesota METRIC

0 HORIZ (M) 10
1:250
0 VERT (M) 2
1:50

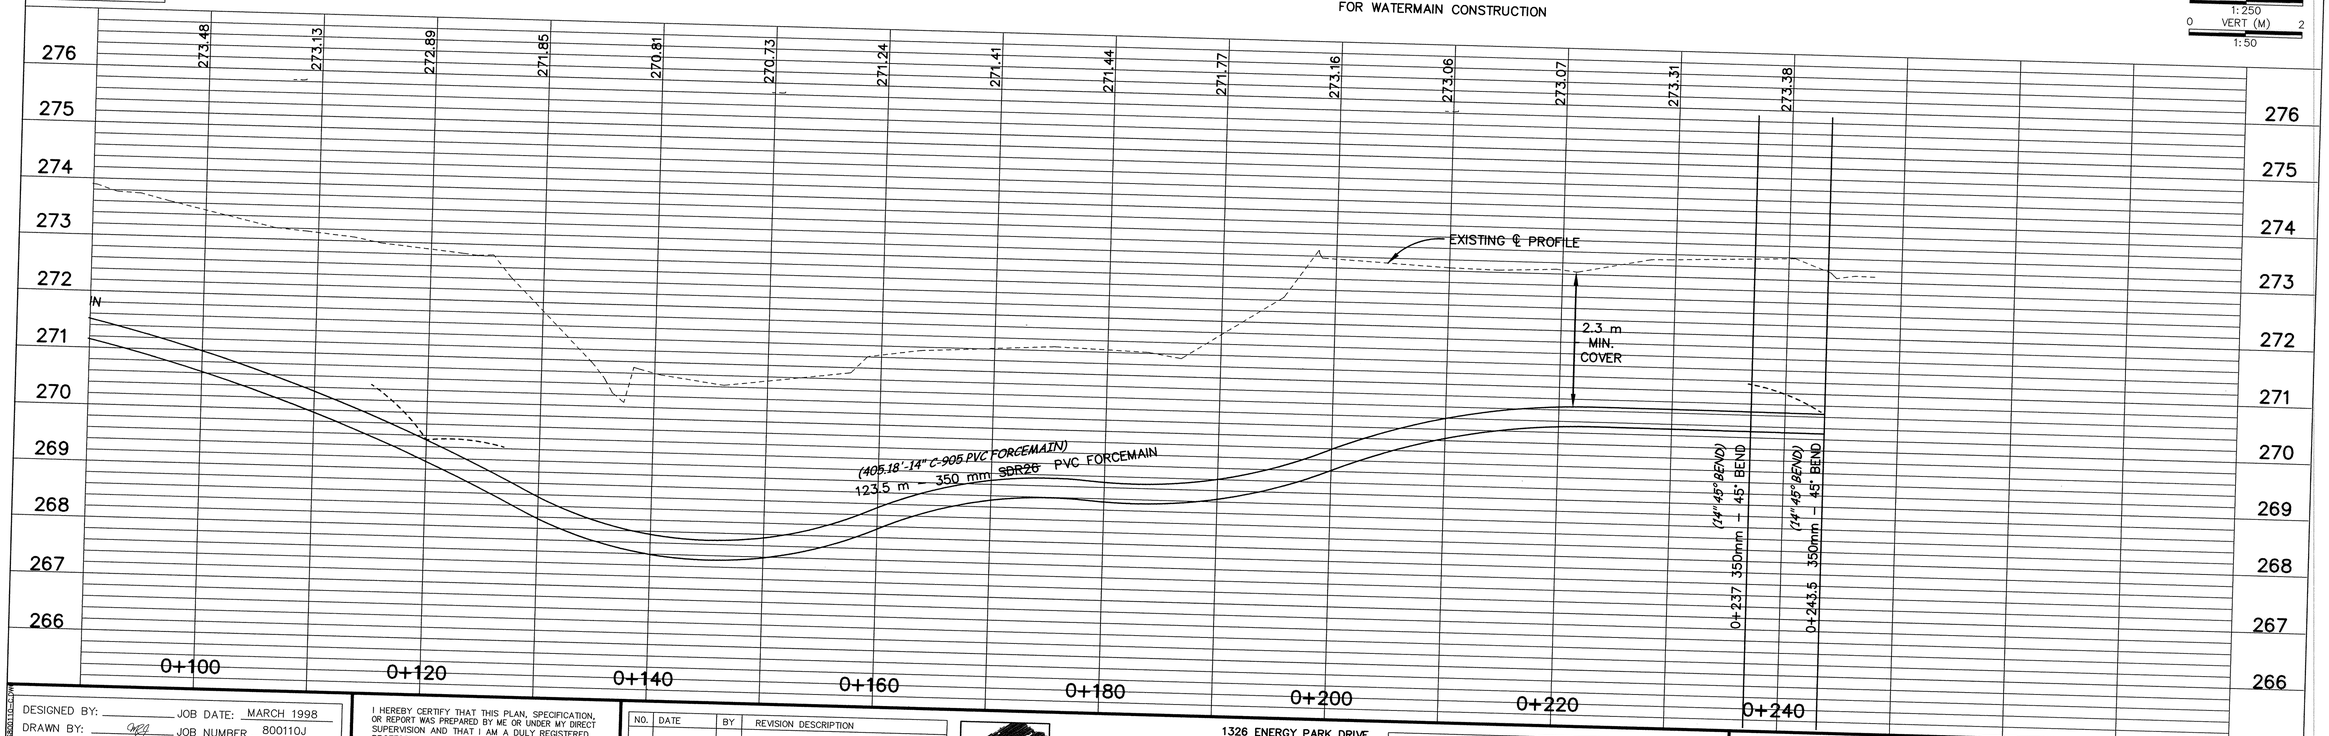

DESIGNED BY: _____ JOB DATE: MARCH 1998
DRAWN BY: MRJ JOB NUMBER 800110J
APPROVED: _____ CAD DATE: MARCH 1998
CAD FILE: March 29, 2001 2:35:35 p.m.
800110j\AS-BUILTS\Forcemain\ASF02.DWG

I HEREBY CERTIFY THAT THIS PLAN, SPECIFICATION, OR REPORT WAS PREPARED BY ME OR UNDER MY DIRECT SUPERVISION AND THAT I AM A DULY REGISTERED PROFESSIONAL ENGINEER UNDER THE LAWS OF THE STATE OF MINNESOTA.

DATE 10/15/98 REG.NO. 15316

NO.	DATE	BY	REVISION DESCRIPTION

Howard R. Green Company
CONSULTING ENGINEERS
1326 ENERGY PARK DRIVE
ST. PAUL, MINNESOTA 55108
(612) 644-4389

CITY OF ELK RIVER
EASTERN AREA
PHASE I IMPROVEMENTS

FORCEMAIN IMPROVEMENTS

0+120 TO 0+243.5

SHEET NO.
C3-3

DRAWING NUMBER

SAFCO PRODUCTS • NEW HOPE, MINNESOTA
REORDER BY PART NUMBER 65532

DRAWING NUMBER

SAFCO PRODUCTS • NEW HOPE, MINNESOTA
REORDER BY PART NUMBER 65532

DRAWING NUMBER

SAFCO PRODUCTS • NEW HOPE, MINNESOTA
REORDER BY PART NUMBER 65532

DRAWING NUMBER
EASTE 1.98
113