
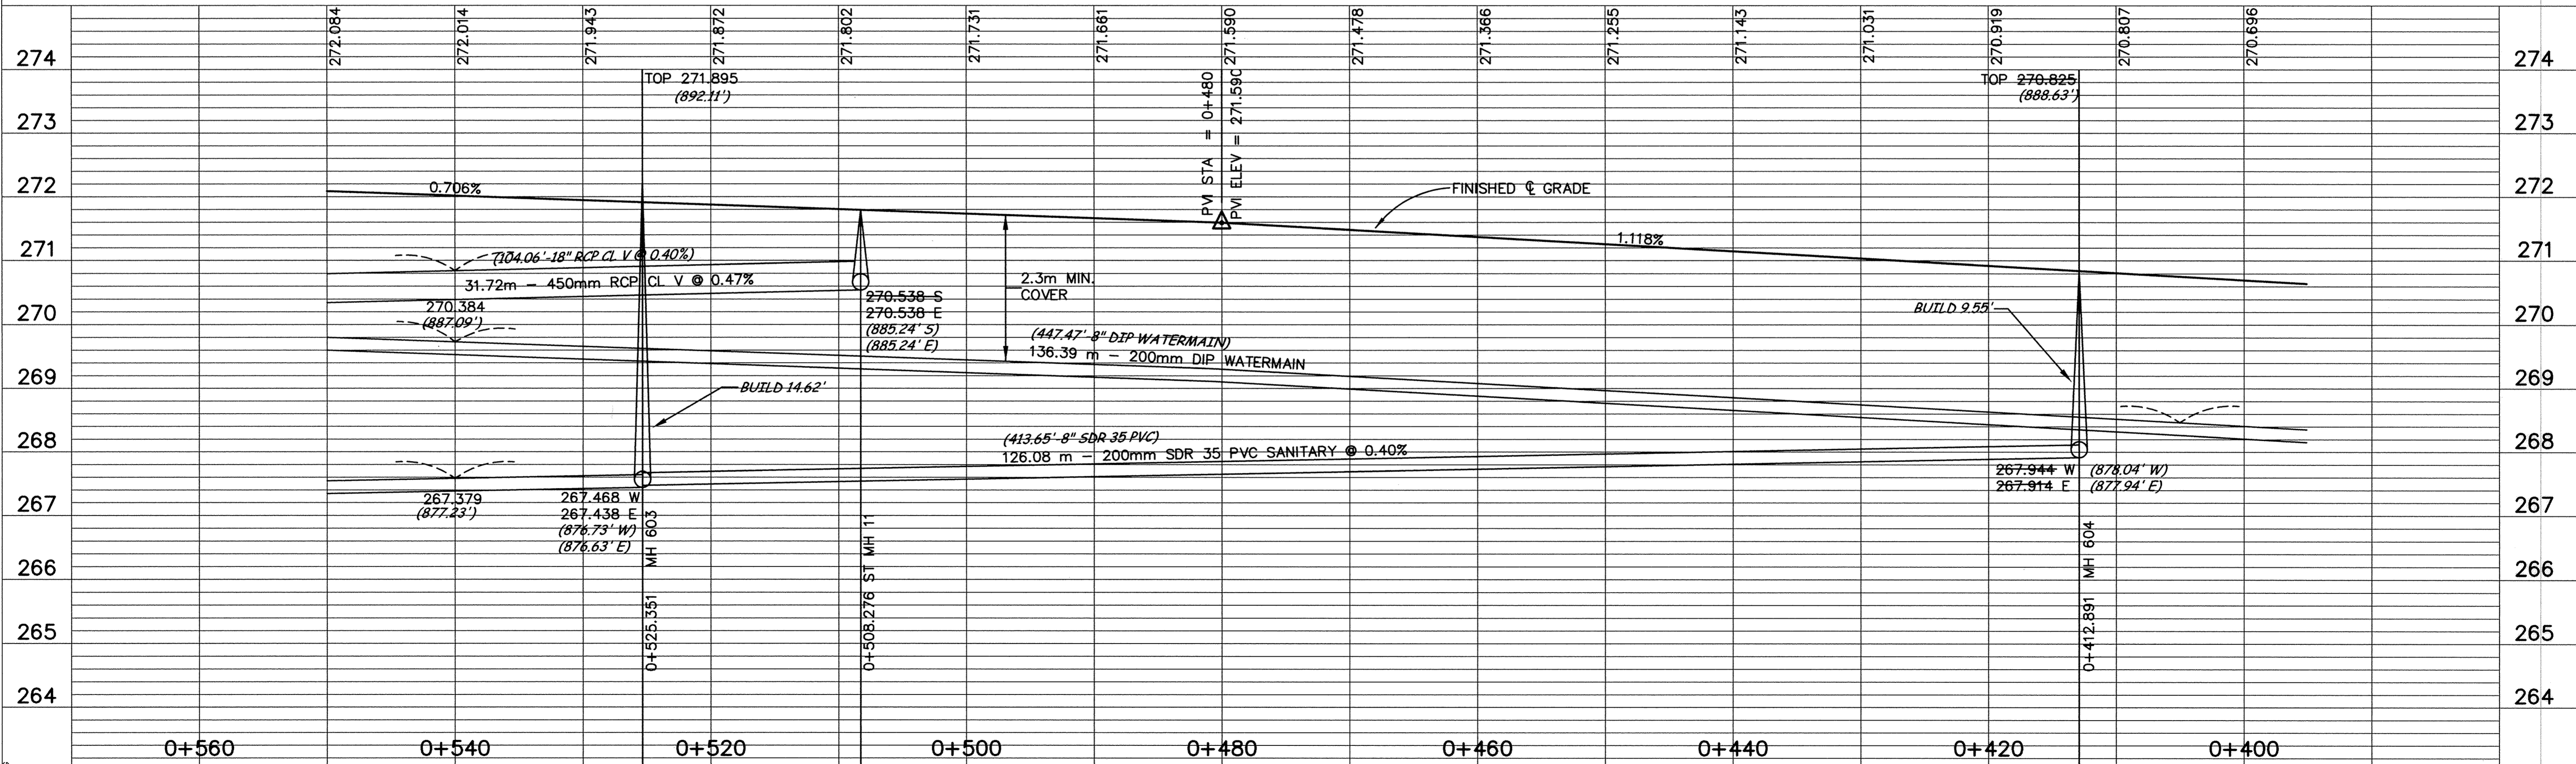
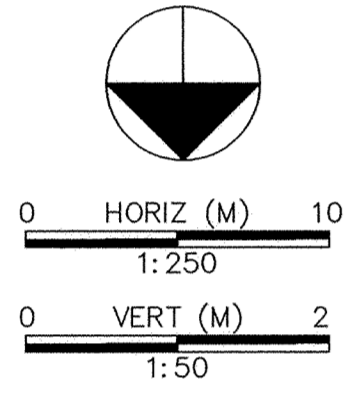


ELK RIVER BUSINESS PARK

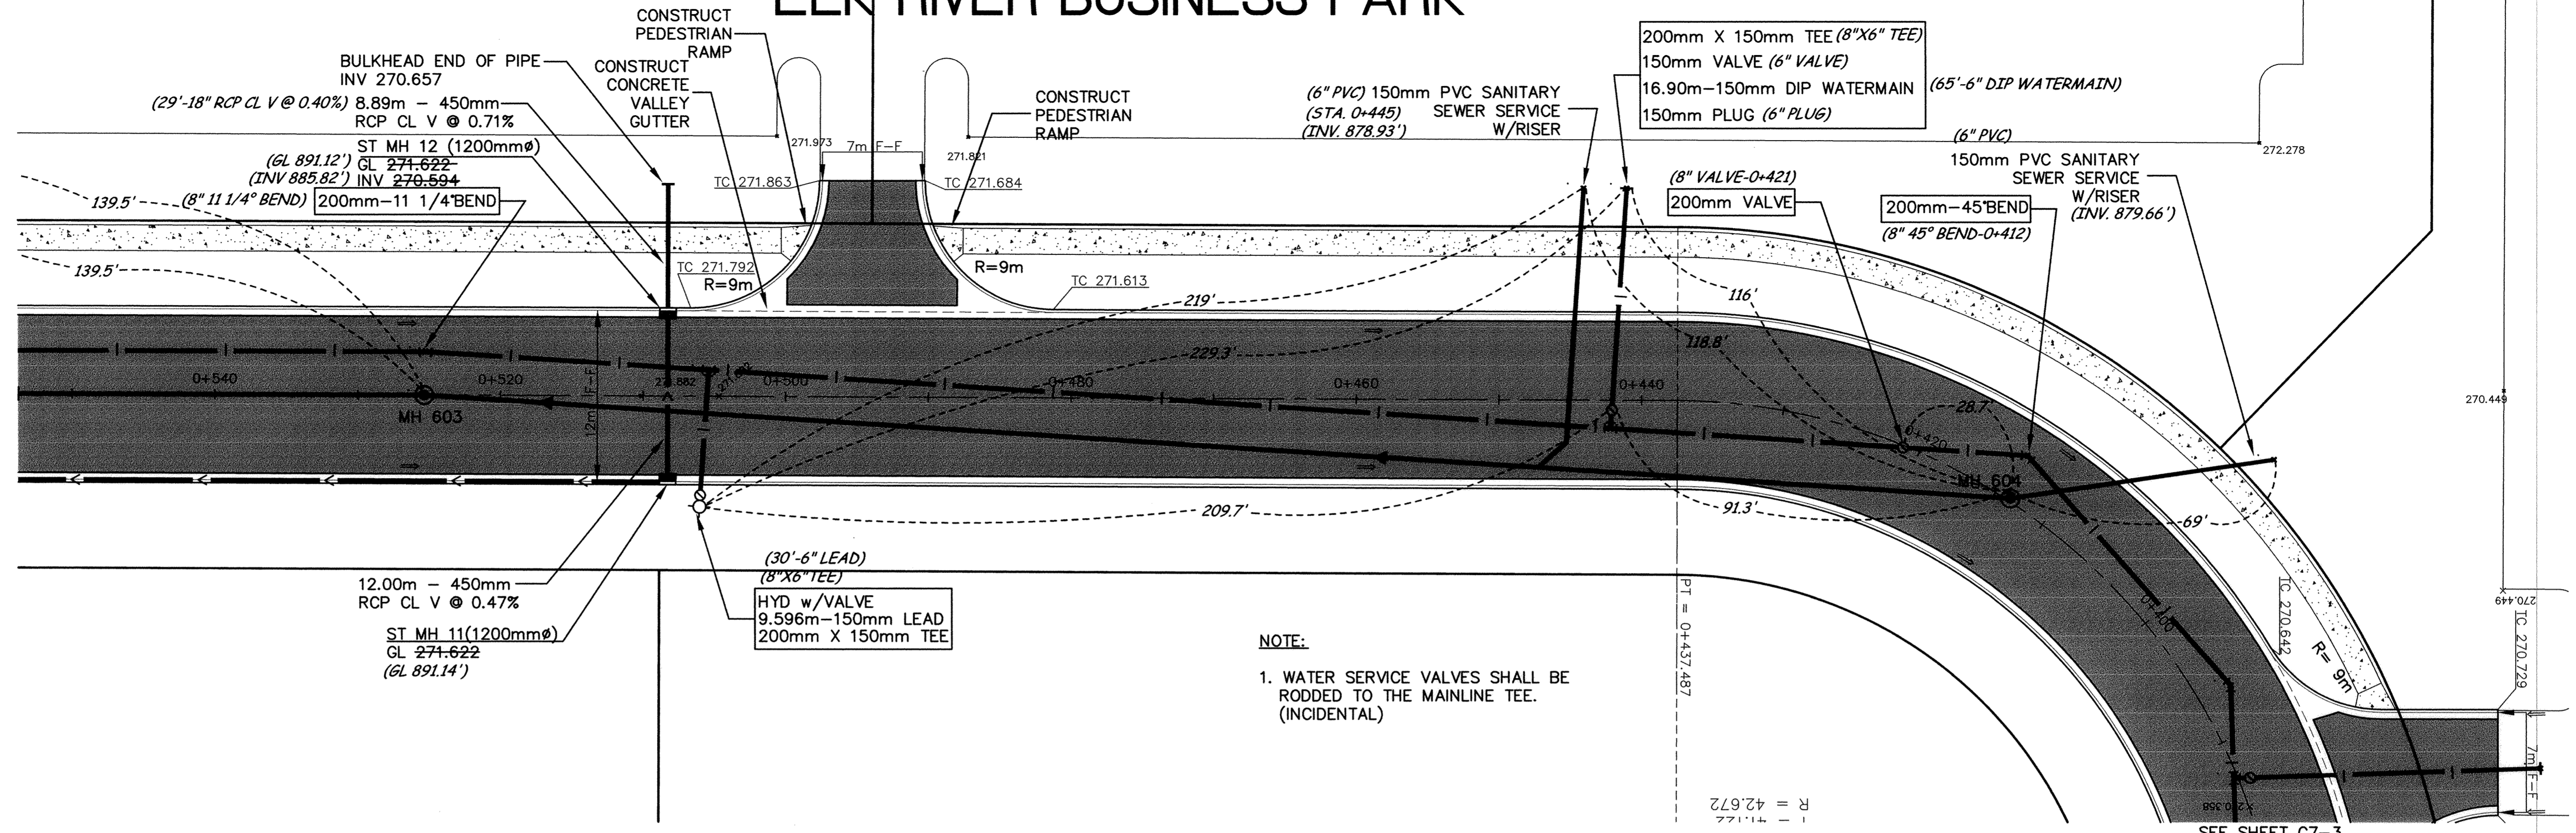

DESIGNED BY: JA JOB DATE: FEB 1999
DRAWN BY: LK JOB NUMBER: 800114J
APPROVED: CAD DATE:
CAD FILE: March 02, 1999 2:01:25 p.m.
800114J\800114_P4.DWG

I HEREBY CERTIFY THAT THIS PLAN, SPECIFICATION, OR REPORT WAS PREPARED BY ME OR UNDER MY DIRECT SUPERVISION AND THAT I AM A DULY REGISTERED PROFESSIONAL ENGINEER UNDER THE LAWS OF THE STATE OF MINNESOTA.

DATE: REG. NO.:

NO.	DATE	BY	REVISION DESCRIPTION
1	1/19/99	LK	CHANGE ORDER NO. 1

1326 ENERGY PARK DRIVE
ST. PAUL, MINNESOTA 55108
(612) 644-4389

Howard R. Green Company
CONSULTING ENGINEERS

CITY OF ELK RIVER
EASTERN AREA
PHASE I IMPROVEMENTS

STREET AND UTILITY IMPROVEMENTS
ELK RIVER BUSINESS PARK
0+405 TO 0+540

SHEET NO.
C7-4

DRAWING NUMBER
 EAST 198
 SACO PRODUCTS • NEW HOPE, MINNESOTA
 REORDER BY PART NUMBER 8582
 SACO PRODUCTS • NEW HOPE, MINNESOTA
 REORDER BY PART NUMBER 8582
 SACO PRODUCTS • NEW HOPE, MINNESOTA
 REORDER BY PART NUMBER 8582