NORTHWEST AREA

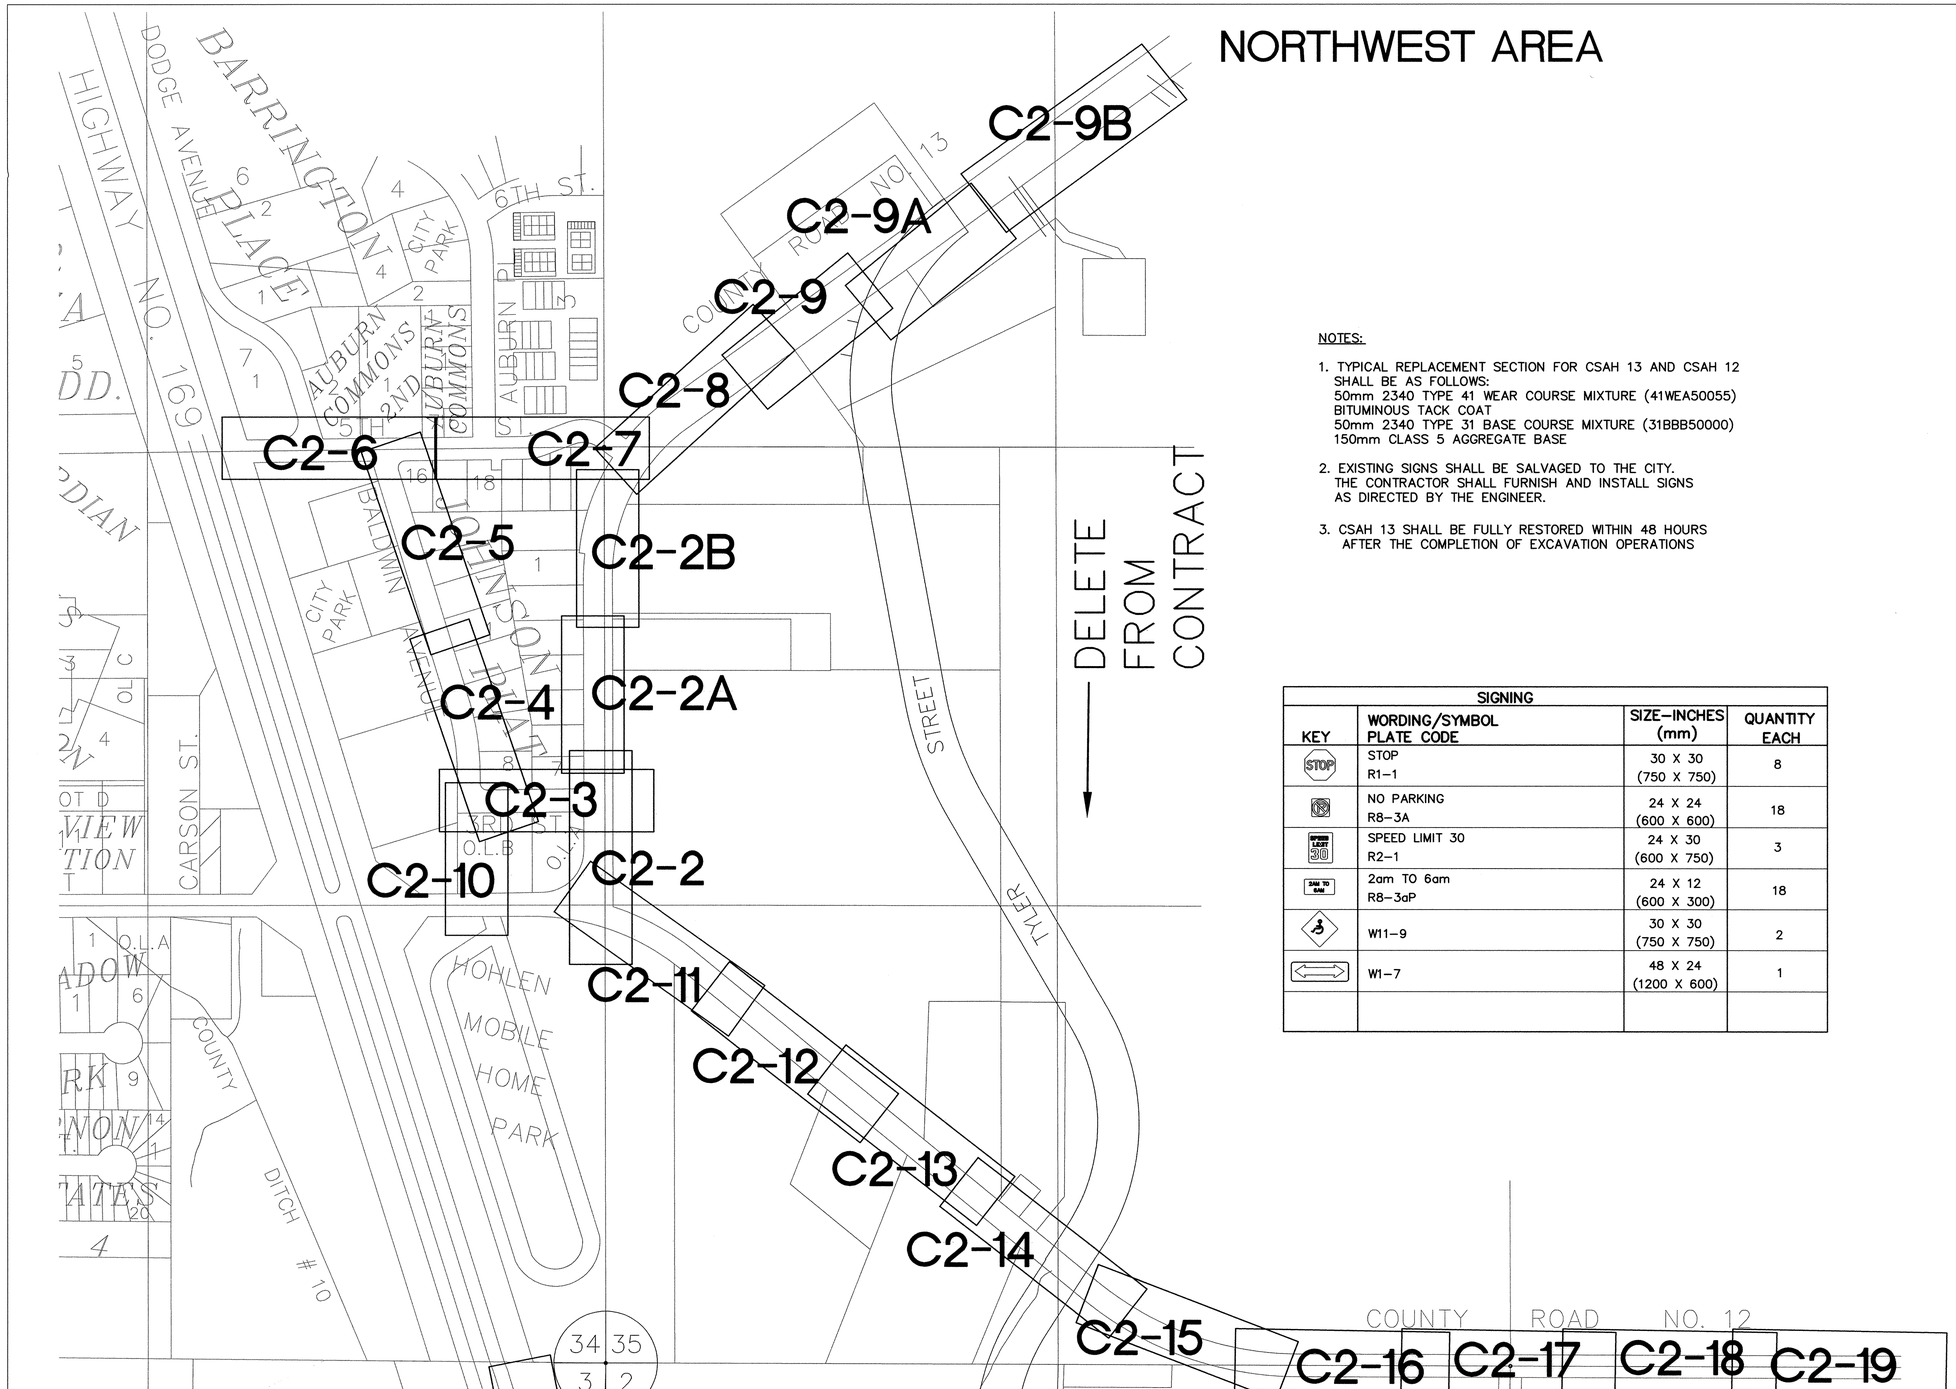

NOTES:

1. TYPICAL REPLACEMENT SECTION FOR CSAH 13 AND CSAH 12 SHALL BE AS FOLLOWS:
   50mm 2340 TYPE 41 WEAR COURSE MIXTURE (41WEA50055)
   BITUMINOUS TACK COAT
   50mm 2340 TYPE 31 BASE COURSE MIXTURE (31BBB50000)
   150mm CLASS 5 AGGREGATE BASE
2. EXISTING SIGNS SHALL BE SALVAGED TO THE CITY. THE CONTRACTOR SHALL FURNISH AND INSTALL SIGNS AS DIRECTED BY THE ENGINEER.
3. CSAH 13 SHALL BE FULLY RESTORED WITHIN 48 HOURS AFTER THE COMPLETION OF EXCAVATION OPERATIONS

SIGNING			
KEY	WORDING/SYMBOL PLATE CODE	SIZE–INCHES (mm)	QUANTITY EACH
STOP	STOP R1–1	30 X 30 (750 X 750)	8
	NO PARKING R8–3A	24 X 24 (600 X 600)	18
SPEED LIMIT 30	SPEED LIMIT 30 R2–1	24 X 30 (600 X 750)	3
2AM TO 6AM	2am TO 6am R8–3aP	24 X 12 (600 X 300)	18
	W11–9	30 X 30 (750 X 750)	2
	W1–7	48 X 24 (1200 X 600)	1

minnesota METRIC

0 100
1:2500

DESIGNED BY: AB JOB DATE: MARCH 1998
DRAWN BY: JOB NUMBER 800110J
APPROVED: CAD DATE:
CAD FILE: June 21, 2001 11:11:31 a.m. 800110j\AS–BUILTS\Misc\ASL05.DWG

Xref: LOCATION.DWG

I HEREBY CERTIFY THAT THIS PLAN, SPECIFICATION, OR REPORT WAS PREPARED BY ME OR UNDER MY DIRECT SUPERVISION AND THAT I AM A DULY REGISTERED PROFESSIONAL ENGINEER UNDER THE LAWS OF THE STATE OF MINNESOTA.

DATE _____ REG.NO. 15316

NO.	DATE	BY	REVISION DESCRIPTION
1	1–21–99	PH	ADDED SHEETS C2–2A, C2–2B C.O. NO.1

Howard R. Green Company
CONSULTING ENGINEERS
1326 ENERGY PARK DRIVE
ST. PAUL, MINNESOTA 55108
(612) 644–4389

CITY OF ELK RIVER
EASTERN AREA
PHASE I IMPROVEMENTS

STREET AND UTILITY IMPROVEMENTS
BALDWIN AVE./3RD ST./5TH ST.

SHEET NO.
C2-1

DRAWING NUMBER

DRAWING NUMBER

DRAWING NUMBER

DRAWING NUMBER
EASTE1.98
82