C.S.A.H. NO.12

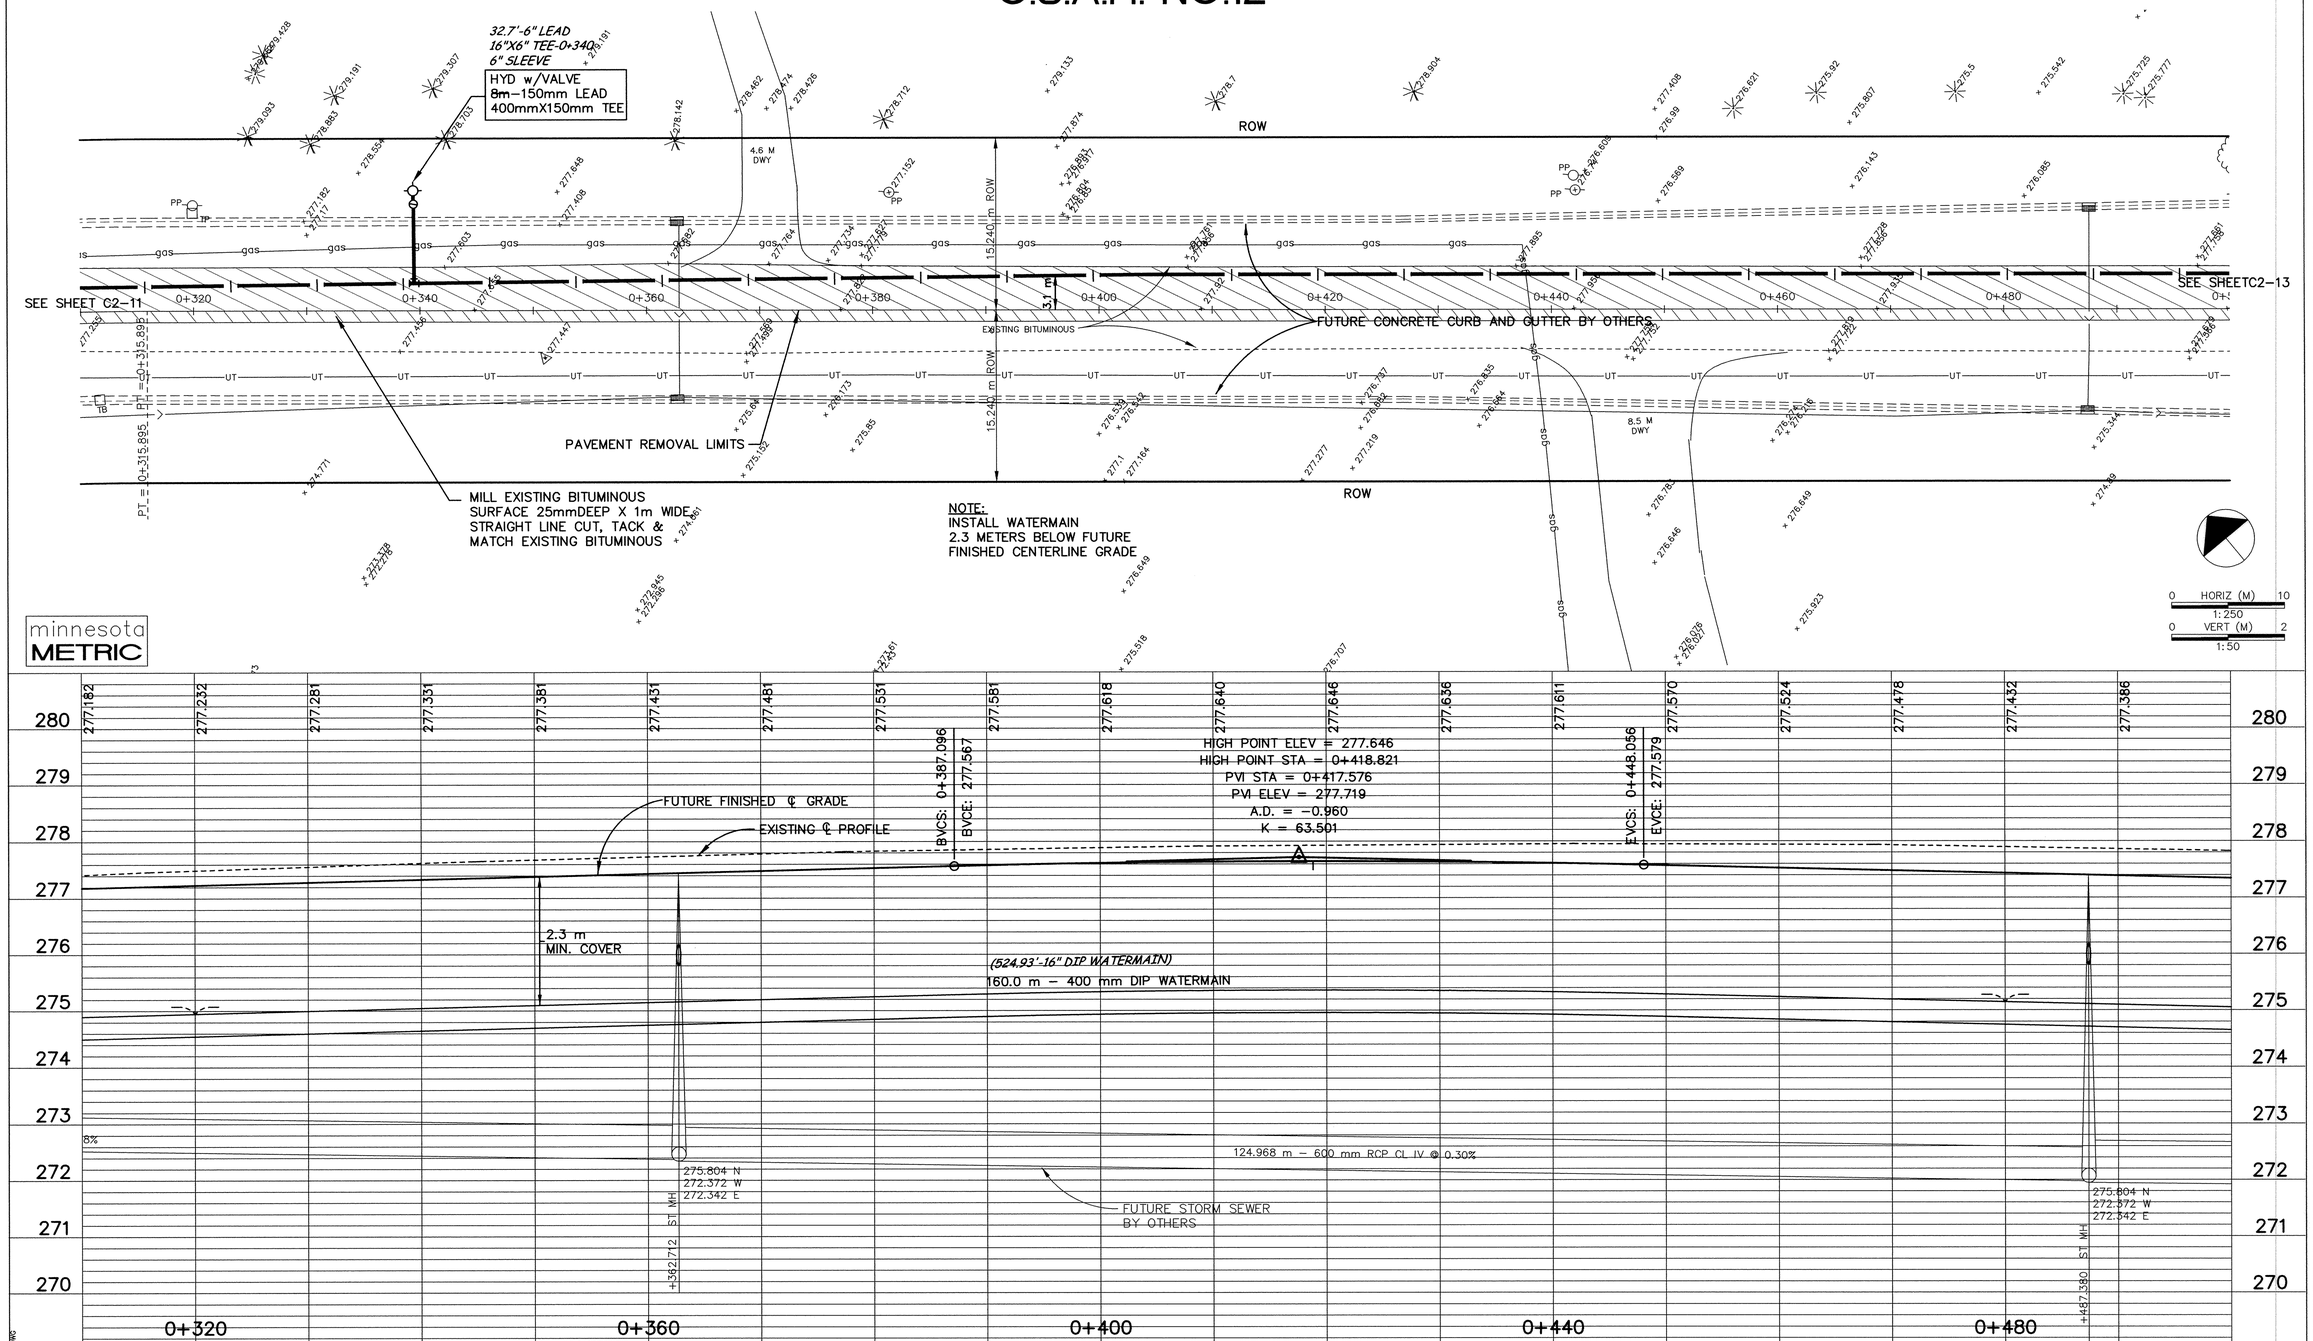

DESIGNED BY: _____ JOB DATE: JULY 1998
DRAWN BY: _____ JOB NUMBER 800110J
APPROVED: _____ CAD DATE: JULY 1998
CAD FILE: March 29, 2001 9:35:54 a.m.
800110j\AS-BUILTS\AS_BALDWIN-5TH\AS08.DWG

I HEREBY CERTIFY THAT THIS PLAN, SPECIFICATION, OR REPORT WAS PREPARED BY ME OR UNDER MY DIRECT SUPERVISION AND THAT I AM A DULY REGISTERED PROFESSIONAL ENGINEER UNDER THE LAWS OF THE STATE OF MINNESOTA.

DATE 10/15/98 REG.NO. 15316

NO.	DATE	BY	REVISION DESCRIPTION

Howard R. Green Company
CONSULTING ENGINEERS
1326 ENERGY PARK DRIVE
ST. PAUL, MINNESOTA 55108
(612) 644-4389

CITY OF ELK RIVER
EASTERN AREA
PHASE I IMPROVEMENTS

WATERMAIN IMPROVEMENTS
C.S.A.H. NO.12
0+320 TO 0+480

SHEET NO.
C2-12

DRAWING NUMBER
DRAWING NUMBER
DRAWING NUMBER
DRAWING NUMBER
EASTE1.98
97