CSAH 12

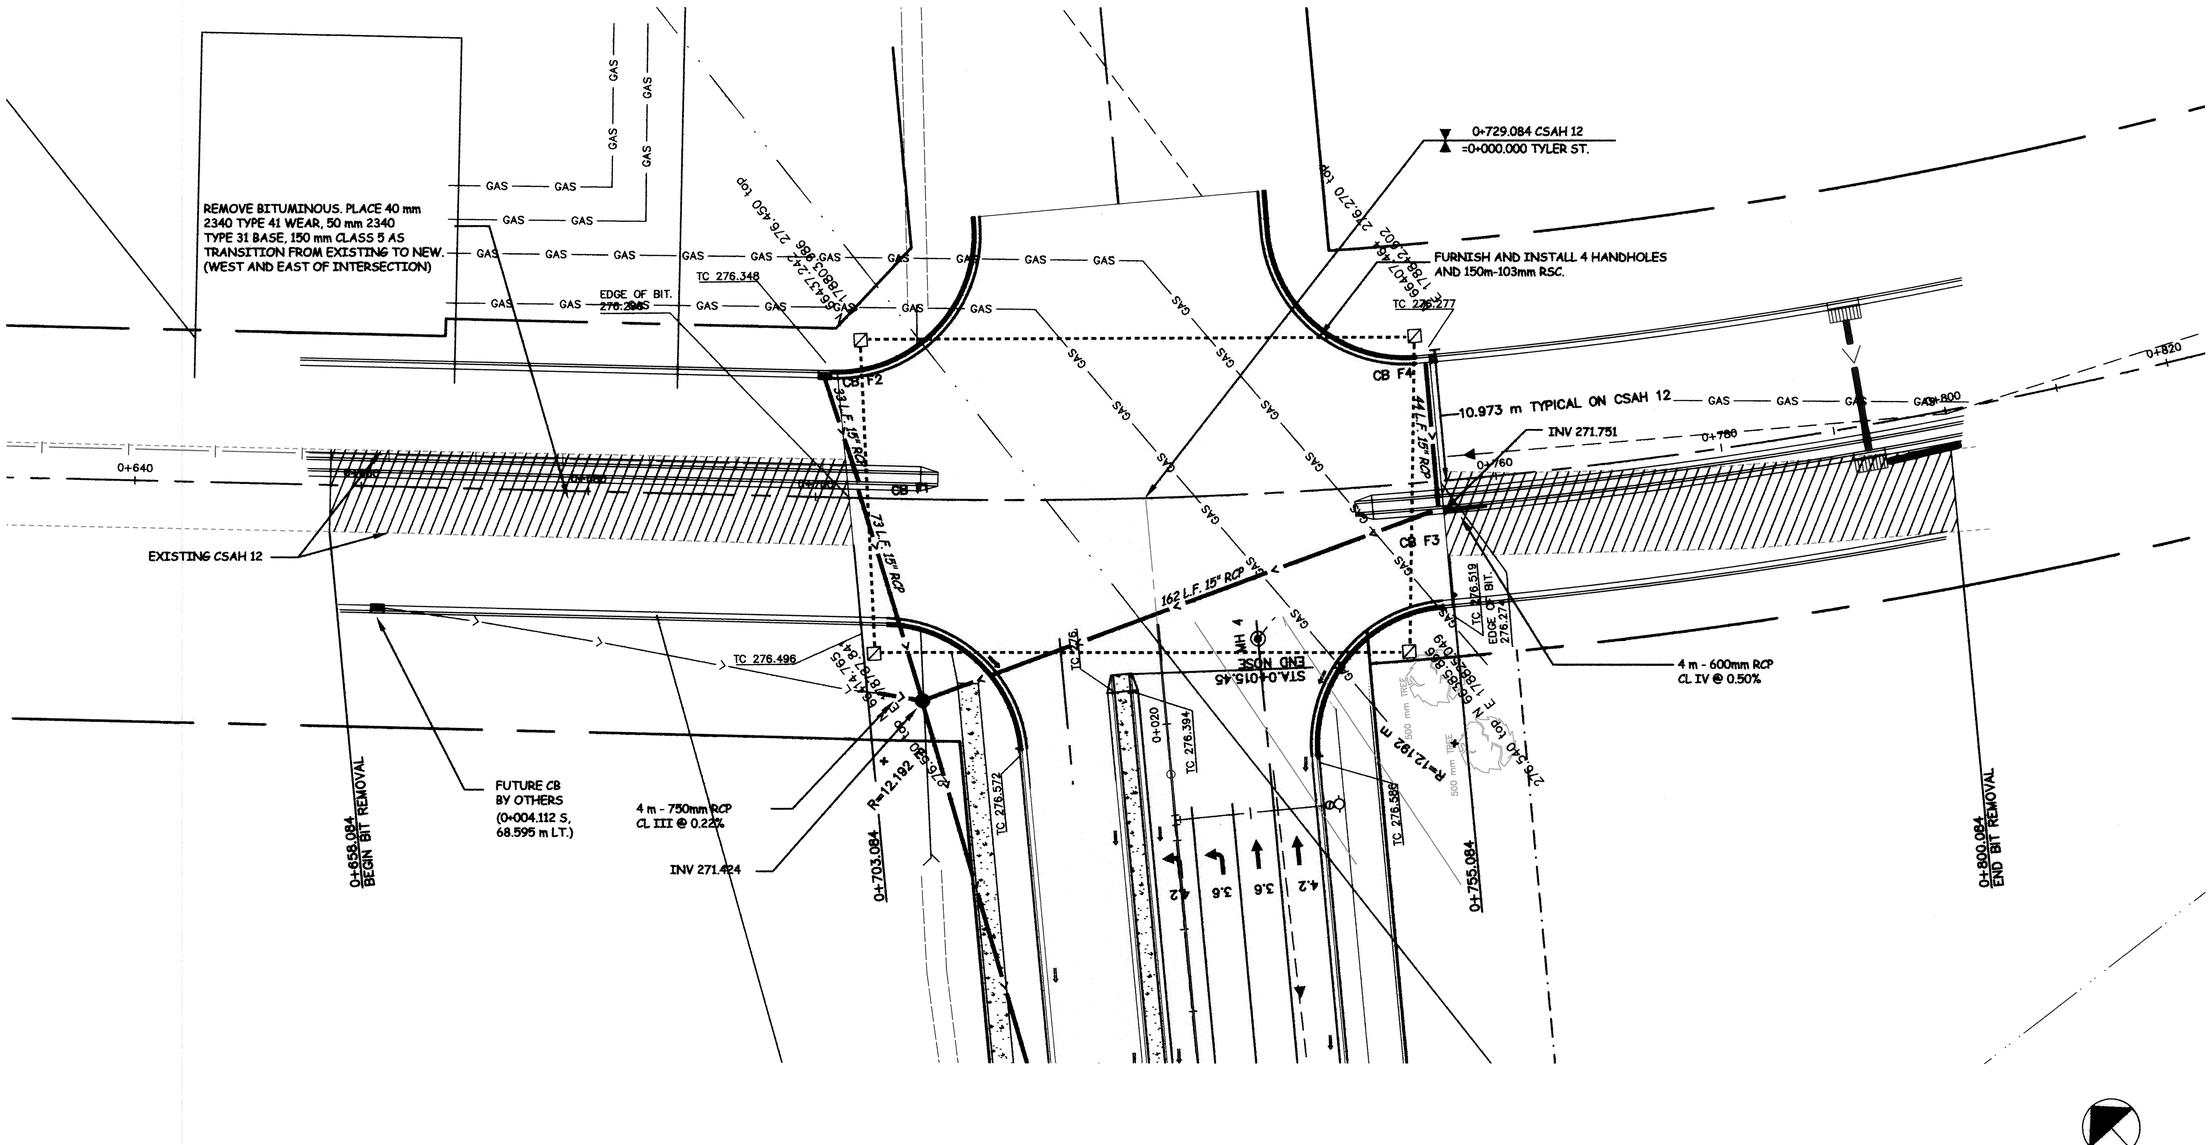

NOTE: CB F1 - CB F4 SHALL BE COVERED AND BURIED. CASTINGS ARE NEENAH R-3250-CV AND SHALL BE DELIVERED TO COUNTY HIGHWAY GARAGE.

RECORD PLAN
MARCH 2002

Xrefs: TYLER_BASE.DWG

DESIGNED BY: --- DRAWN BY: RM
APPROVED: --- JOB NUMBER 800110J
CAD DATE: April 16, 2002 11:39:21 a.m.
CAD FILE: 800110T\Asbuilts\S SEGMENT\18.DWG

I HEREBY CERTIFY THAT THIS PLAN, SPECIFICATION, OR REPORT WAS PREPARED BY ME OR UNDER MY DIRECT SUPERVISION AND THAT I AM A DULY REGISTERED PROFESSIONAL ENGINEER UNDER THE LAWS OF THE STATE OF MINNESOTA.

DATE _____ REG.NO. _____

NO.	DATE	BY	REVISION DESCRIPTION
1.	11-8-99	RM	REVISE GAS LOCATION

1326 ENERGY PARK DRIVE
ST. PAUL, MINNESOTA 55108
(612) 644-4389
Howard R. Green Company
CONSULTING ENGINEERS

CITY OF ELK RIVER
EASTERN AREA
TYLER STREET IMPROVEMENTS

PLAN OF C.S.A.H. 12
SP 71-613-08, SP 204-020-03, SP 204-133-01, SP 204-132-03

SHEET NO.
C1-1

DRAWING NUMBER
SAFCO PRODUCTS • NEW HOPE, MINNESOTA
RECORDER BY PART NUMBER 65555
Photocopy copy of reader this page
DRAWING NUMBER
SAFCO PRODUCTS • NEW HOPE, MINNESOTA
RECORDER BY PART NUMBER 65555
Photocopy copy of reader this page
