TYLER STREET

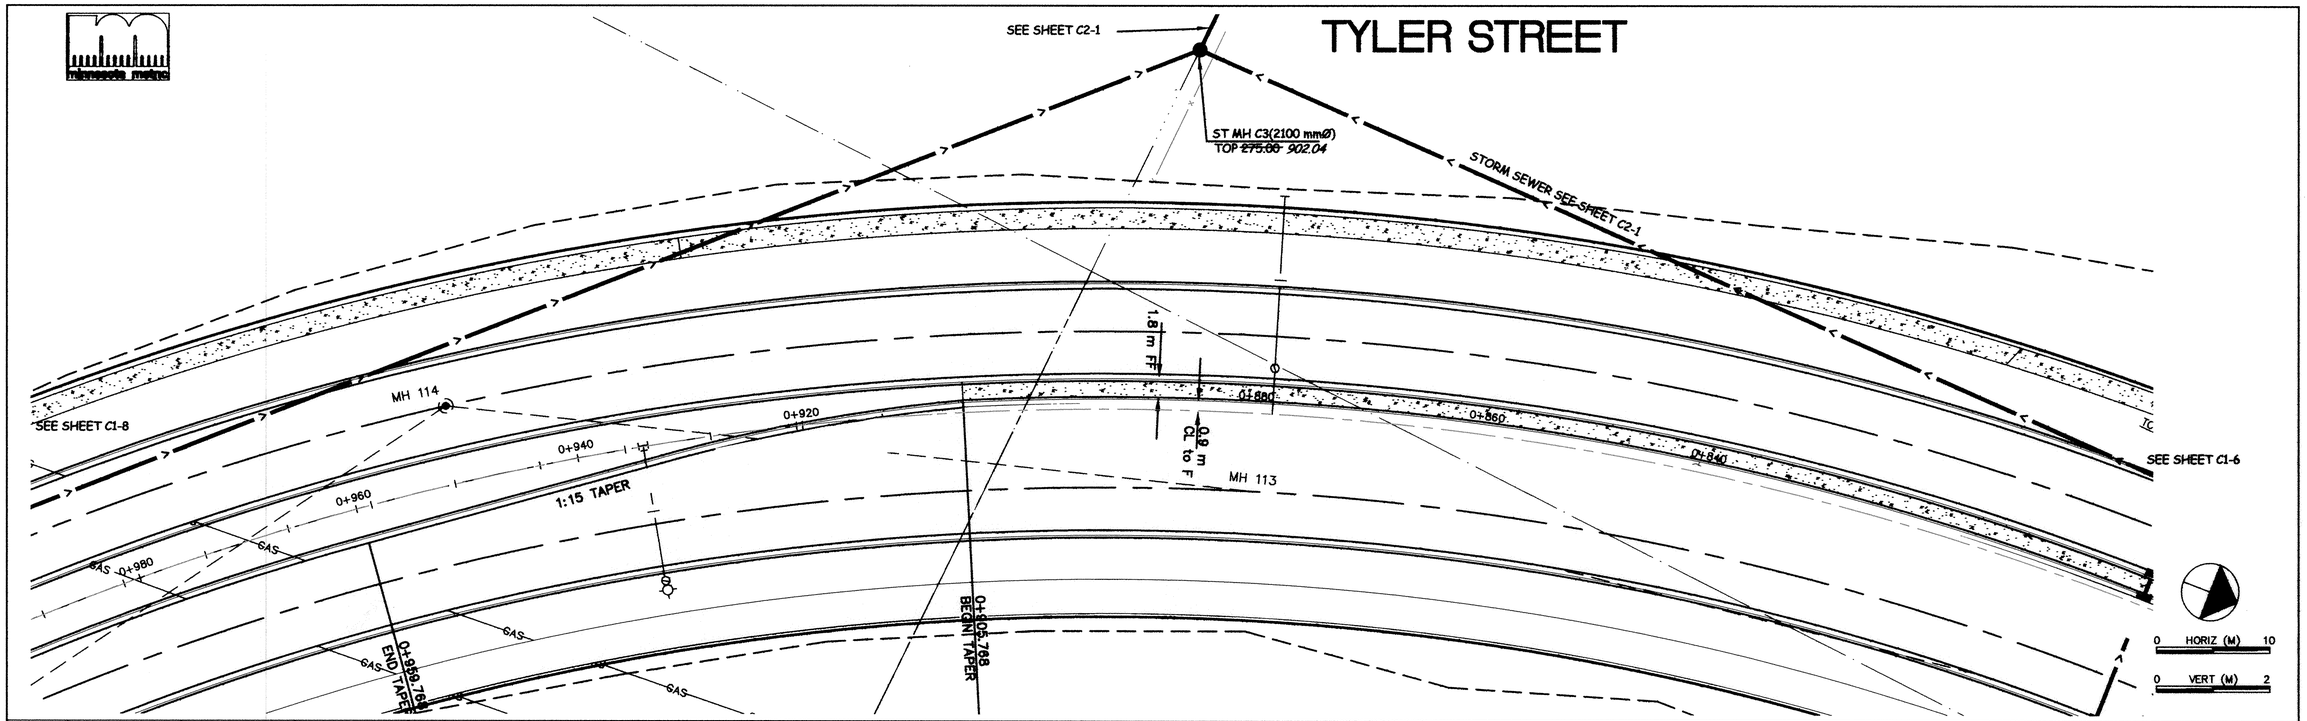

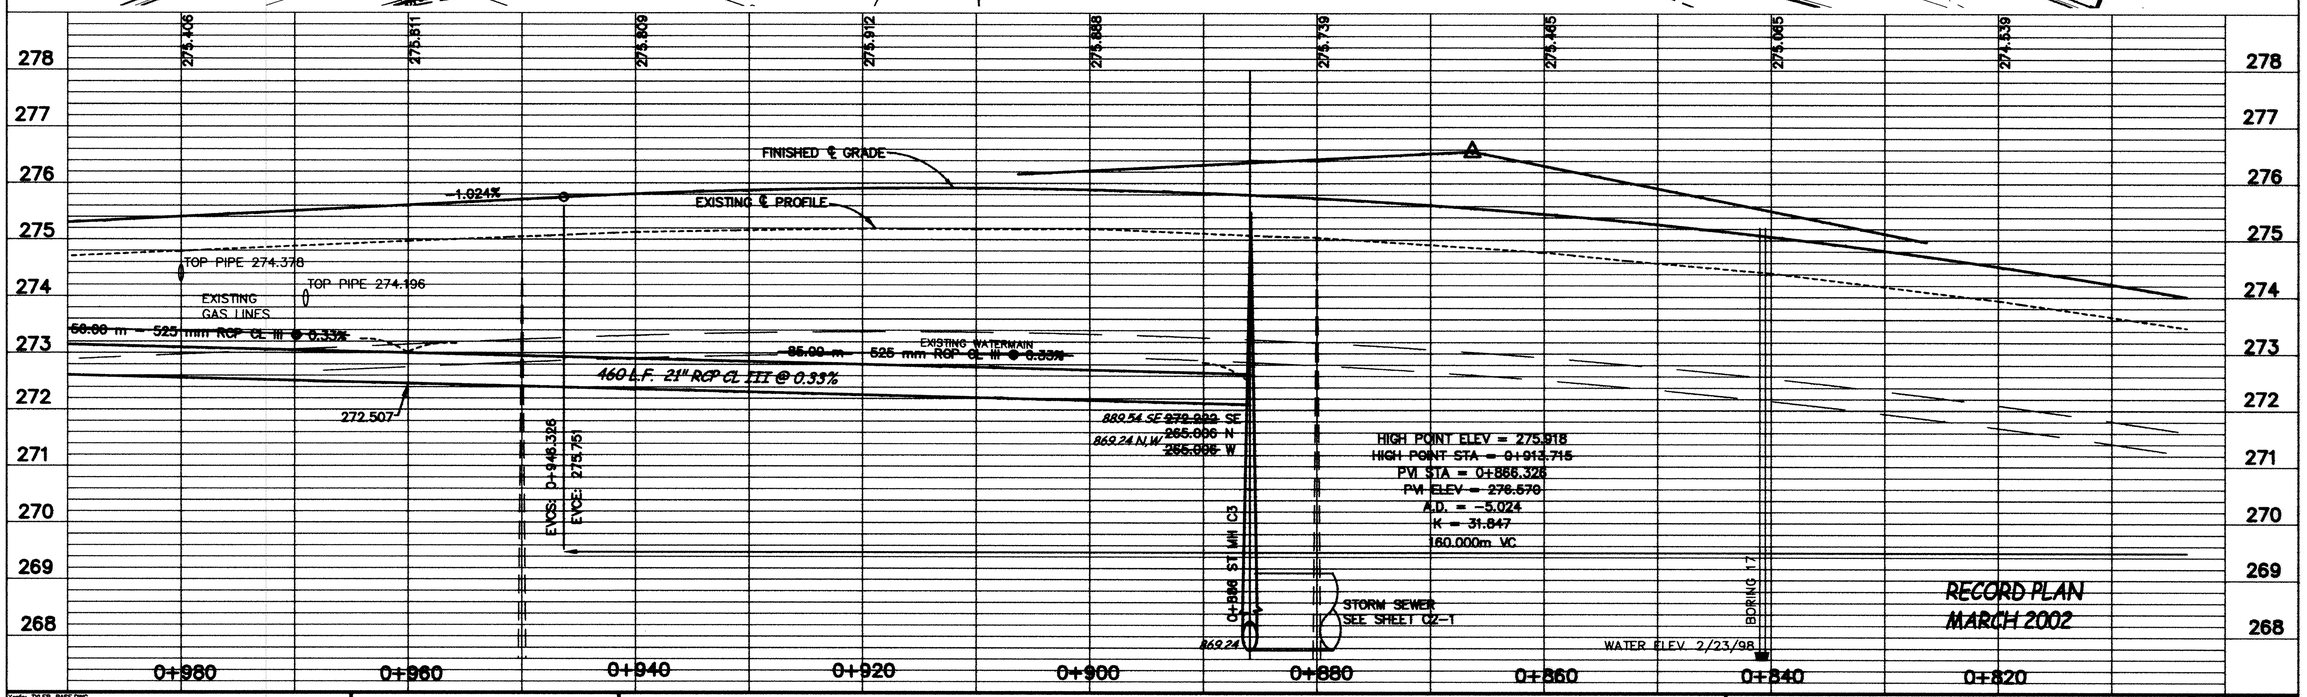

Xrefs: TYLER_BASE.DWG

DESIGNED BY: ---	DRAWN BY:		
APPROVED: ---	JOB NUMBER	800110J	
CAD DATE: April 16, 2002 1:15:26 p.m.			
CAD FILE: 800110T\Asbuilts\S SEGMENT\06.DWG			

I HEREBY CERTIFY THAT THIS PLAN, SPECIFICATION, OR REPORT WAS PREPARED BY ME OR UNDER MY DIRECT SUPERVISION AND THAT I AM A DULY REGISTERED PROFESSIONAL ENGINEER UNDER THE LAWS OF THE STATE OF MINNESOTA.

DATE _____ REG.NO. _____

NO.	DATE	BY	REVISION DESCRIPTION
1.	11-8-99	RM	REVISE STORM SEWER & PROFILE

1326 ENERGY PARK DRIVE
ST. PAUL, MINNESOTA 55108
(612) 644-4369
Howard R. Green Company
CONSULTING ENGINEERS

CITY OF ELK RIVER
EASTERN AREA
TYLER STREET IMPROVEMENTS

PLAN + PROFILE S. OF C.S.A.H. 12
SP 71-613-08, SP 204-020-03, SP 204-133-01, SP 204-132-03
0+810 TO 0+980

SHEET NO.
C1-7

DRAWING NUMBER