TYLER STREET

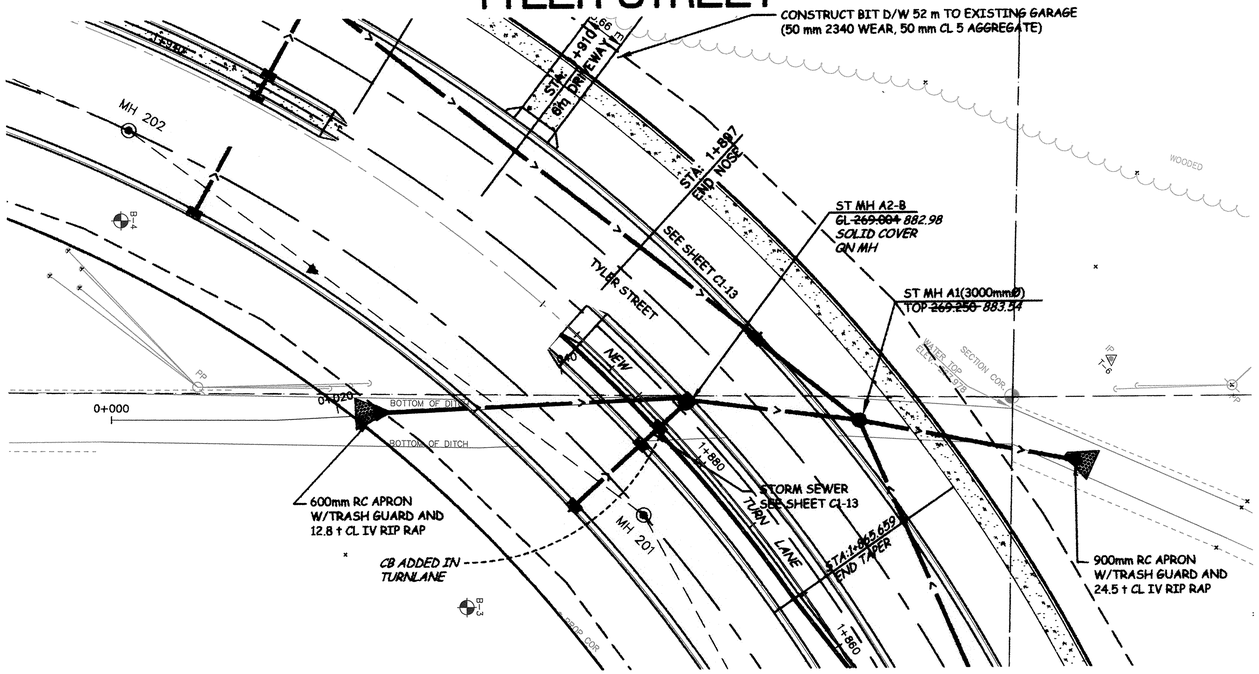

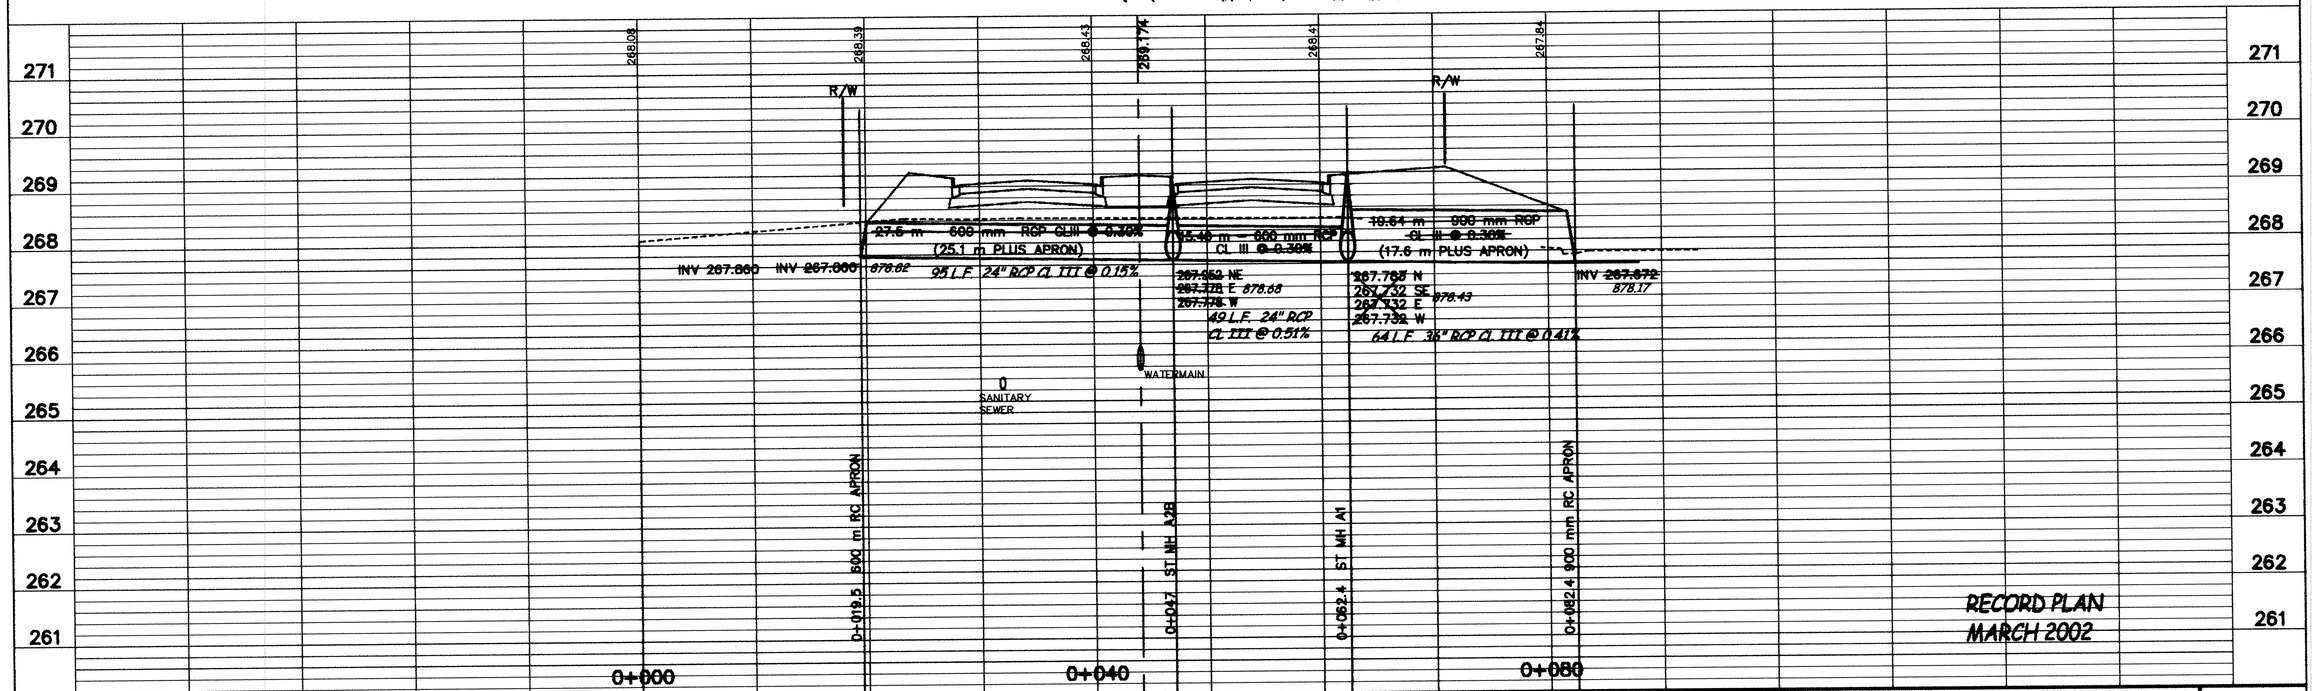

DESIGNED BY: AB	JOB DATE: MARCH 1998		
DRAWN BY:	JOB NUMBER 800110J		
APPROVED:	CAD DATE:		
CAD FILE: April 17, 2002 8:34:17 a.m. 800110T\\sbuilts\S SEGMENT\13A.DWG			

I HEREBY CERTIFY THAT THIS PLAN, SPECIFICATION, OR REPORT WAS PREPARED BY ME OR UNDER MY DIRECT SUPERVISION AND THAT I AM A DULY REGISTERED PROFESSIONAL ENGINEER UNDER THE LAWS OF THE STATE OF MINNESOTA.

DATE _____ REG.NO. _____

NO.	DATE	BY	REVISION DESCRIPTION
1.	11-8-99	RM	BIT D/W NOTES

Howard R. Green Company
CONSULTING ENGINEERS
1326 ENERGY PARK DRIVE
ST. PAUL, MINNESOTA 55108
(612) 644-4389

CITY OF ELK RIVER
EASTERN AREA
TYLER STREET IMPROVEMENTS

PLAN + PROFILE S. OF C.S.A.H. 12
SP 71-613-08, SP 204-020-03, SP 204-133-01, SP 204-132-03

SHEET NO.
C1-13A

DRAWING NUMBER
EASTE.01
29

SAFCO PRODUCTS • NEW HOPE, MINNESOTA
REORDER BY PART NUMBER 65502
PERFORATION EDGE OF PAPER ON THIS LINE