TYLER STREET

minnesota metric

ST MH A1(3000mmØ)
TOP ~~269.258~~ *883.54*

ST MH A2
GL ~~269.004~~ *882.64*

ST MH A2-B
(1350 mmØ)
GL ~~269.004~~ *882.98*
INV ~~267.952~~ NE
INV ~~267.778~~ E *878.68*
INV ~~267.778~~ W

ROAD REMOVED BY OTHERS

CB B2-B
GL ~~269.394~~
INV ~~268.341~~
GL ~~883.75~~
INV 880.05

8.40m - 375mm
RCP CL V @ 1.00%

EDGE OF BRUSH

ST MH B2(1500mmØ)
GL ~~269.394~~
883.64

5.40 m - 375 mm
RCP CL V @ 1.00%

DRIVEWAY LOCATION
TO BE VERIFIED IN
THE FIELD

8.40 m - 375 mm
RCP CL V @ 1.00%

ST MH A3(1350mmØ)
GL ~~269.243~~
883.14

STORM SEWER
SEE SHEET C1-13A

REMOVE BITUMINOUS
PAVEMENT

SEE SHEET C1-12

GL *883.26*
INV *879.86*
CB A3-B
GL ~~269.243~~
INV ~~268.190~~

1.80 m - 375 mm
RCP CL V @ 1.00%

SEE SHEET C1-14

12.00 m - 375 mm
RCP CL V @ 1.00%

CB A3-C
~~880.22~~ GL ~~269.171~~
~~880.22~~ INV ~~268.209~~

CB A3-D
GL ~~269.243~~ *883.22*
INV ~~268.329~~ *880.42*

CB A2-D
GL ~~269.004~~
882.73
879.73 INV ~~268.898~~

5.40 m - 375 mm
RCP CL V @ 1.00%

CB A2-C
GL ~~269.004~~ *882.68*
INV ~~268.886~~ *879.48*

8.40 m - 375 mm
RCP CL V @ 1.00%

CB B2-C
GL 269.394 *883.72*
INV ~~268.396~~ *880.32*

8.40 m - 375 mm
RCP CL V @ 1.00%

CB B2-D
GL ~~269.394~~ *883.69*
INV ~~268.466~~ *880.69*

0 HORIZ (M) 10
0 VERT (M) 2

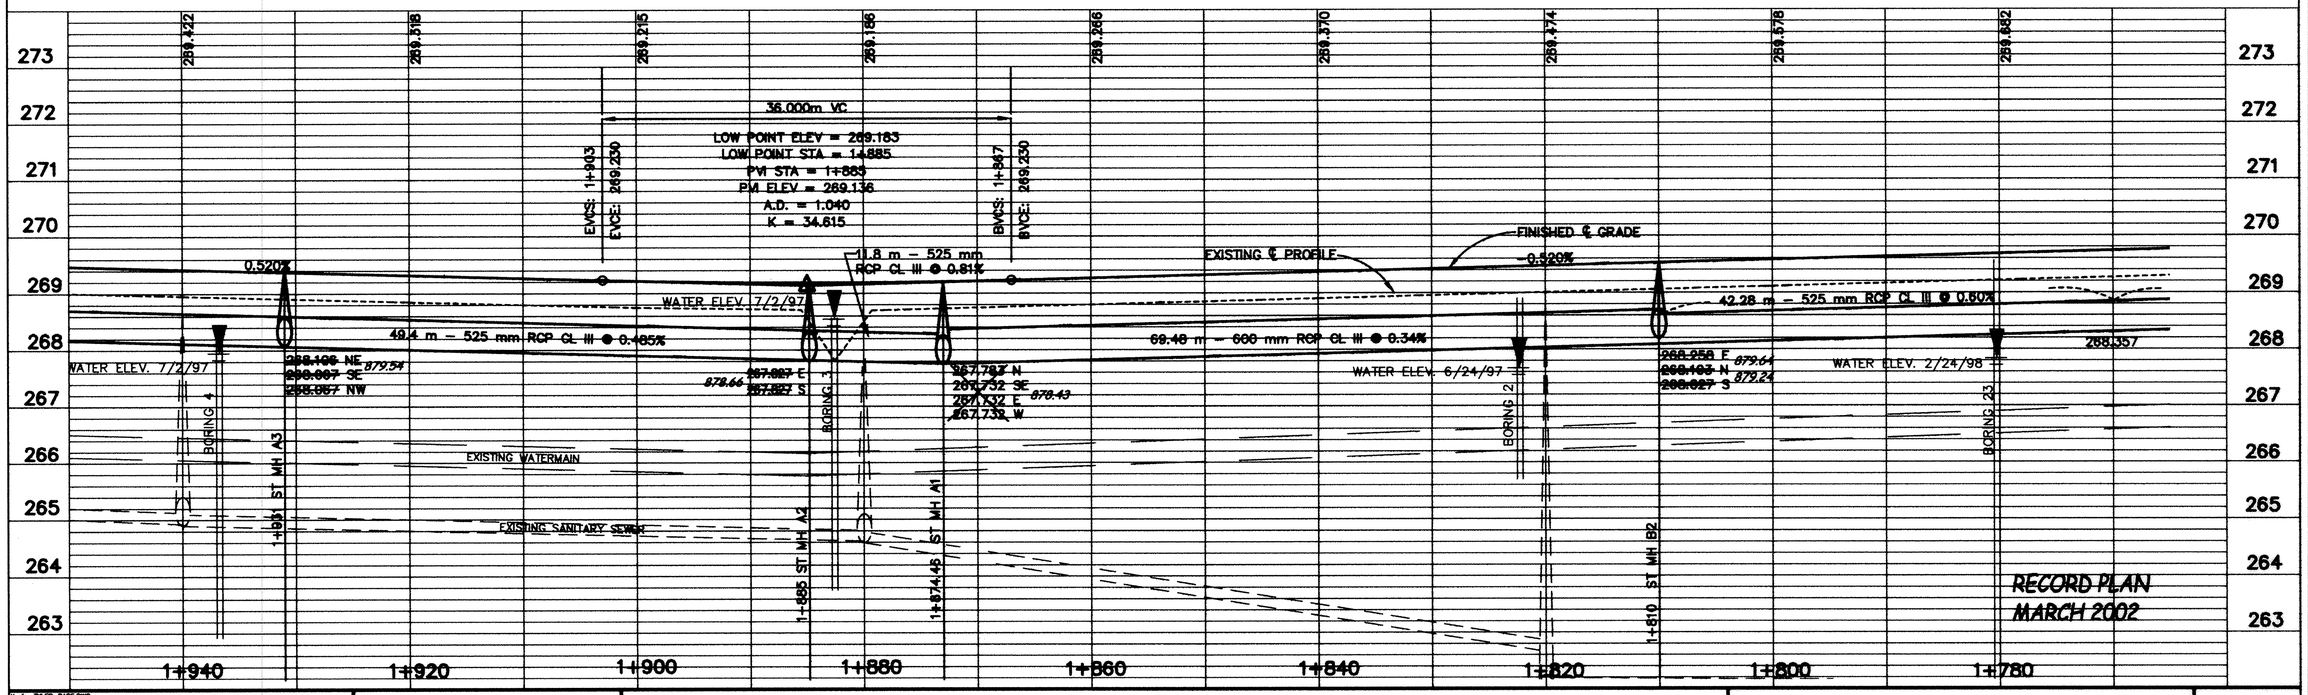

Xrefs: TYLER_BASE.DWG

DESIGNED BY: --- DRAWN BY: WJ
APPROVED: --- JOB NUMBER 800110J
CAD DATE: July 20, 1999 10:57:46 a.m.
CAD FILE: 800110T\S SEGMENT\12.DWG

I HEREBY CERTIFY THAT THIS PLAN, SPECIFICATION, OR REPORT WAS PREPARED BY ME OR UNDER MY DIRECT SUPERVISION AND THAT I AM A DULY REGISTERED PROFESSIONAL ENGINEER UNDER THE LAWS OF THE STATE OF MINNESOTA.

DATE _____ REG.NO. _____

NO.	DATE	BY	REVISION DESCRIPTION

1326 ENERGY PARK DRIVE
ST. PAUL, MINNESOTA 55108
(612) 644-4388

Howard R. Green Company
CONSULTING ENGINEERS

CITY OF ELK RIVER
EASTERN AREA
TYLER STREET IMPROVEMENTS

PLAN + PROFILE S. OF C.S.A.H. 12
SP 71-613-08, SP 204-020-03, SP 204-133-01, SP 204-132-03
1+770 TO 1+931

SHEET NO.
C1-13

DRAWING NUMBER
SAFCO PRODUCTS • NEW HOPE, MINNESOTA
REORDER BY PART NUMBER 6582
DRAWING NUMBER
EASTE 01
30