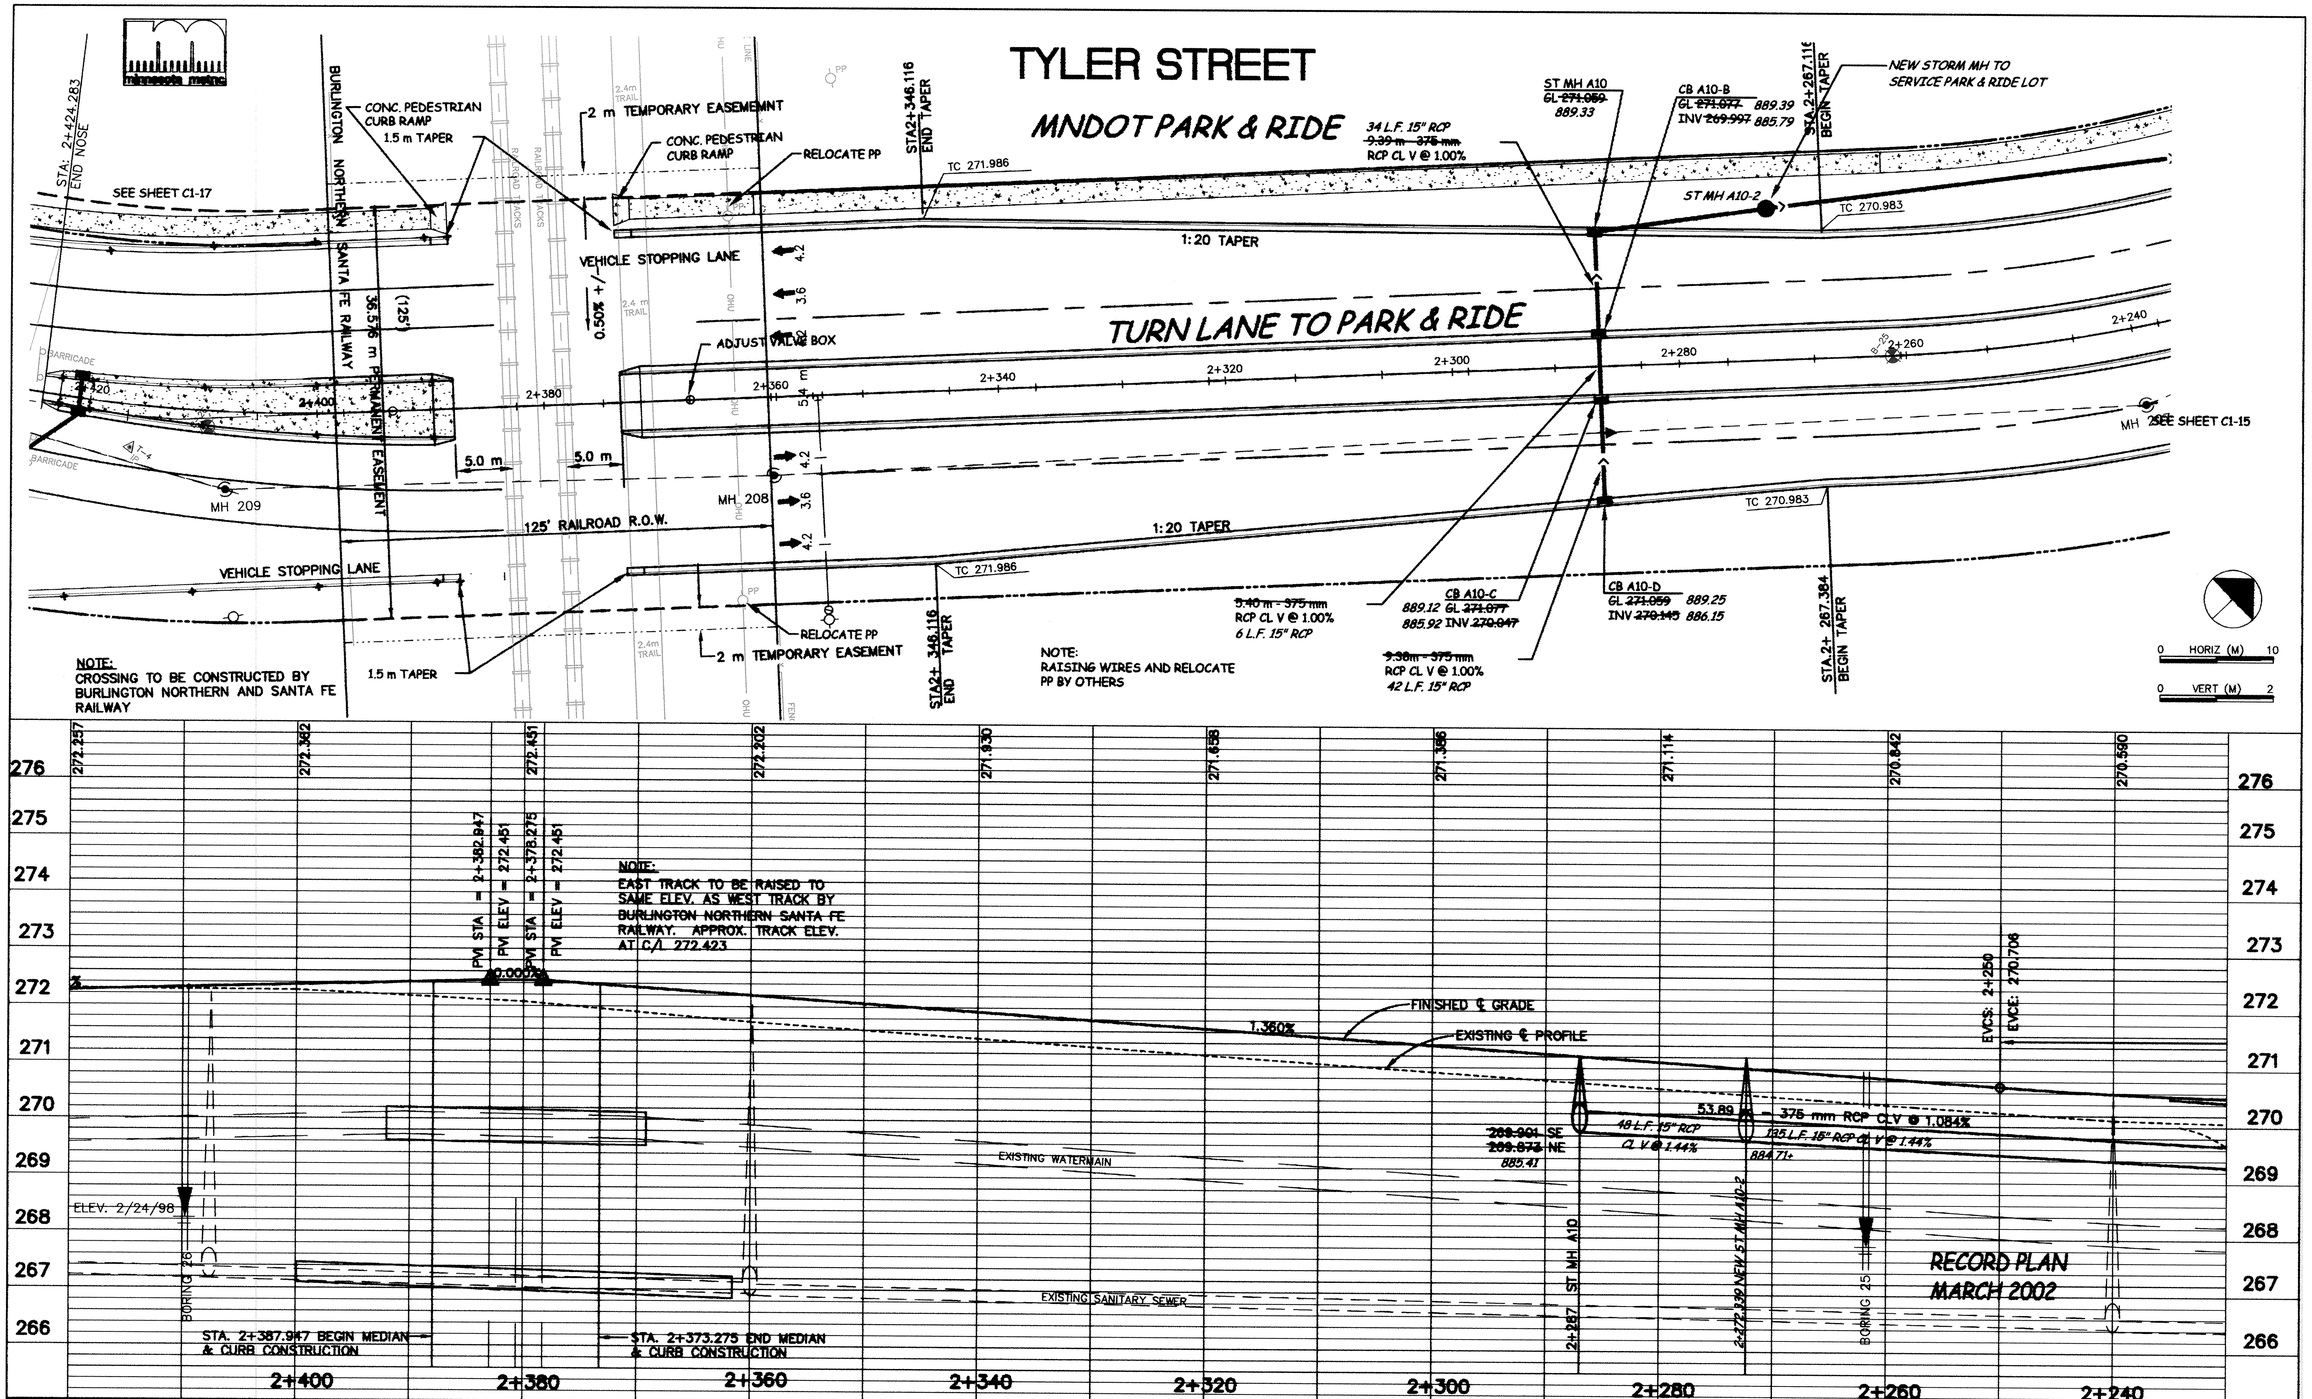

Xrefs: TYLER_BASE.DWG

DESIGNED BY: --- DRAWN BY: [signature]
APPROVED: --- JOB NUMBER 800110J
CAD DATE: April 17, 2002 3:09:04 p.m.
CAD FILE: 800110T\Asbuilts\S SEGMENT\15.DWG

I HEREBY CERTIFY THAT THIS PLAN, SPECIFICATION, OR REPORT WAS PREPARED BY ME OR UNDER MY DIRECT SUPERVISION AND THAT I AM A DULY REGISTERED PROFESSIONAL ENGINEER UNDER THE LAWS OF THE STATE OF MINNESOTA.

DATE _____ REG.NO. _____

NO.	DATE	BY	REVISION DESCRIPTION
1.	11-8-99	RM	PP RELOCATE NOTES

Howard R. Green Company
CONSULTING ENGINEERS
1326 ENERGY PARK DRIVE
ST. PAUL, MINNESOTA 55108
(612) 644-4389

CITY OF ELK RIVER
EASTERN AREA
TYLER STREET IMPROVEMENTS

PLAN + PROFILE S. OF C.S.A.H. 12
SP 71-613-08, SP 204-020-03, SP 204-133-01, SP 204-132-03
2+230 TO 2+420

SHEET NO.
C1-16

DRAWING NUMBER
DRAWING NUMBER
DRAWING NUMBER
DRAWING NUMBER
EASTE.01
33