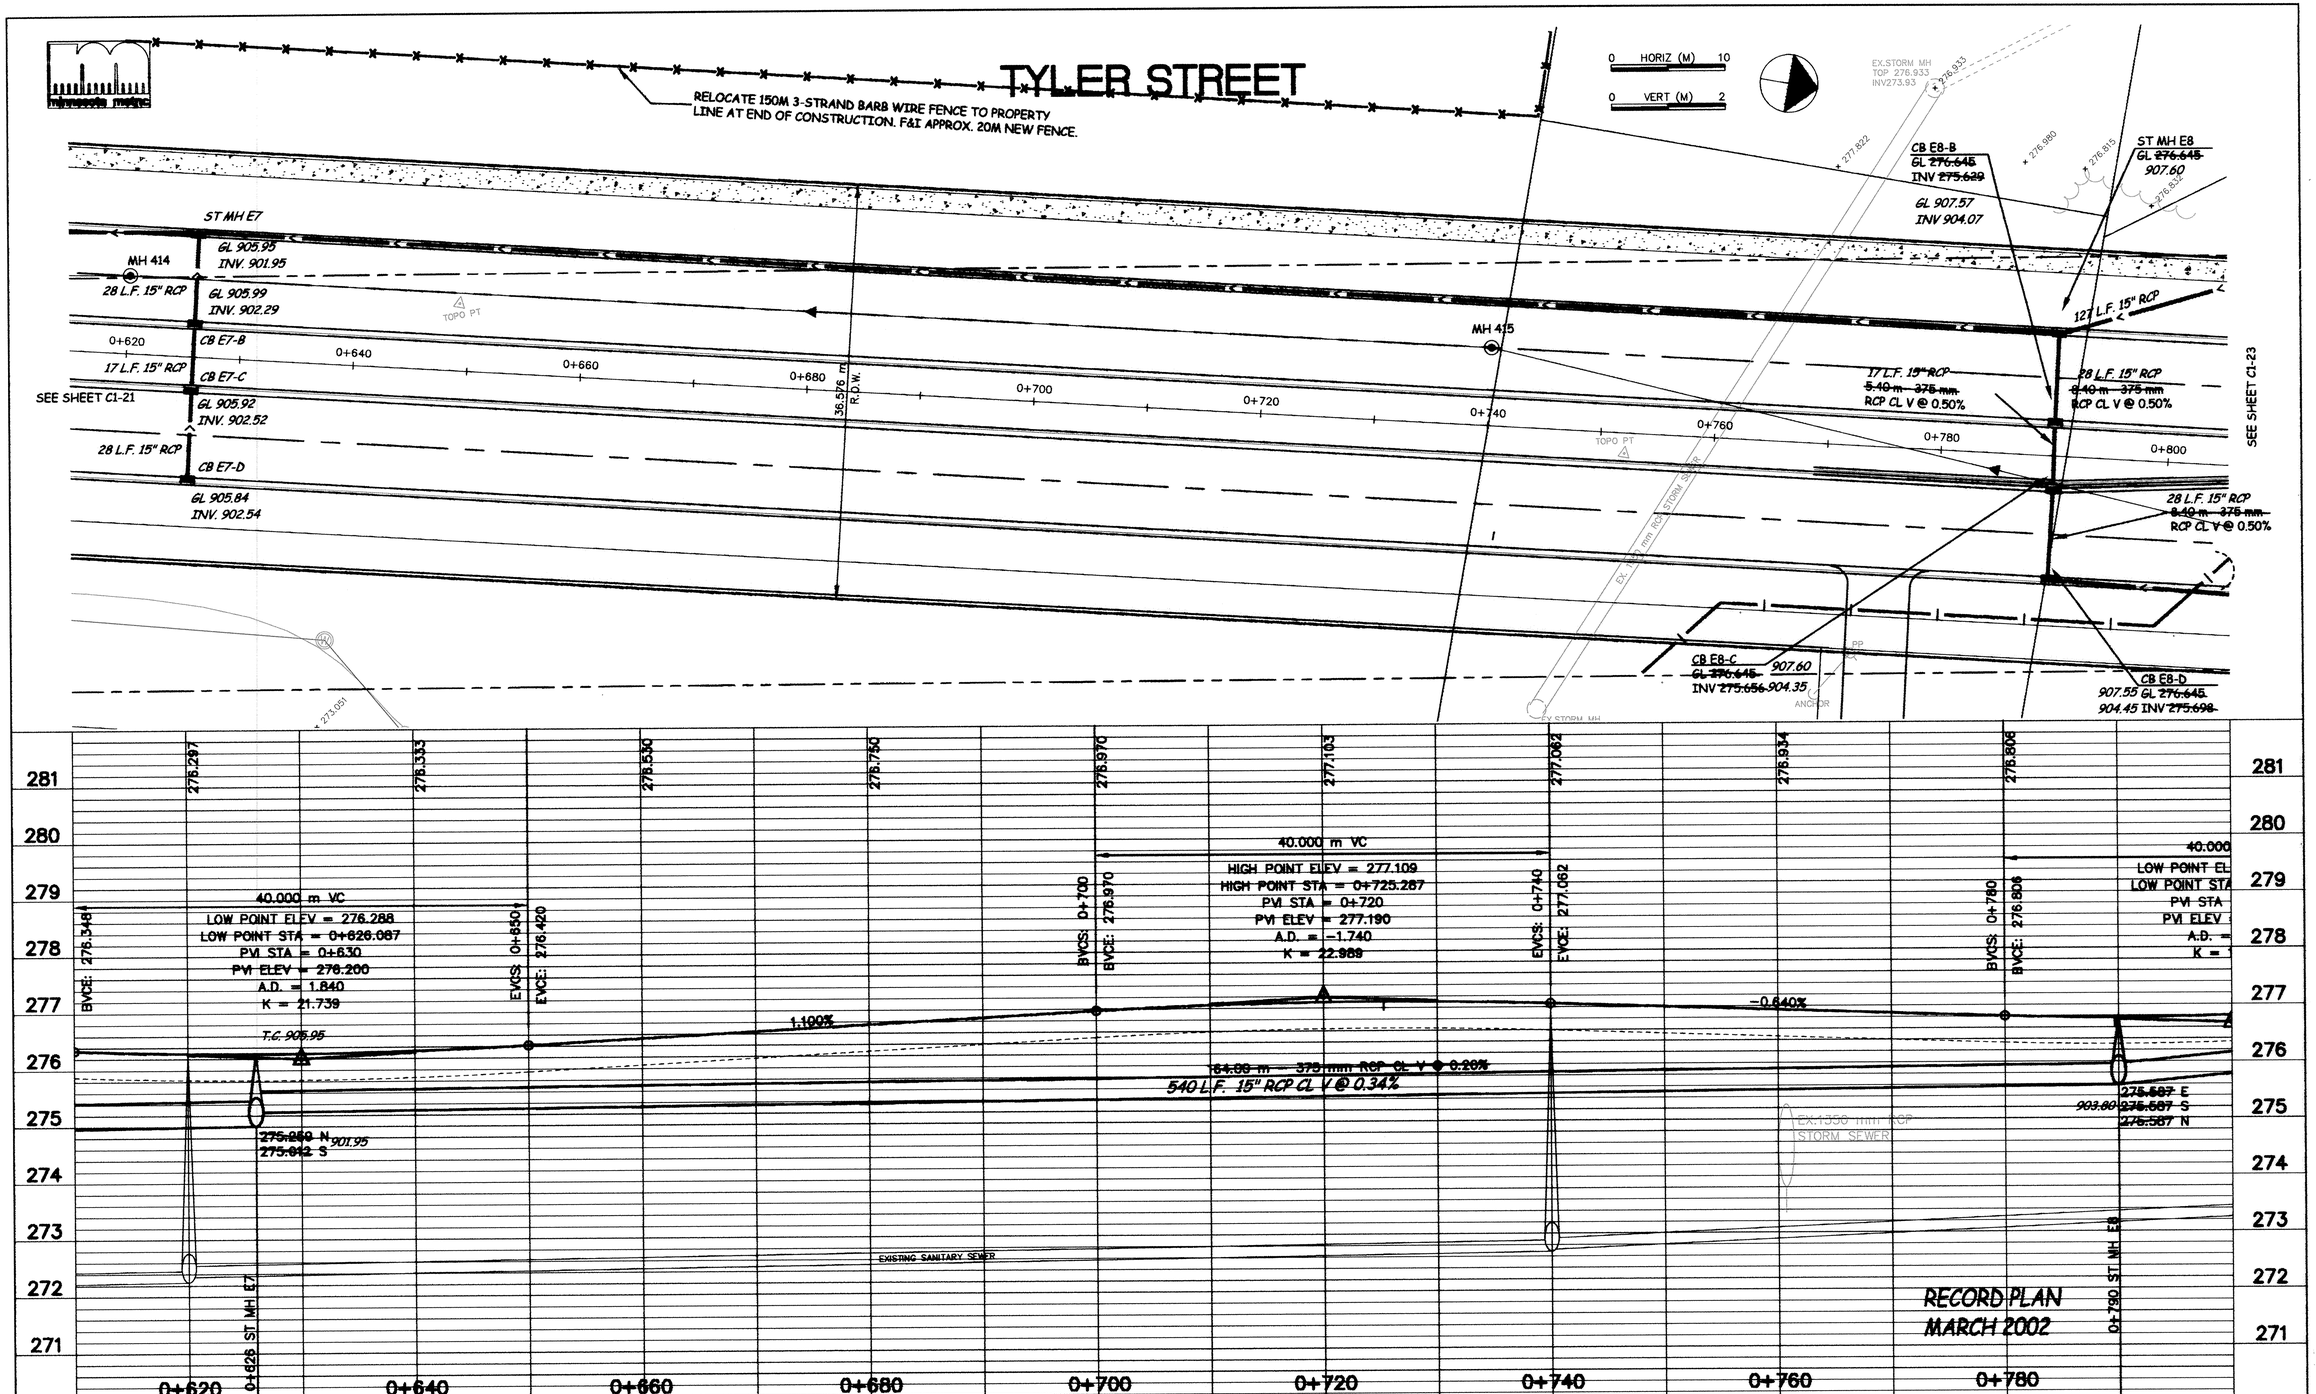

Xrefs: NORTH_TYLER_BASE.DWG

DESIGNED BY: ---- DRAWN BY: RW
APPROVED: --- JOB NUMBER 800110J
CAD DATE: April 17, 2002 3:52:36 p.m.
CAD FILE: 800110T\Asbuilts\N SEGMENT\05.DWG

I HEREBY CERTIFY THAT THIS PLAN, SPECIFICATION, OR REPORT WAS PREPARED BY ME OR UNDER MY DIRECT SUPERVISION AND THAT I AM A DULY REGISTERED PROFESSIONAL ENGINEER UNDER THE LAWS OF THE STATE OF MINNESOTA.

DATE 10/15/98 REG.NO. 15316

NO.	DATE	BY	REVISION DESCRIPTION
1.	11-8-99	RW	REVISE STORM SEWER

Howard R. Green Company
CONSULTING ENGINEERS
1326 ENERGY PARK DRIVE
ST. PAUL, MINNESOTA 55108
(612) 644-4369

CITY OF ELK RIVER
EASTERN AREA
TYLER STREET IMPROVEMENTS

PLAN + PROFILE N. OF C.S.A.H. 12
SP 71-613-08, SP 204-020-03, SP 204-133-01, SP 204-132-03
0+626 TO 0+790

SHEET NO.
C1-22

DRAWING NUMBER

SUFCO PRODUCTS • NEW HOPE, MINNESOTA
REORDER BY PART NUMBER 65532
POSITIONS EDGE OF PAVEMENT ON THIS LINE

DRAWING NUMBER

EASTE.01
39

DRAWING NUMBER