C.S.A.H. NO.13

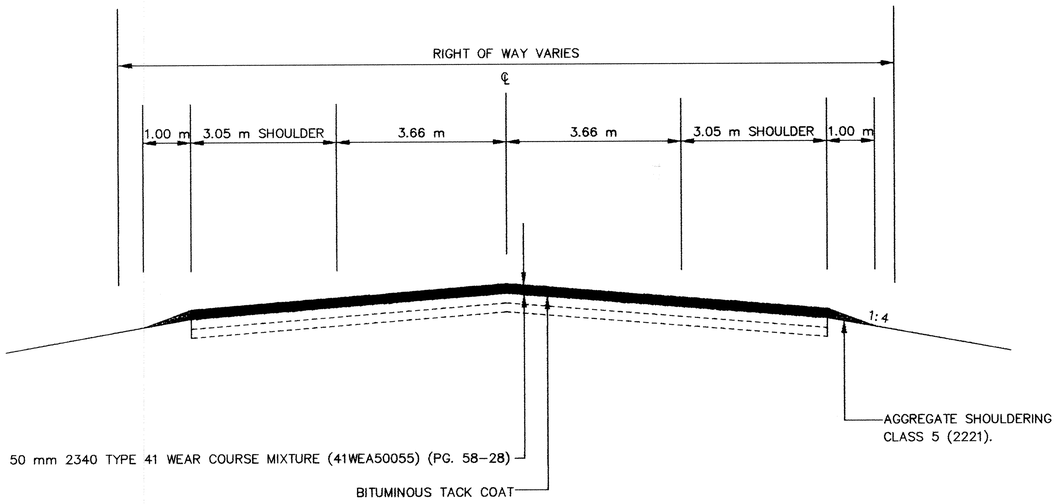

TYPICAL SECTION

STA. 1+020 - 1+920

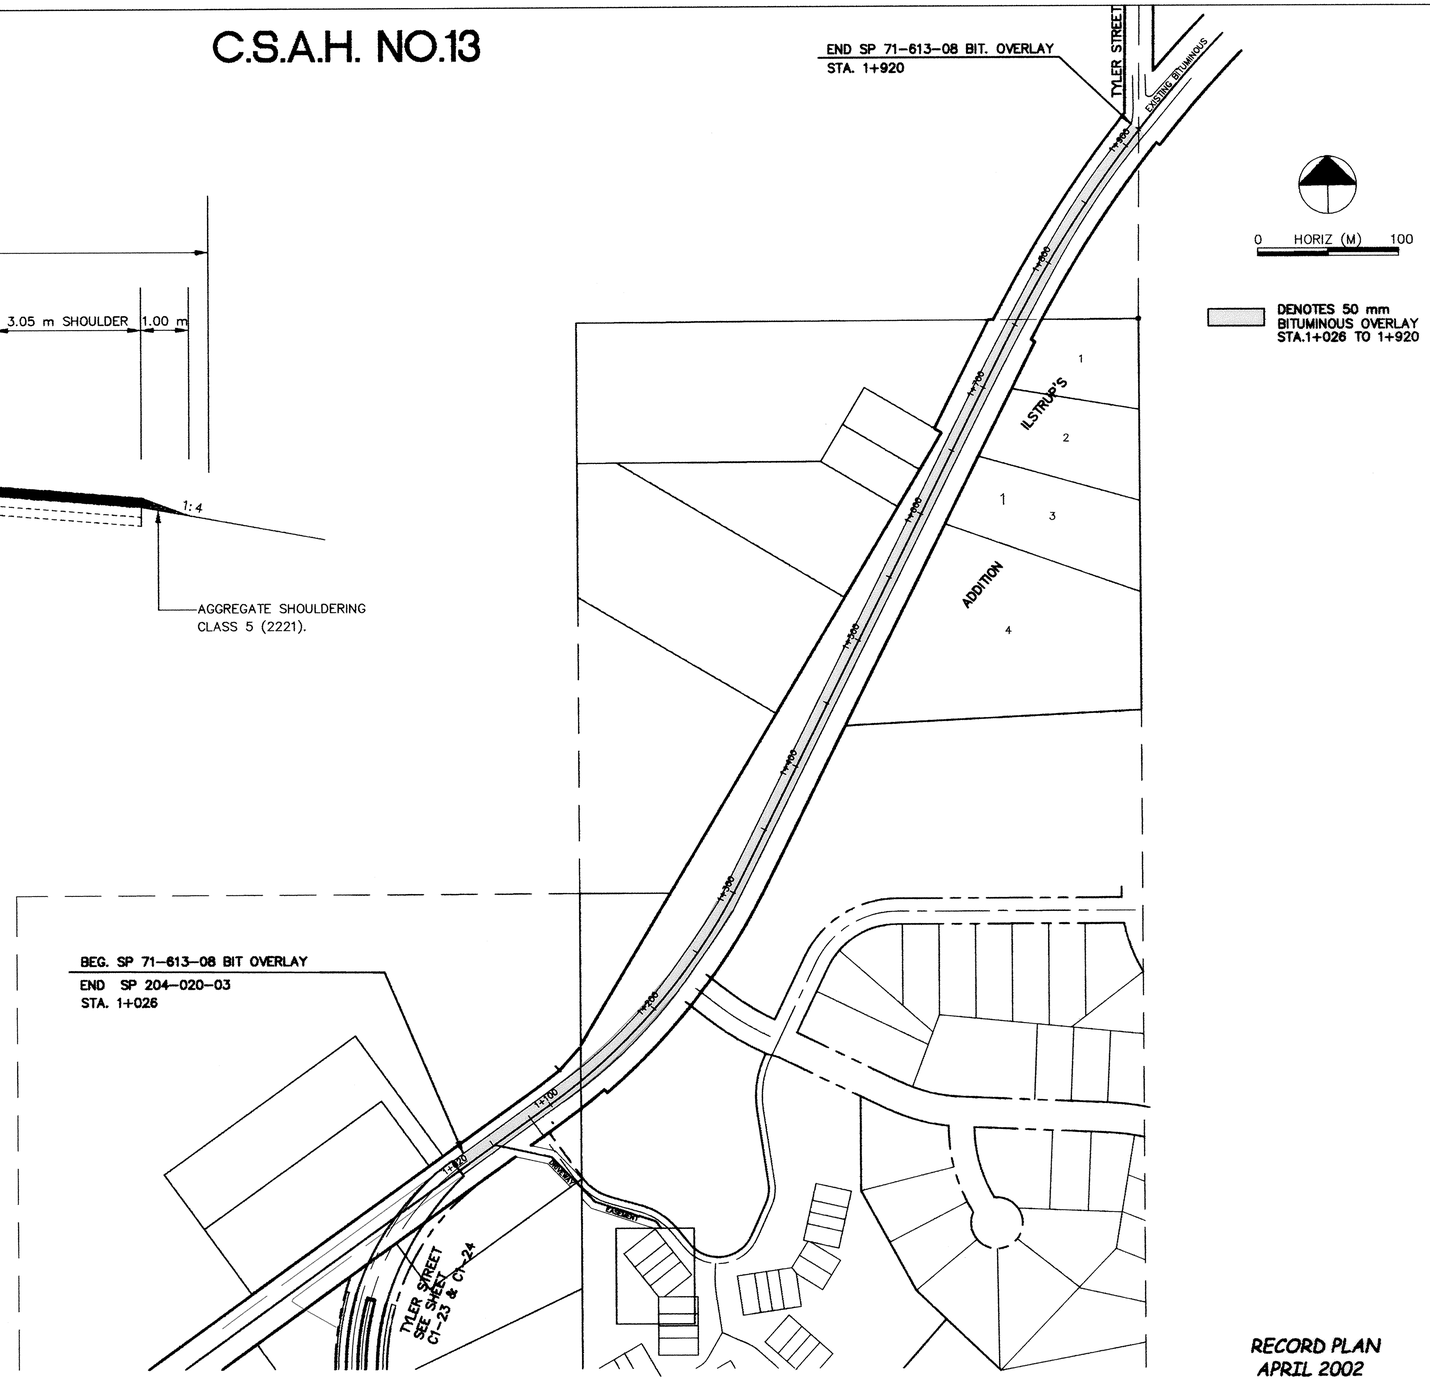

RECORD PLAN
APRIL 2002

DESIGNED BY: ---	DRAWN BY:
APPROVED: ---	JOB NUMBER 800110J
CAD DATE: April 18, 2002 9:17:10 a.m.	
CAD FILE: 800110T\Asbuilts\CSAH 13\OVERLAY.DWG	

I HEREBY CERTIFY THAT THIS PLAN, SPECIFICATION, OR REPORT WAS PREPARED BY ME OR UNDER MY DIRECT SUPERVISION AND THAT I AM A DULY REGISTERED PROFESSIONAL ENGINEER UNDER THE LAWS OF THE STATE OF MINNESOTA.

DATE _____ REG.NO. _____

NO.	DATE	BY	REVISION DESCRIPTION

Howard R. Green Company
CONSULTING ENGINEERS
1326 ENERGY PARK DRIVE
ST. PAUL, MINNESOTA 55108
(612) 644-4399

CITY OF ELK RIVER
EASTERN AREA
TYLER STREET IMPROVEMENTS

BITUMINOUS OVERLAY
C.S.A.H. NO. 13
SP 71-613-08, SP 204-020-03, SP 204-133-01, SP 204-132-03

SHEET NO.
C1-25

DRAWING NUMBER
EASTE.01
42

DRAWING NUMBER
SAFCO PRODUCTS • NEW HOPE, MINNESOTA
REORDER BY PART NUMBER 6262
DRAWING NUMBER
SAFCO PRODUCTS • NEW HOPE, MINNESOTA
REORDER BY PART NUMBER 6262
