STORM SEWER

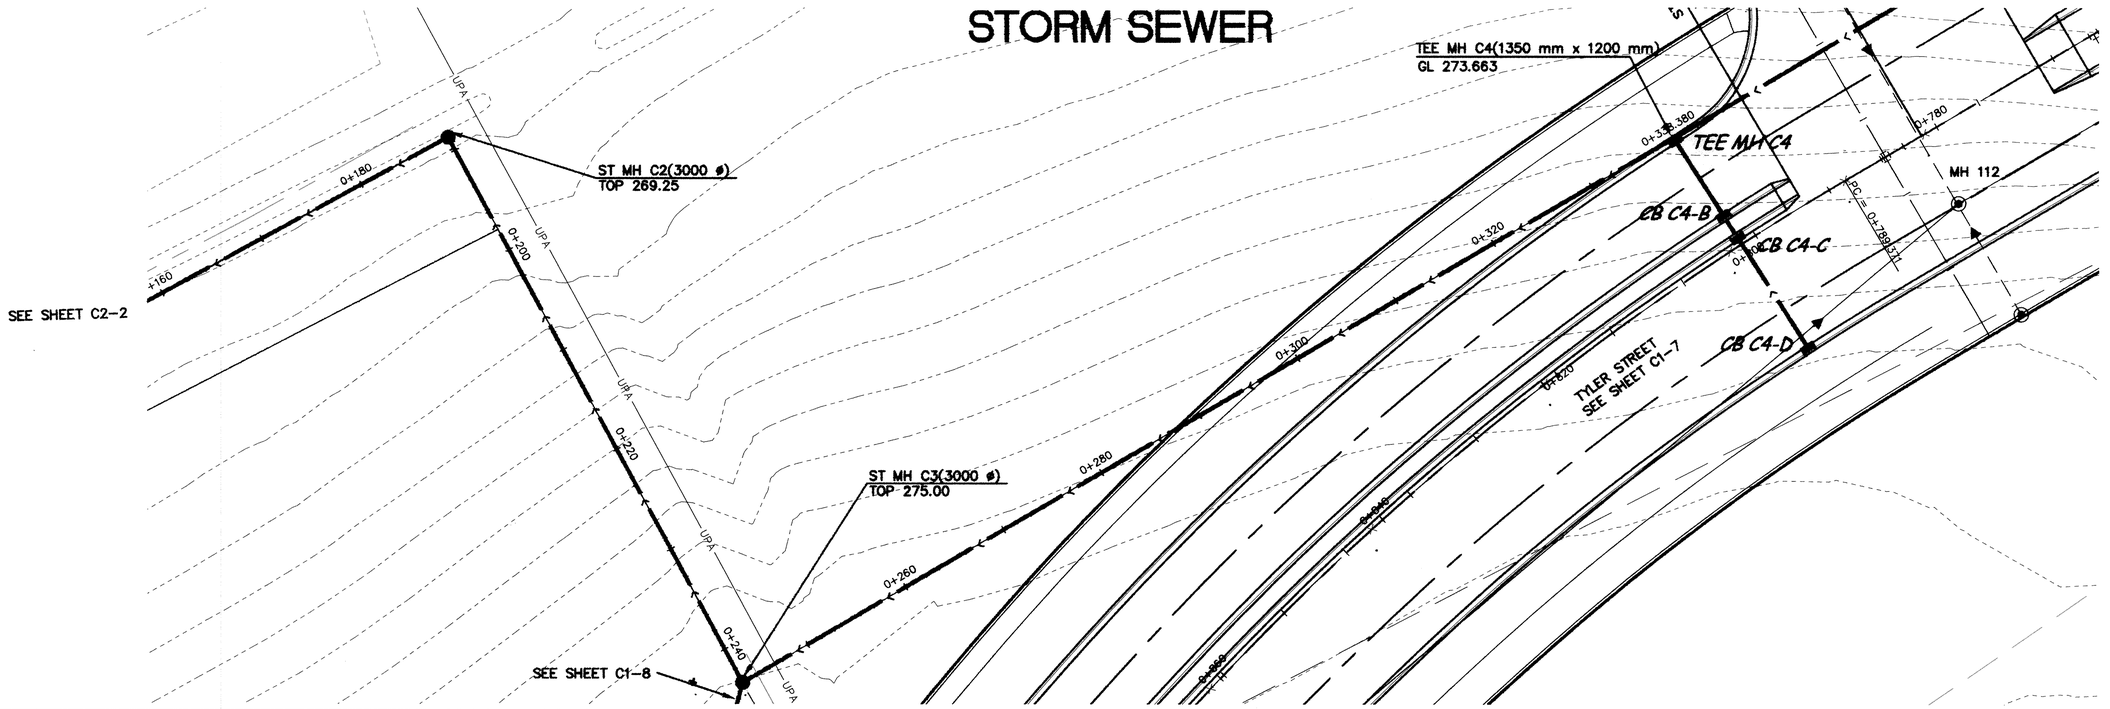

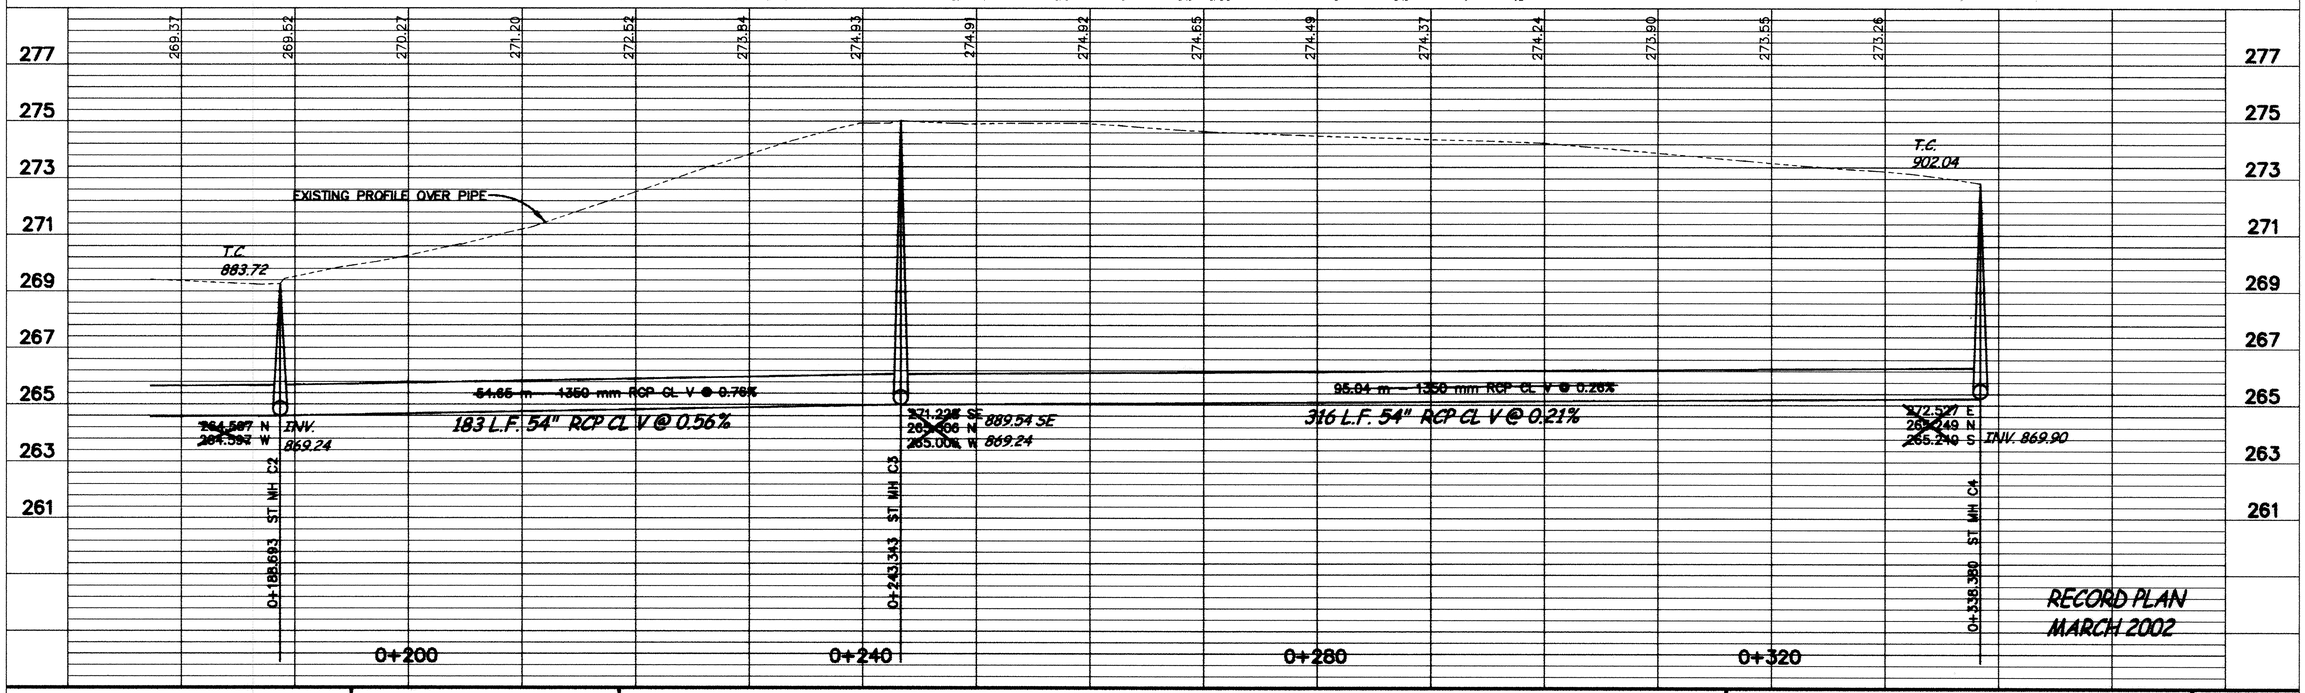

\\netfs: ERDBASIN.DWG			
DESIGNED BY: ---	DRAWN BY: EY		
APPROVED: ---	JOB NUMBER 800110J		
CAD DATE: April 16, 2002 9:27:44 a.m.			
CAD FILE: 800110T\Asbuilts\dwg\WETLAND EX.\ER110ST4.DWG			

I HEREBY CERTIFY THAT THIS PLAN, SPECIFICATION, OR REPORT WAS PREPARED BY ME OR UNDER MY DIRECT SUPERVISION AND THAT I AM A DULY REGISTERED PROFESSIONAL ENGINEER UNDER THE LAWS OF THE STATE OF MINNESOTA.

DATE _____ REG.NO. _____

NO.	DATE	BY	REVISION DESCRIPTION
1.	11-8-99	RM	REVISE STORM SEWER

Howard R Green Company
CONSULTING ENGINEERS
1326 ENERGY PARK DRIVE
ST. PAUL, MINNESOTA 55108
(651) 644-4389

CITY OF ELK RIVER
EASTERN AREA
TYLER STREET IMPROVEMENTS

STORM SEWER DETENTION BASIN
SP 71-613-08, SP 204-020-03, SP 204-133-01, SP 204-132-03
0+190 TO 0+338.380

SHEET NO.
C2-1

DRAWING NUMBER
EASTE.01
43

SAFCO PRODUCTS • NEW HOPE, MINNESOTA
REORDER BY PART NUMBER 65502
PRINTED SIDE UP PRINT ON THIS LINE