STORM SEWER

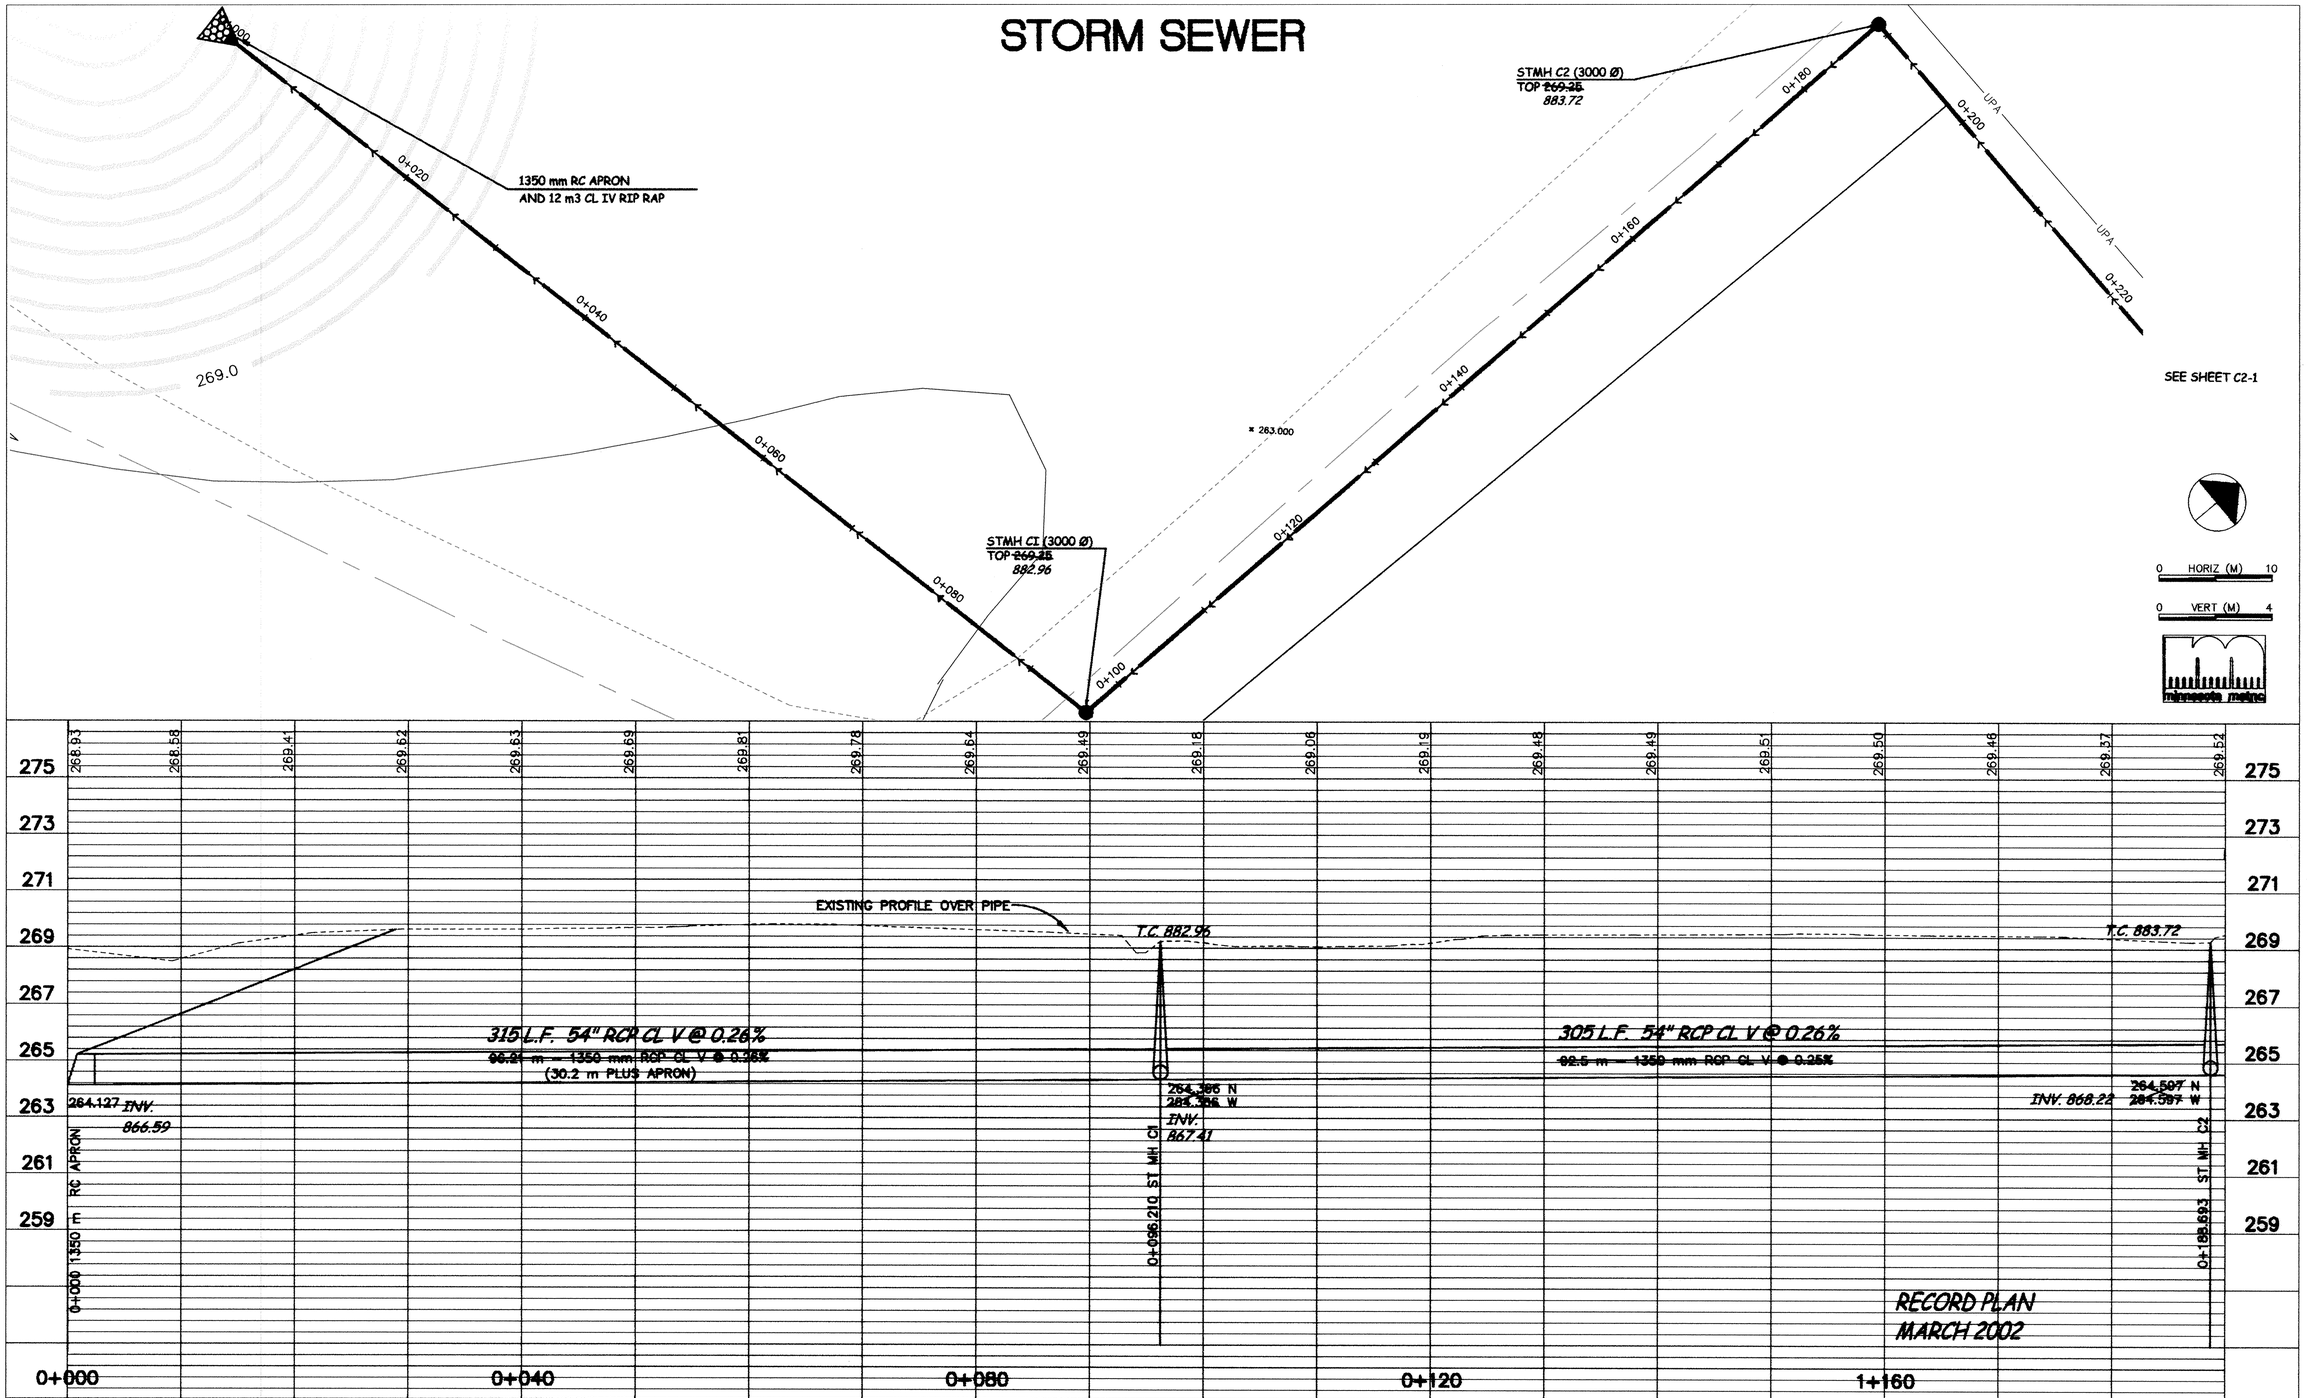

DESIGNED BY: ---	DRAWN BY: EY
APPROVED: ---	JOB NUMBER 800110J
CAD DATE: April 16, 2002 10:40:14 a.m.	
CAD FILE: 800110T\Asbuilts\dwg\WETLAND EX.\ER110ST3.DWG	

I HEREBY CERTIFY THAT THIS PLAN, SPECIFICATION, OR REPORT WAS PREPARED BY ME OR UNDER MY DIRECT SUPERVISION AND THAT I AM A DULY REGISTERED PROFESSIONAL ENGINEER UNDER THE LAWS OF THE STATE OF MINNESOTA.

DATE _____ REG.NO. _____

NO.	DATE	BY	REVISION DESCRIPTION
1.	11-8-99	RM	REVISE STORM SEWER

1326 ENERGY PARK DRIVE
ST. PAUL, MINNESOTA 55108
(612) 644-4389
Howard R. Green Company
CONSULTING ENGINEERS

CITY OF ELK RIVER
EASTERN AREA
PHASE I IMPROVEMENTS

STORM SEWER IMPROVEMENTS - DETENSION BASIN
SP 71-613-08, SP 204-020-03, SP 204-133-01, SP 204-132-03
0+000 TO 0+190

SHEET NO.
C2-2

DRAWING NUMBER
SAFCO PRODUCTS • NEW HOPE, MINNESOTA
REORDER BY PART NUMBER 65562
POSITION EDGE OF PRINT ON THIS LINE
DRAWING NUMBER
SAFCO PRODUCTS • NEW HOPE, MINNESOTA
REORDER BY PART NUMBER 65562
POSITION EDGE OF PRINT ON THIS LINE
DRAWING NUMBER
SAFCO PRODUCTS • NEW HOPE, MINNESOTA
REORDER BY PART NUMBER 65562
POSITION EDGE OF PRINT ON THIS LINE
DRAWING NUMBER
SAFCO PRODUCTS • NEW HOPE, MINNESOTA
REORDER BY PART NUMBER 65562
POSITION EDGE OF PRINT ON THIS LINE

EASTE.01
44