# STORM SEWER

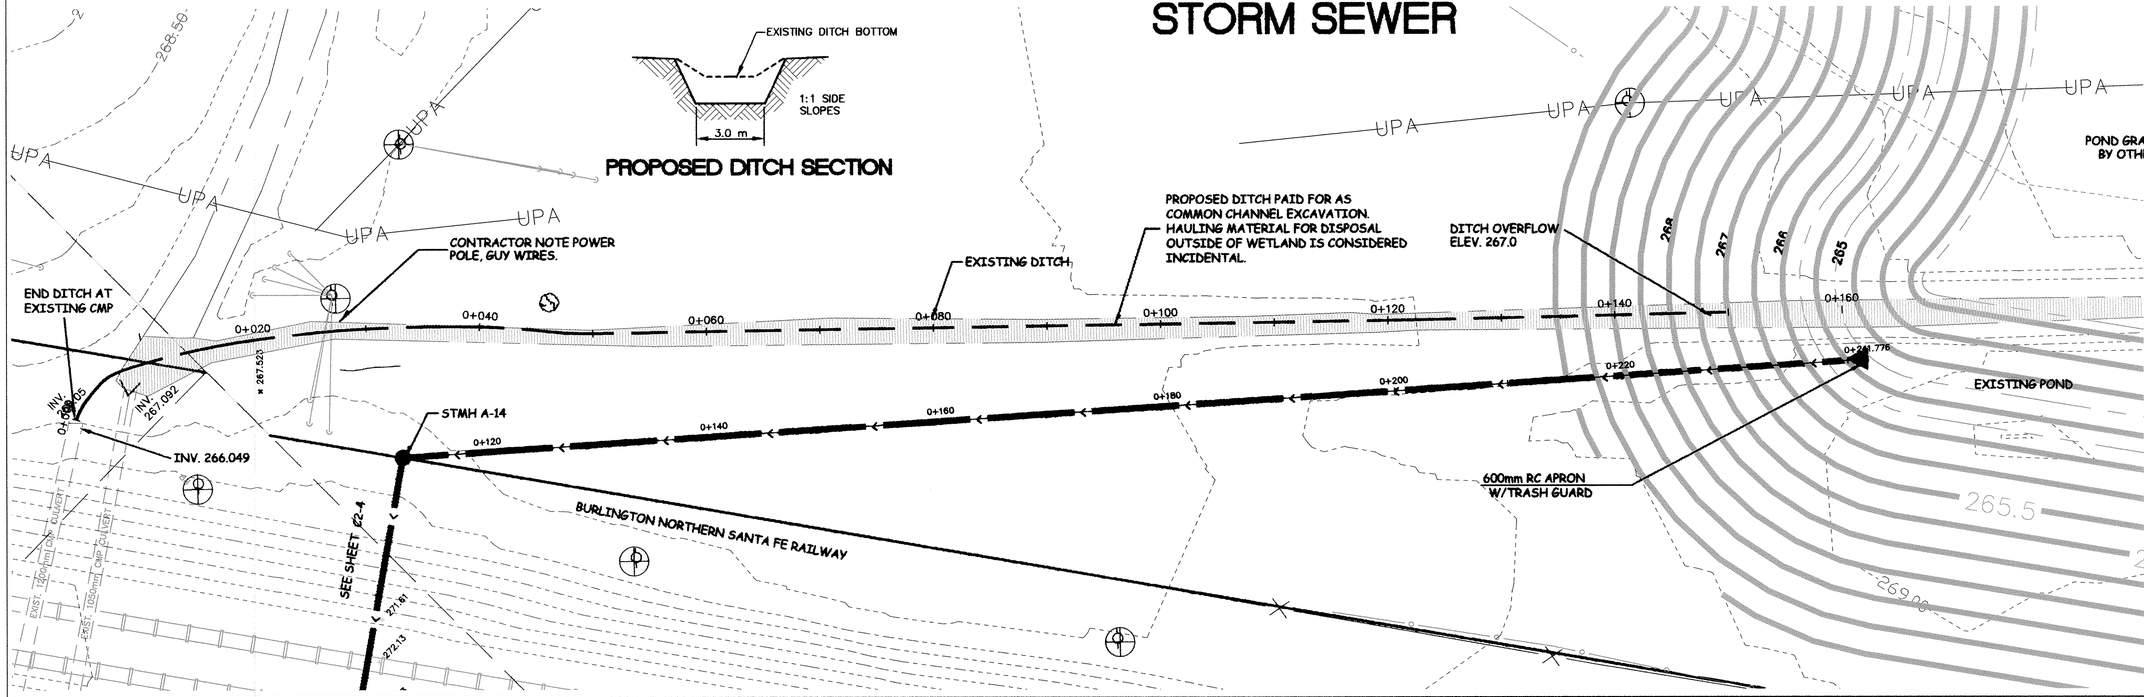


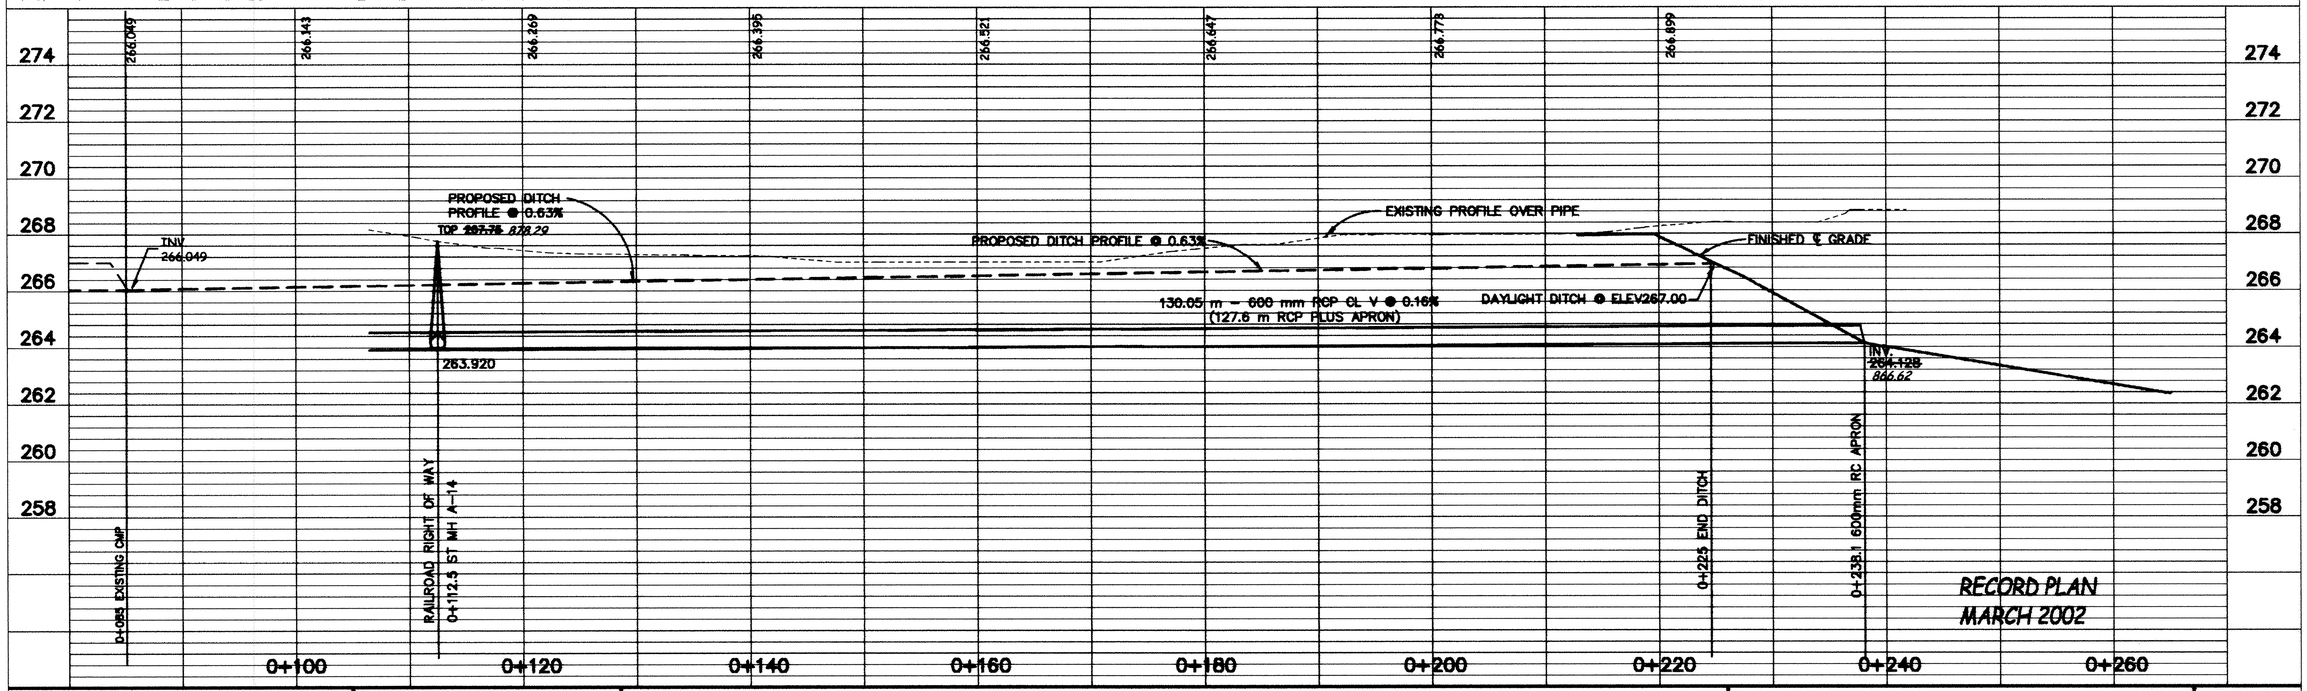


Xrefs: ER08ASR.DWG

DESIGNED BY: --- DRAWN BY: EY

APPROVED: --- JOB NUMBER 800110J

CAD DATE: July 22, 1999 2:27:17 p.m.

CAD FILE: 800110J\Dwgs\WETLAND EXHIBITS\ER110ST2.DWG

I HEREBY CERTIFY THAT THIS PLAN, SPECIFICATION, OR REPORT WAS PREPARED BY ME OR UNDER MY DIRECT SUPERVISION AND THAT I AM A DULY REGISTERED PROFESSIONAL ENGINEER UNDER THE LAWS OF THE STATE OF MINNESOTA.

DATE _____ REG.NO. _____

| NO. | DATE | BY | REVISION DESCRIPTION |
|---|---|---|---|
| | | | |


Howard R Green Company
CONSULTING ENGINEERS
1326 ENERGY PARK DRIVE
ST. PAUL, MINNESOTA 55108
(612) 644-4389


CITY OF ELK RIVER
EASTERN AREA
TYLER STREET IMPROVEMENTS

STORM SEWER IMPROVEMENTS
DETENTION POND
SP 71-613-08, SP 204-020-03, SP 204-133-01, SP204-132-03
0+160 TO 0+245.43

SHEET NO.
C2-3


SAFCO PRODUCTS • NEW HOPE, MINNESOTA
REORDER BY PART NUMBER 65502
DRAWING NUMBER
EASTE.01
45