# STORM SEWER

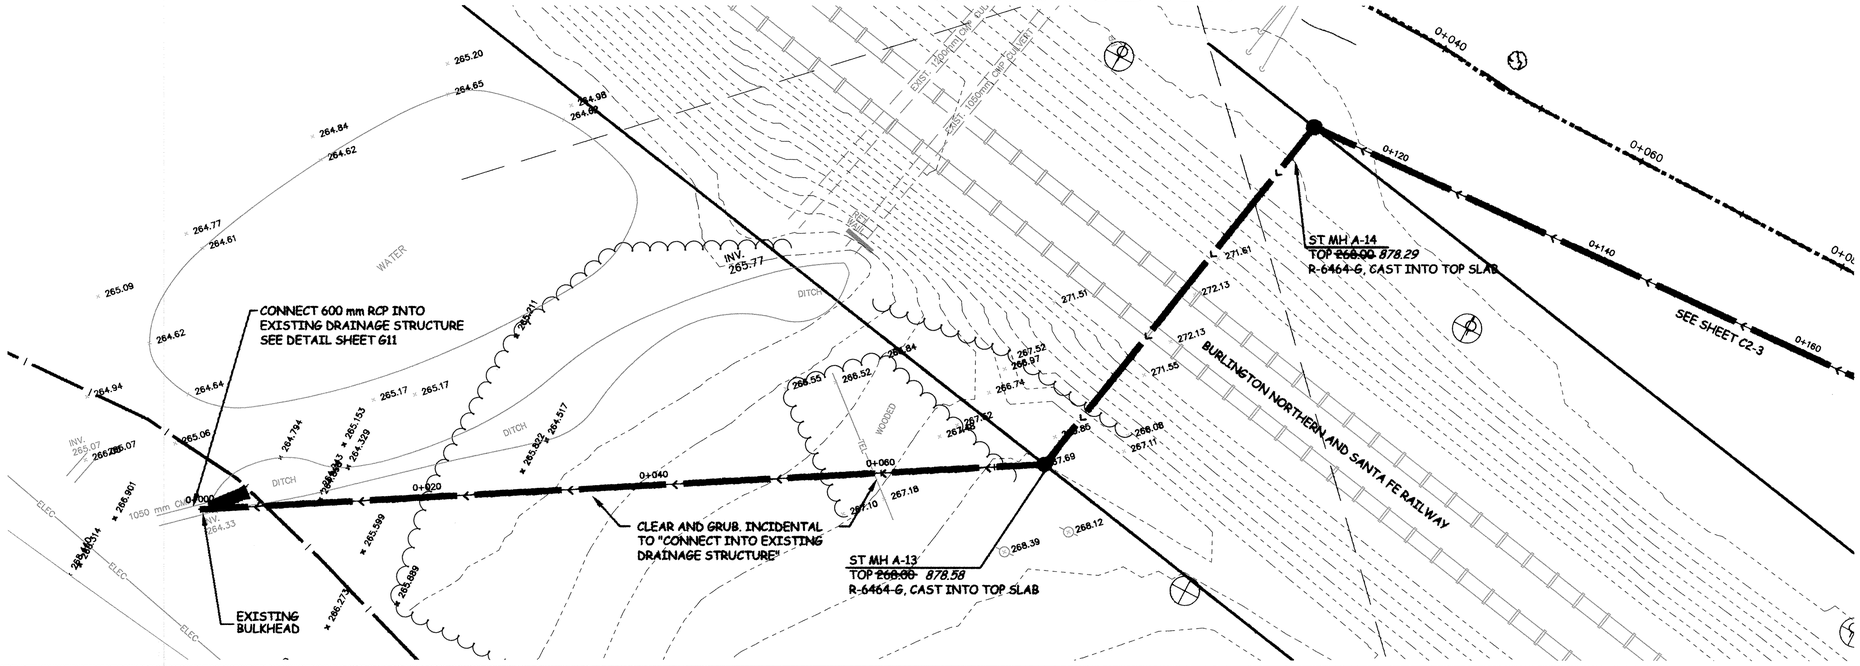


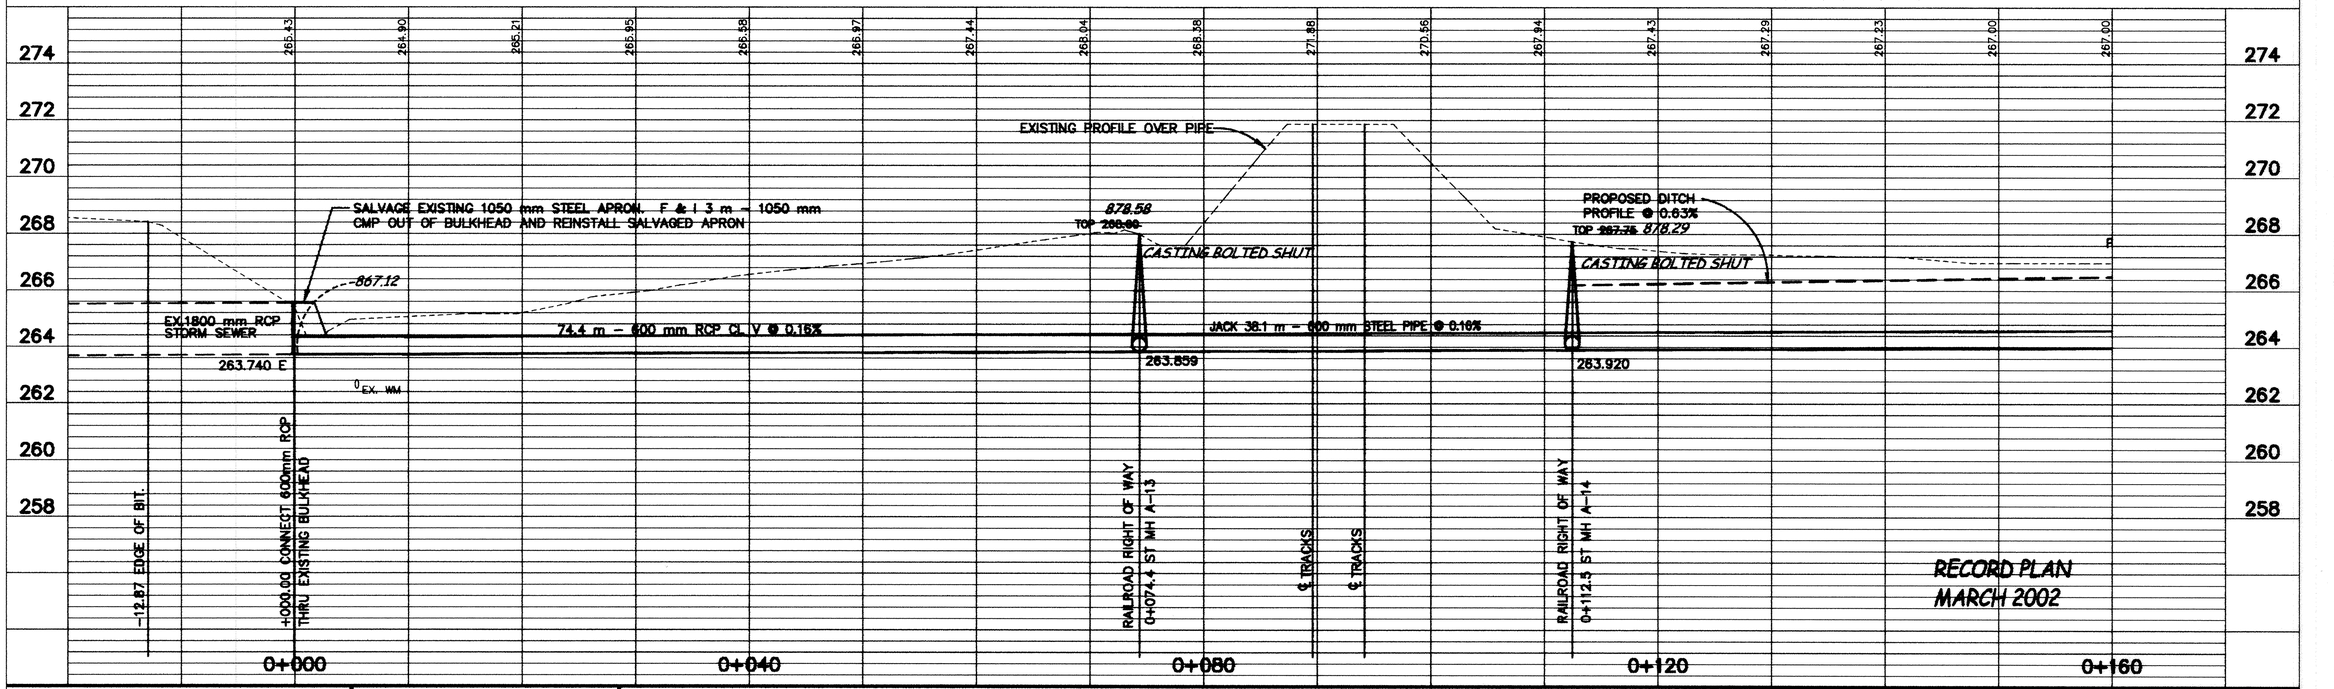


Xrefs: ERDBASIN.DWG

DESIGNED BY: ---  DRAWN BY: EY

APPROVED: ---  JOB NUMBER 800110J

CAD DATE: April 16, 2002 10:55:32 a.m.

CAD FILE: 800110T\Asbuilts\dwg\WETLAND EX.\ER110ST1.DWG

I HEREBY CERTIFY THAT THIS PLAN, SPECIFICATION, OR REPORT WAS PREPARED BY ME OR UNDER MY DIRECT SUPERVISION AND THAT I AM A DULY REGISTERED PROFESSIONAL ENGINEER UNDER THE LAWS OF THE STATE OF MINNESOTA.

DATE _____ REG.NO. _____

| NO. | DATE | BY | REVISION DESCRIPTION |
|---|---|---|---|
| 1. | 11-8-99 | RM | REVISE CLEAR & GRUB NOTE |


1326 ENERGY PARK DRIVE
ST. PAUL, MINNESOTA 55108
(612) 644-4389

Howard R. Green Company
CONSULTING ENGINEERS


CITY OF ELK RIVER
EASTERN AREA
TYLER STREET IMPROVEMENTS

STORM SEWER IMPROVEMENTS - DETENTION POND
SP 71-613-08, SP 204-020-03, SP 204-133-01, SP 204-132-03
0+000 TO 0+160

SHEET NO.
C2-4

0 HORIZ (M) 10

0 VERT (M) 4


DRAWING NUMBER
SAFCO PRODUCTS • NEW HOPE, MINNESOTA
RECOMMENDED POSITION EDGE OF PRINT ON THIS LINE
EASTE.01
46