1+020

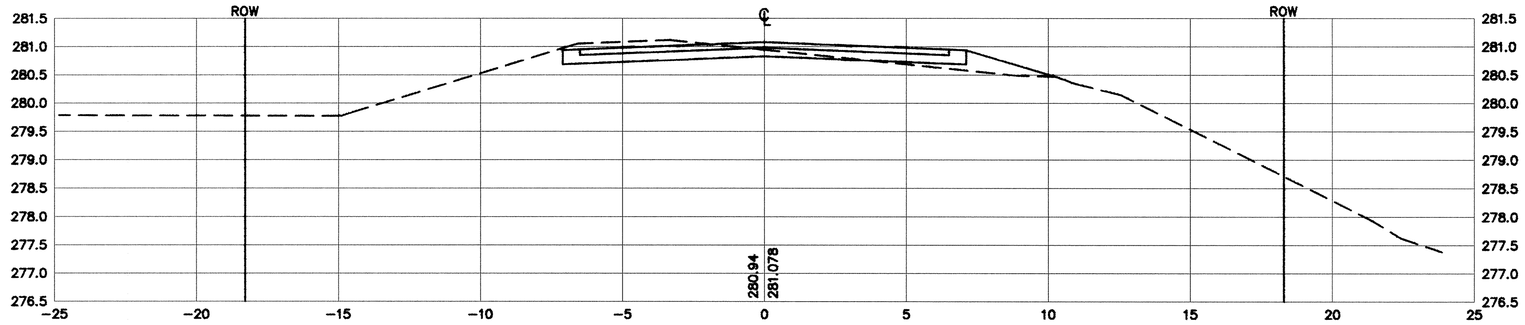

1+000

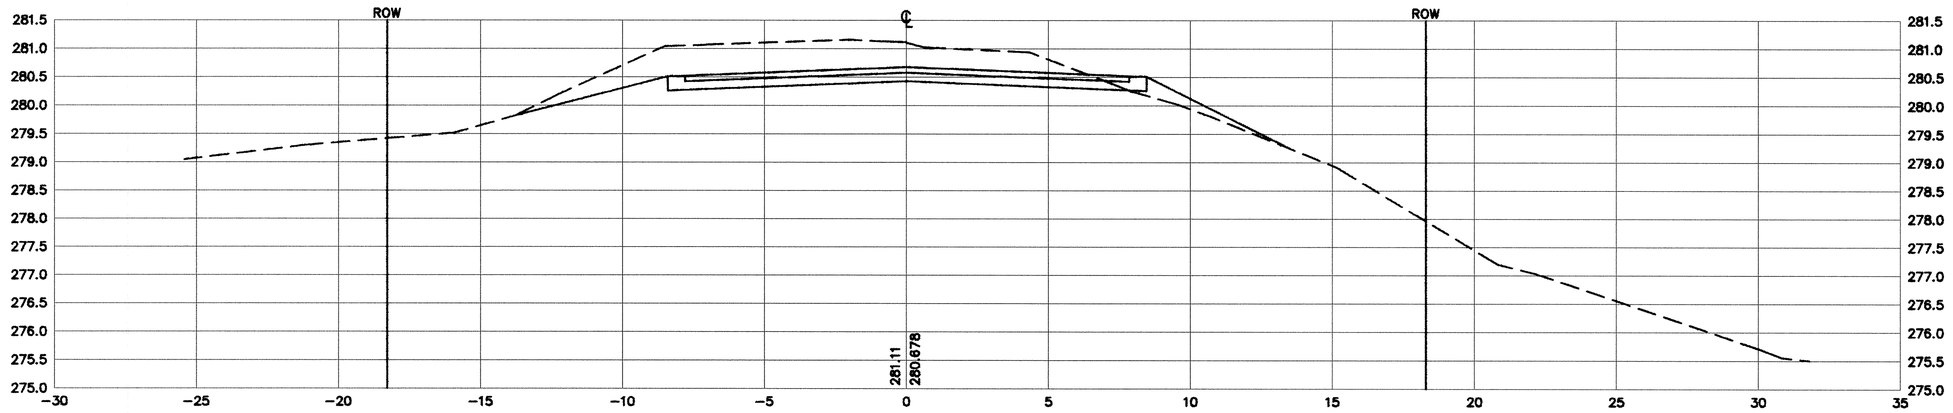

0+980

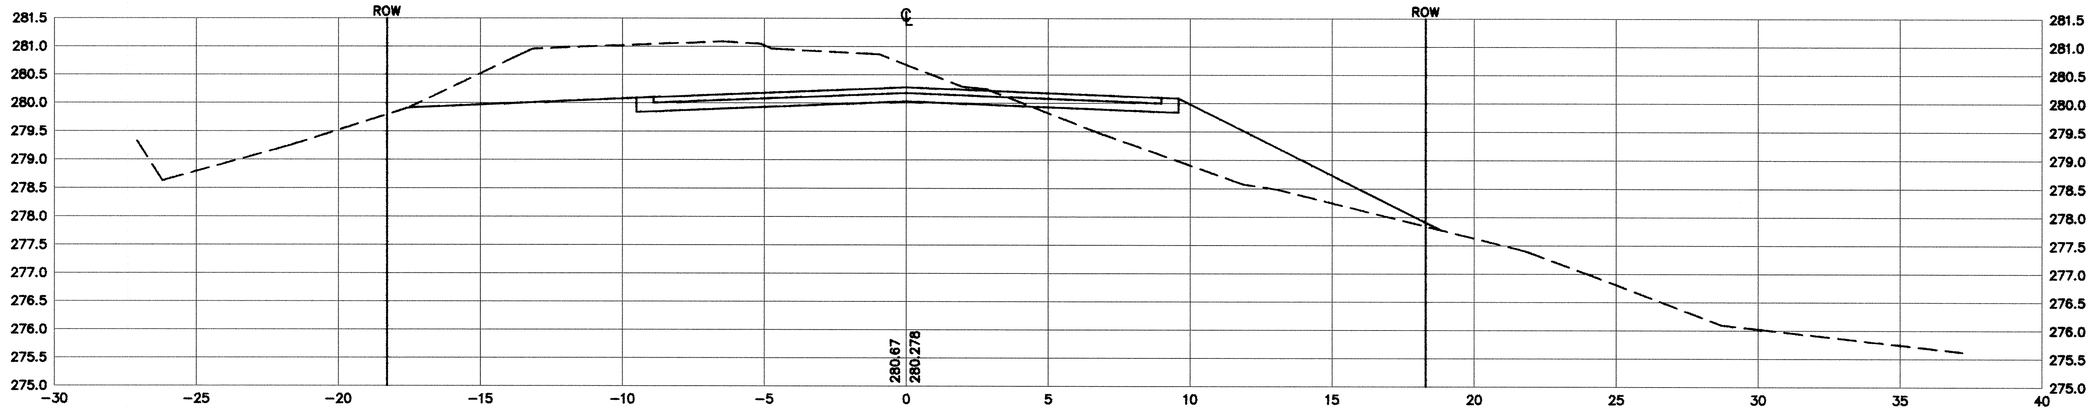

minnesota metric

0 HORIZ (M) 5

0 VERT (M) 2

Xrefs: XSEC_BASE.DWG

DESIGNED BY: AB DRAWN BY: MJJ
APPROVED: --- JOB NUMBER 800110J
CAD DATE: January 06, 2003 8:55:28 a.m.
CAD FILE: 800110T\Asbuilts\N SEGMENT\X17.DWG (JLALLEN)

I HEREBY CERTIFY THAT THIS PLAN, SPECIFICATION, OR REPORT WAS PREPARED BY ME OR UNDER MY DIRECT SUPERVISION AND THAT I AM A DULY REGISTERED PROFESSIONAL ENGINEER UNDER THE LAWS OF THE STATE OF MINNESOTA.

DATE _____ REG.NO. 15316

NO.	DATE	BY	REVISION DESCRIPTION

Howard R. Green Company
CONSULTING ENGINEERS
1326 ENERGY PARK DRIVE
ST. PAUL, MINNESOTA 55108
(651) 644-4389

CITY OF ELK RIVER
EASTERN AREA
TYLER STREET IMPROVEMENTS

STREET AND STORM SEWER IMPROVEMENTS
CROSS SECTIONS - NORTH TYLER STREET
SP 71-613-08, SP 204-020-03, SP 204-133-01, SP 204-132-03
0+980 TO 1+020

SHEET NO.
C1-49X

DRAWING NUMBER
EASTE.01
93

SAFCO PRODUCTS • NEW HOPE, MINNESOTA
REORDER BY PART NUMBER 65502