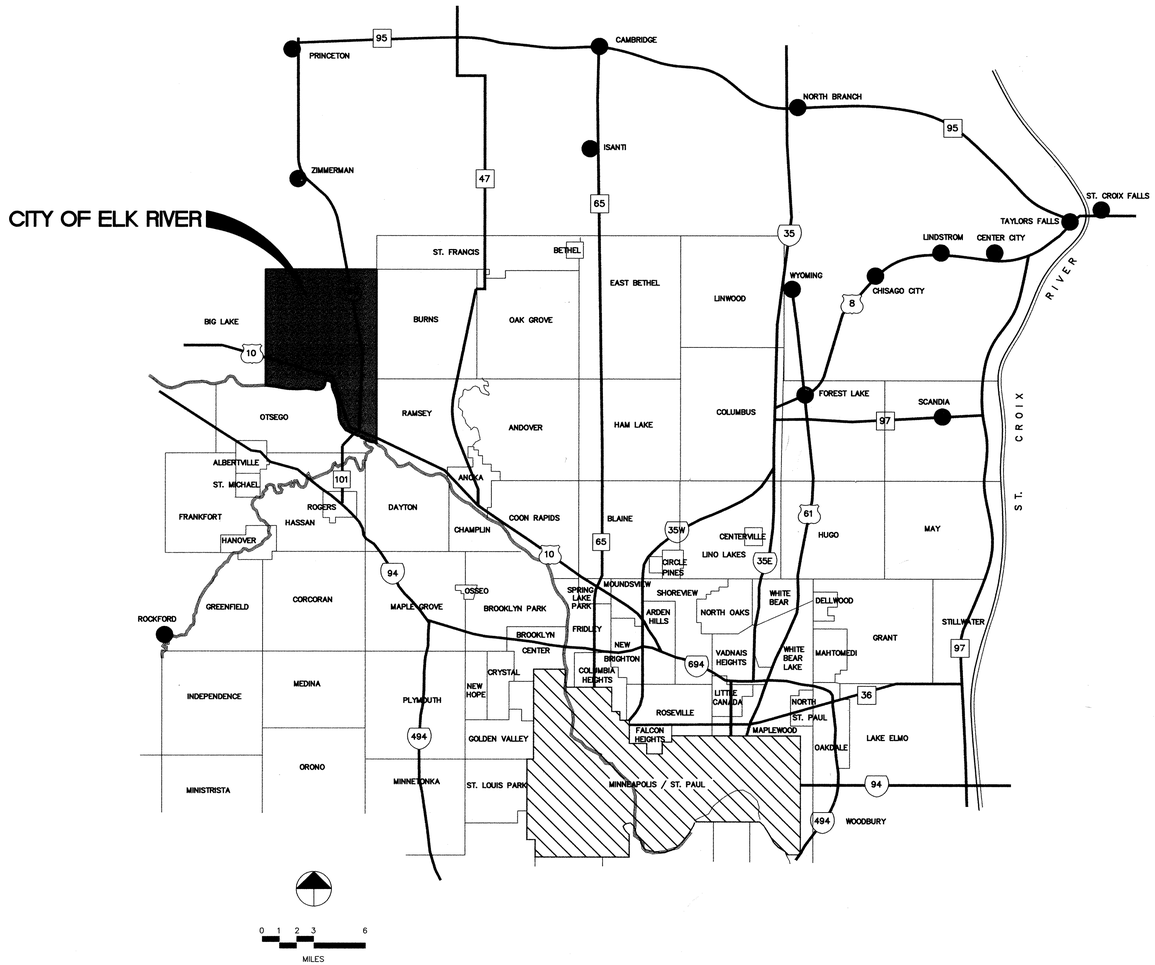

ELK HILLS DRIVE / DODGE STREET IMPROVEMENTS

TRAFFIC SIGNAL MODIFICATIONS AT ELK HILLS DR. AND T.H. 169

I HEREBY CERTIFY THAT THIS PLAN, SPECIFICATION, OR REPORT WAS PREPARED BY ME OR UNDER MY DIRECT SUPERVISION AND THAT I AM A DULY REGISTERED PROFESSIONAL ENGINEER UNDER THE LAWS OF THE STATE OF MINNESOTA.

Terry J. Maurer

DATE 7/31/95 REG.NO. 15316

APPROVED Jay P. Dirlam DATE 7/27/95

MnDOT DISTRICT 3 TRAFFIC ENGINEER

MSA CONSULTING ENGINEERS

1326 ENERGY PARK DRIVE
ST.PAUL, MINNESOTA 55108
(612) 644-4389

5075 WAYZATA BLVD. SUITE #225
MINNEAPOLIS, MINNESOTA 55416
(612) 546-0432

PREPARED FOR:

City of Elk River

JULY 1995

SHEET 1 OF 22

RECORD PLAN
JANUARY 1996
CITY MARCH 1996

ER246-T

Thu Jul 20 10:18:44 1995

ELKHI 95
1

DRAWING NUMBER