DODGE STREET

SEE SHEET 8
PROP. 2+65.45
TC 928.16
TC 929.00
TC 928.91
R=35'
6' WIDE CONC. WALK
CONSTRUCTION LIMITS
SILT FENCE
Δ = 17°33'19"
R = 300.00'
T = 46.32'
L = 91.92'
PC = 22+25.62
PT = 23+17.54
CONTRACTOR TO VERIFY LOCATION OF DRIVEWAY WITH ENGINEER PRIOR TO CONSTRUCTION
DRIVEWAY BY OTHERS
30'
2' TAPER
R=30'
6" VALVE
RELOCATE EX. HYDRANT AND VALVE INSTALL 13'-6"DIP FROM EX. TEE
CLEAR AND GRUB 5" TREE
SIDEWALK EASEMENT
EX.SAN.MH
TOP 948.49
IN 937.42
ADJUST TO 948.92
6' WIDE CONC. WALK
SEE SHEET 11
SEE SHEET 9
20+00
STA: 3+18.95=
STA: 20+37.10
CB 1
CB 2
CB 3
CB 4
PC = 21+11.19
PT = 3+50.83
CLEAR AND GRUB 3 TREES
PED RAMP
6"-11¼° BEND
MH 1
CONSTRUCT 110' X 32" RETAINING WALL
37:1 TAPER
CONSTRUCTION LIMITS
APRON 944.30
23+12
APRON 945.30
23+34
PROTECT TREES
43'-1"COPPER WATER SERVICE
33'-4"PVC SAN. SERVICE
TRANSPLANT 2 PINES SEE OWNER FOR LOCATION
REMOVE EX. DRWY. CONSTRUCT NEW BIT. DRIVEWAY AND TURNAROUND
CORE DRILL TO CONNECT TO EXISTING MANHOLE
Δ = 15°29'16"
R = 598.68'
T = 81.41'
L = 161.83'
PC = 24+39.08
PT = 26+00.91
ELK HILLS DRIVE
ELK HILLS
DEERFIELD 3RD ADD.
HEDGE
WOODED
GARAGE
HOUSE

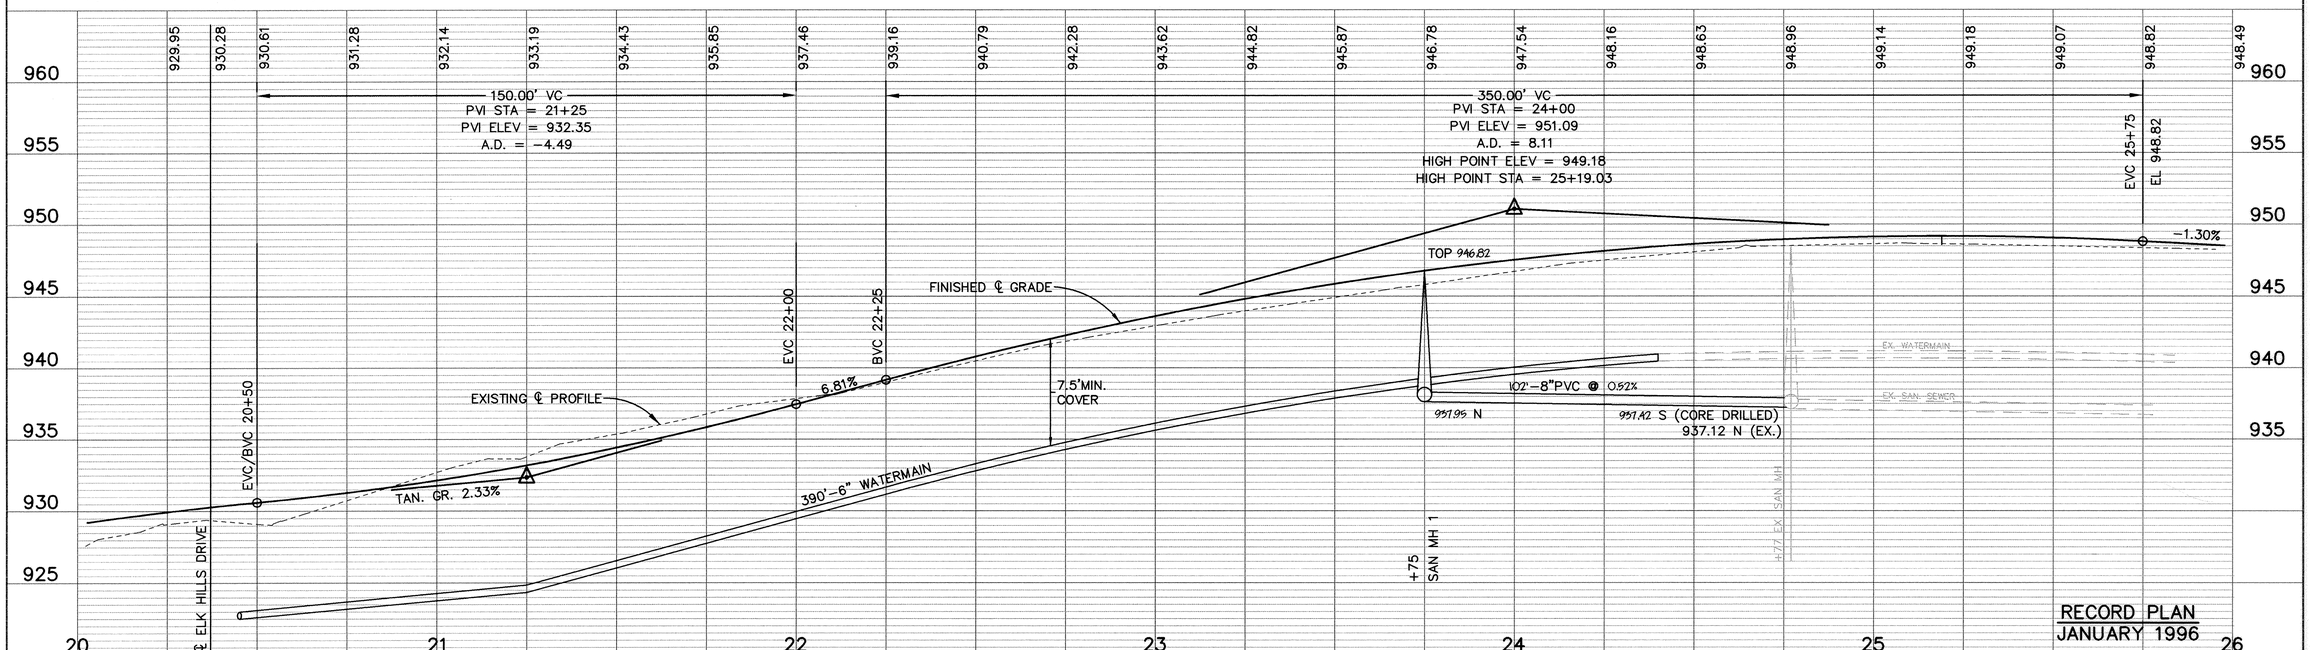

RECORD PLAN
JANUARY 1996

I HEREBY CERTIFY THAT THIS PLAN, SPECIFICATION, OR REPORT WAS PREPARED BY ME OR UNDER MY DIRECT SUPERVISION AND THAT I AM A DULY REGISTERED PROFESSIONAL ENGINEER UNDER THE LAWS OF THE STATE OF MINNESOTA.
DATE 7/31/95 REG.NO. 24082

MSA CONSULTING ENGINEERS

1326 ENERGY PARK DRIVE
ST. PAUL, MINNESOTA 55108
(612) 644-4389

5075 WAYZATA BLVD. SUITE #225
MINNEAPOLIS, MINNESOTA 55416
(612) 546-0432

REVISIONS	DATE	DESCRIPTION

DESIGNED JL
CHECKED
DRAWN JL
GRAPHIC SCALE 0 20 0 VERT. 5

CITY OF ELK RIVER
DODGE STREET/ELK HILLS DRIVE IMPROVEMENTS
DODGE STREET
PLAN AND PROFILE
20+50 TO 25+75

DATE JULY 1995 | SHEET 10 OF 22 SHEETS | PROJECT NO. 230-246

ER246D-5

881

DRAWING NUMBER
ELKHI 95
10

Fri Jan 19 16:13:57 1996