

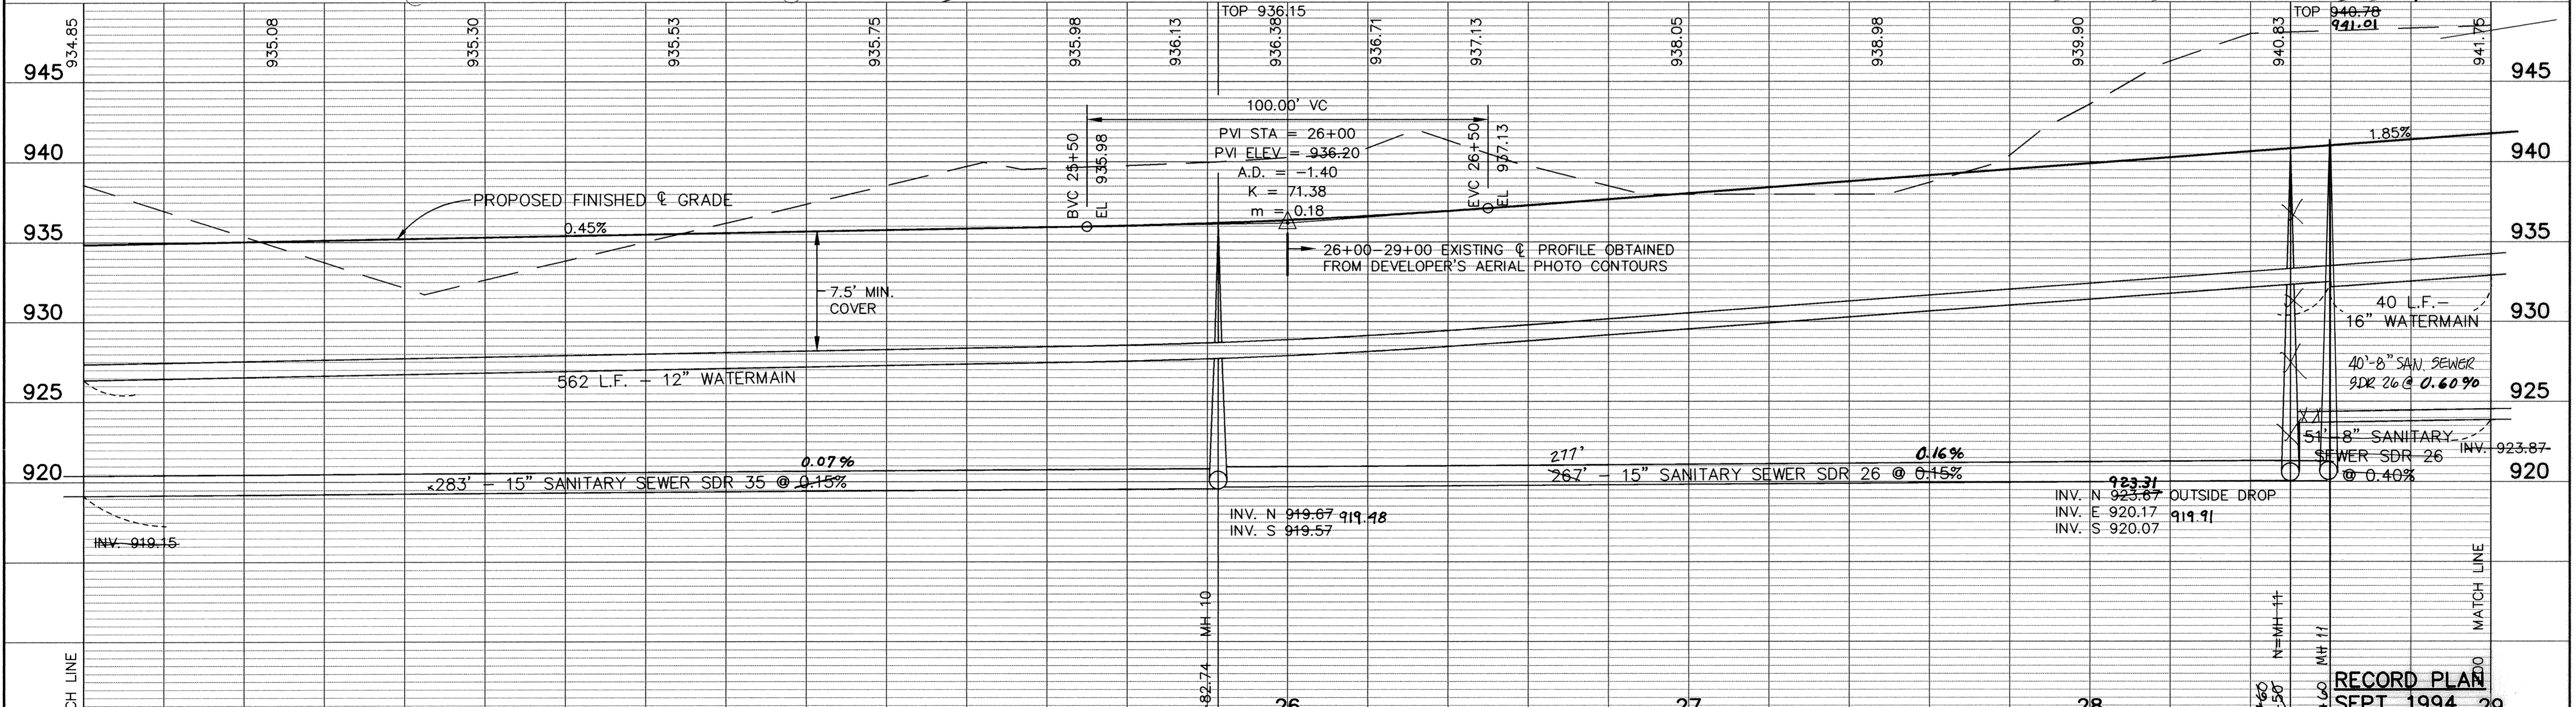


FUTURE FREEPORT AVENUE

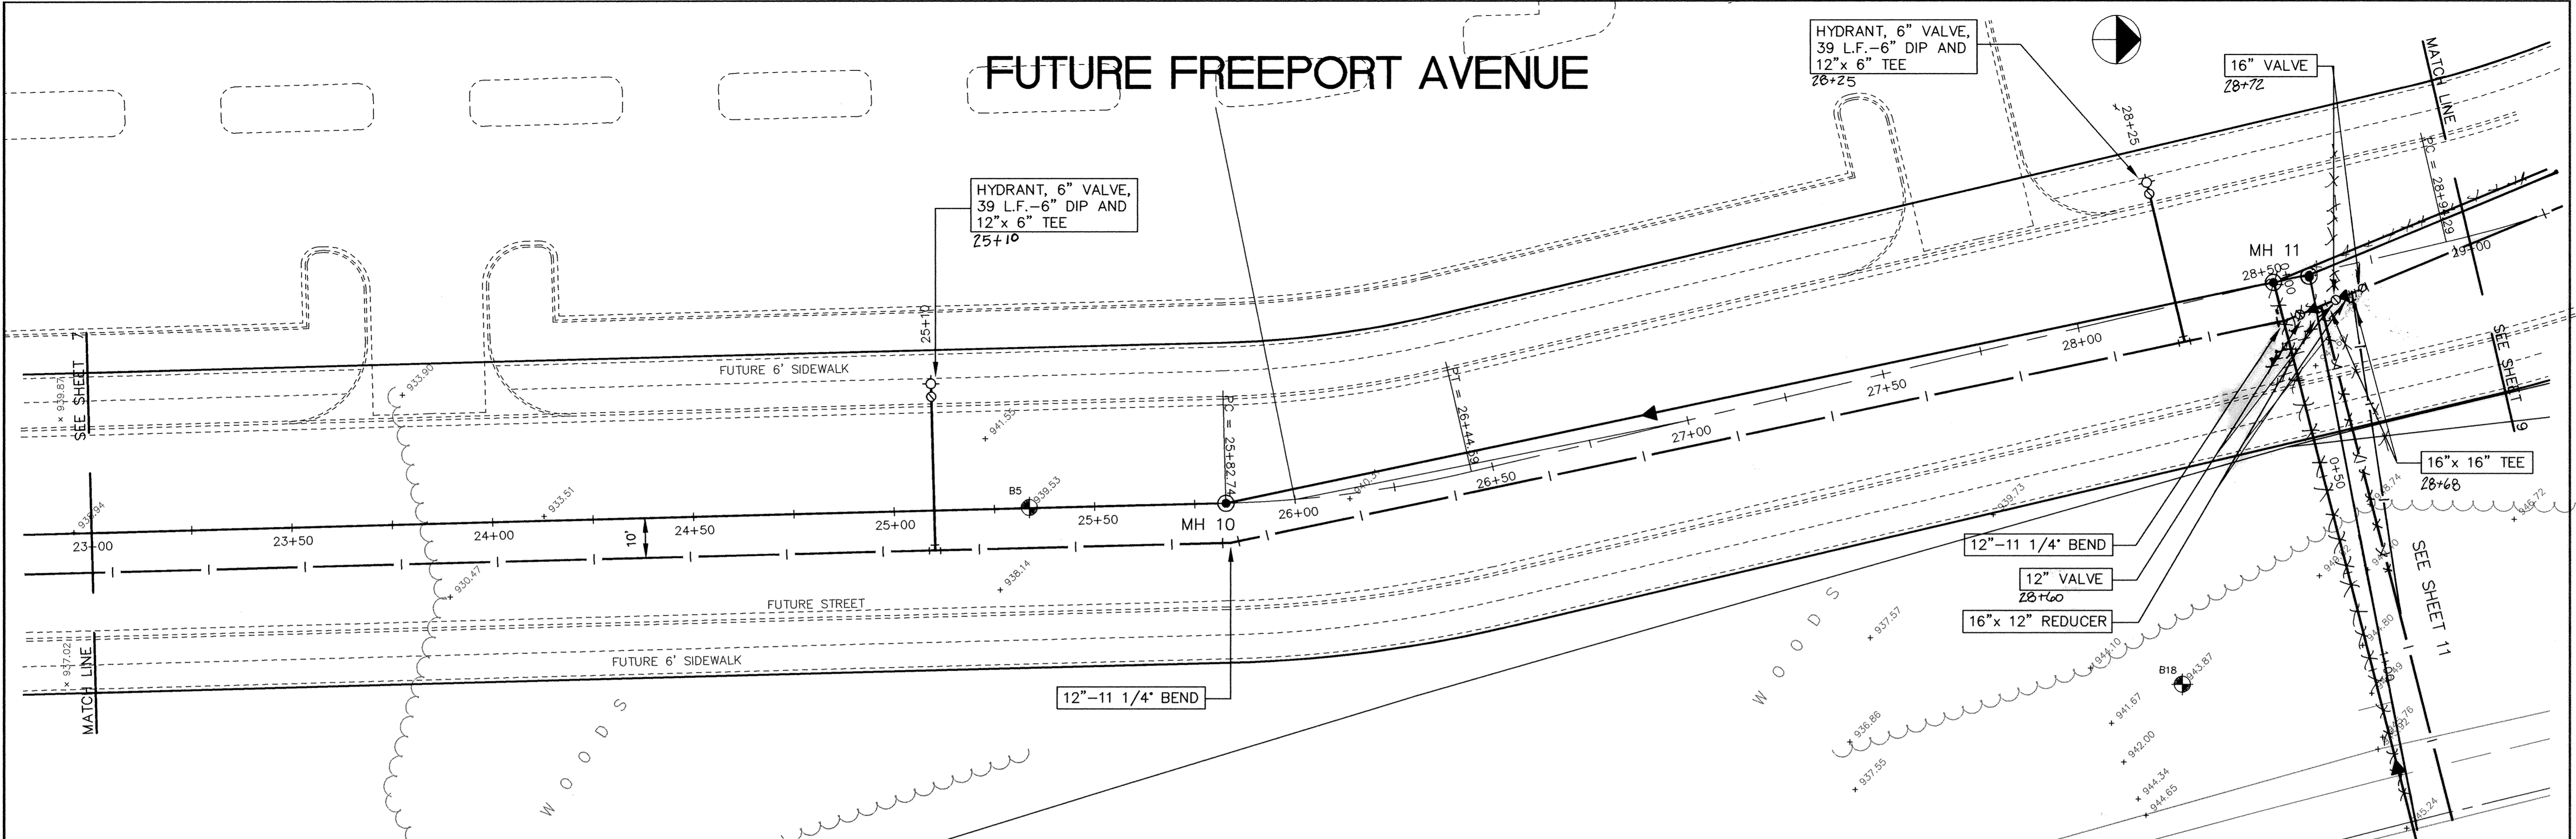

I HEREBY CERTIFY THAT THIS PLAN, SPECIFICATION, OR REPORT WAS PREPARED BY ME OR UNDER MY DIRECT SUPERVISION AND THAT I AM A DULY REGISTERED PROFESSIONAL ENGINEER UNDER THE LAWS OF THE STATE OF MINNESOTA.

Paul Foettchen
 DATE 6-20-94 REG. NO. 13929

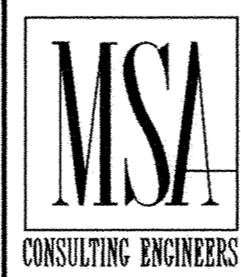

1326 ENERGY PARK DRIVE
 ST. PAUL, MINNESOTA 55108
 (612) 644-4389

9800 SHELARD PARKWAY
 MINNEAPOLIS, MINNESOTA 55441
 (612) 546-0432

DATE	DESCRIPTION	DESIGNED	PER
6/17/94	FREEPORT AVE. GRADE	CHECKED	SDG
		DRAWN	CLS

GRAPHIC SCALE
 0 HORIZ. 20
 0 VERT. 5

CITY OF ELK RIVER		STA.
TRUNK SANITARY AND WATERMAIN-ELK PARK CENTER		23+00 TO 29+00
FUTURE FREEPORT AVENUE		
DATE MARCH 1994	SHEET 8 OF 17 SHEETS	PROJECT NO. 230-215

783 756 856